


PLAN	DATE
PROJECT	
NO. OF SHEETS	
NO. OF SHEETS CHECKED	
NO.	

PROFILE	DATE
PROJECT	
NO. OF SHEETS	
NO. OF SHEETS CHECKED	
NO.	

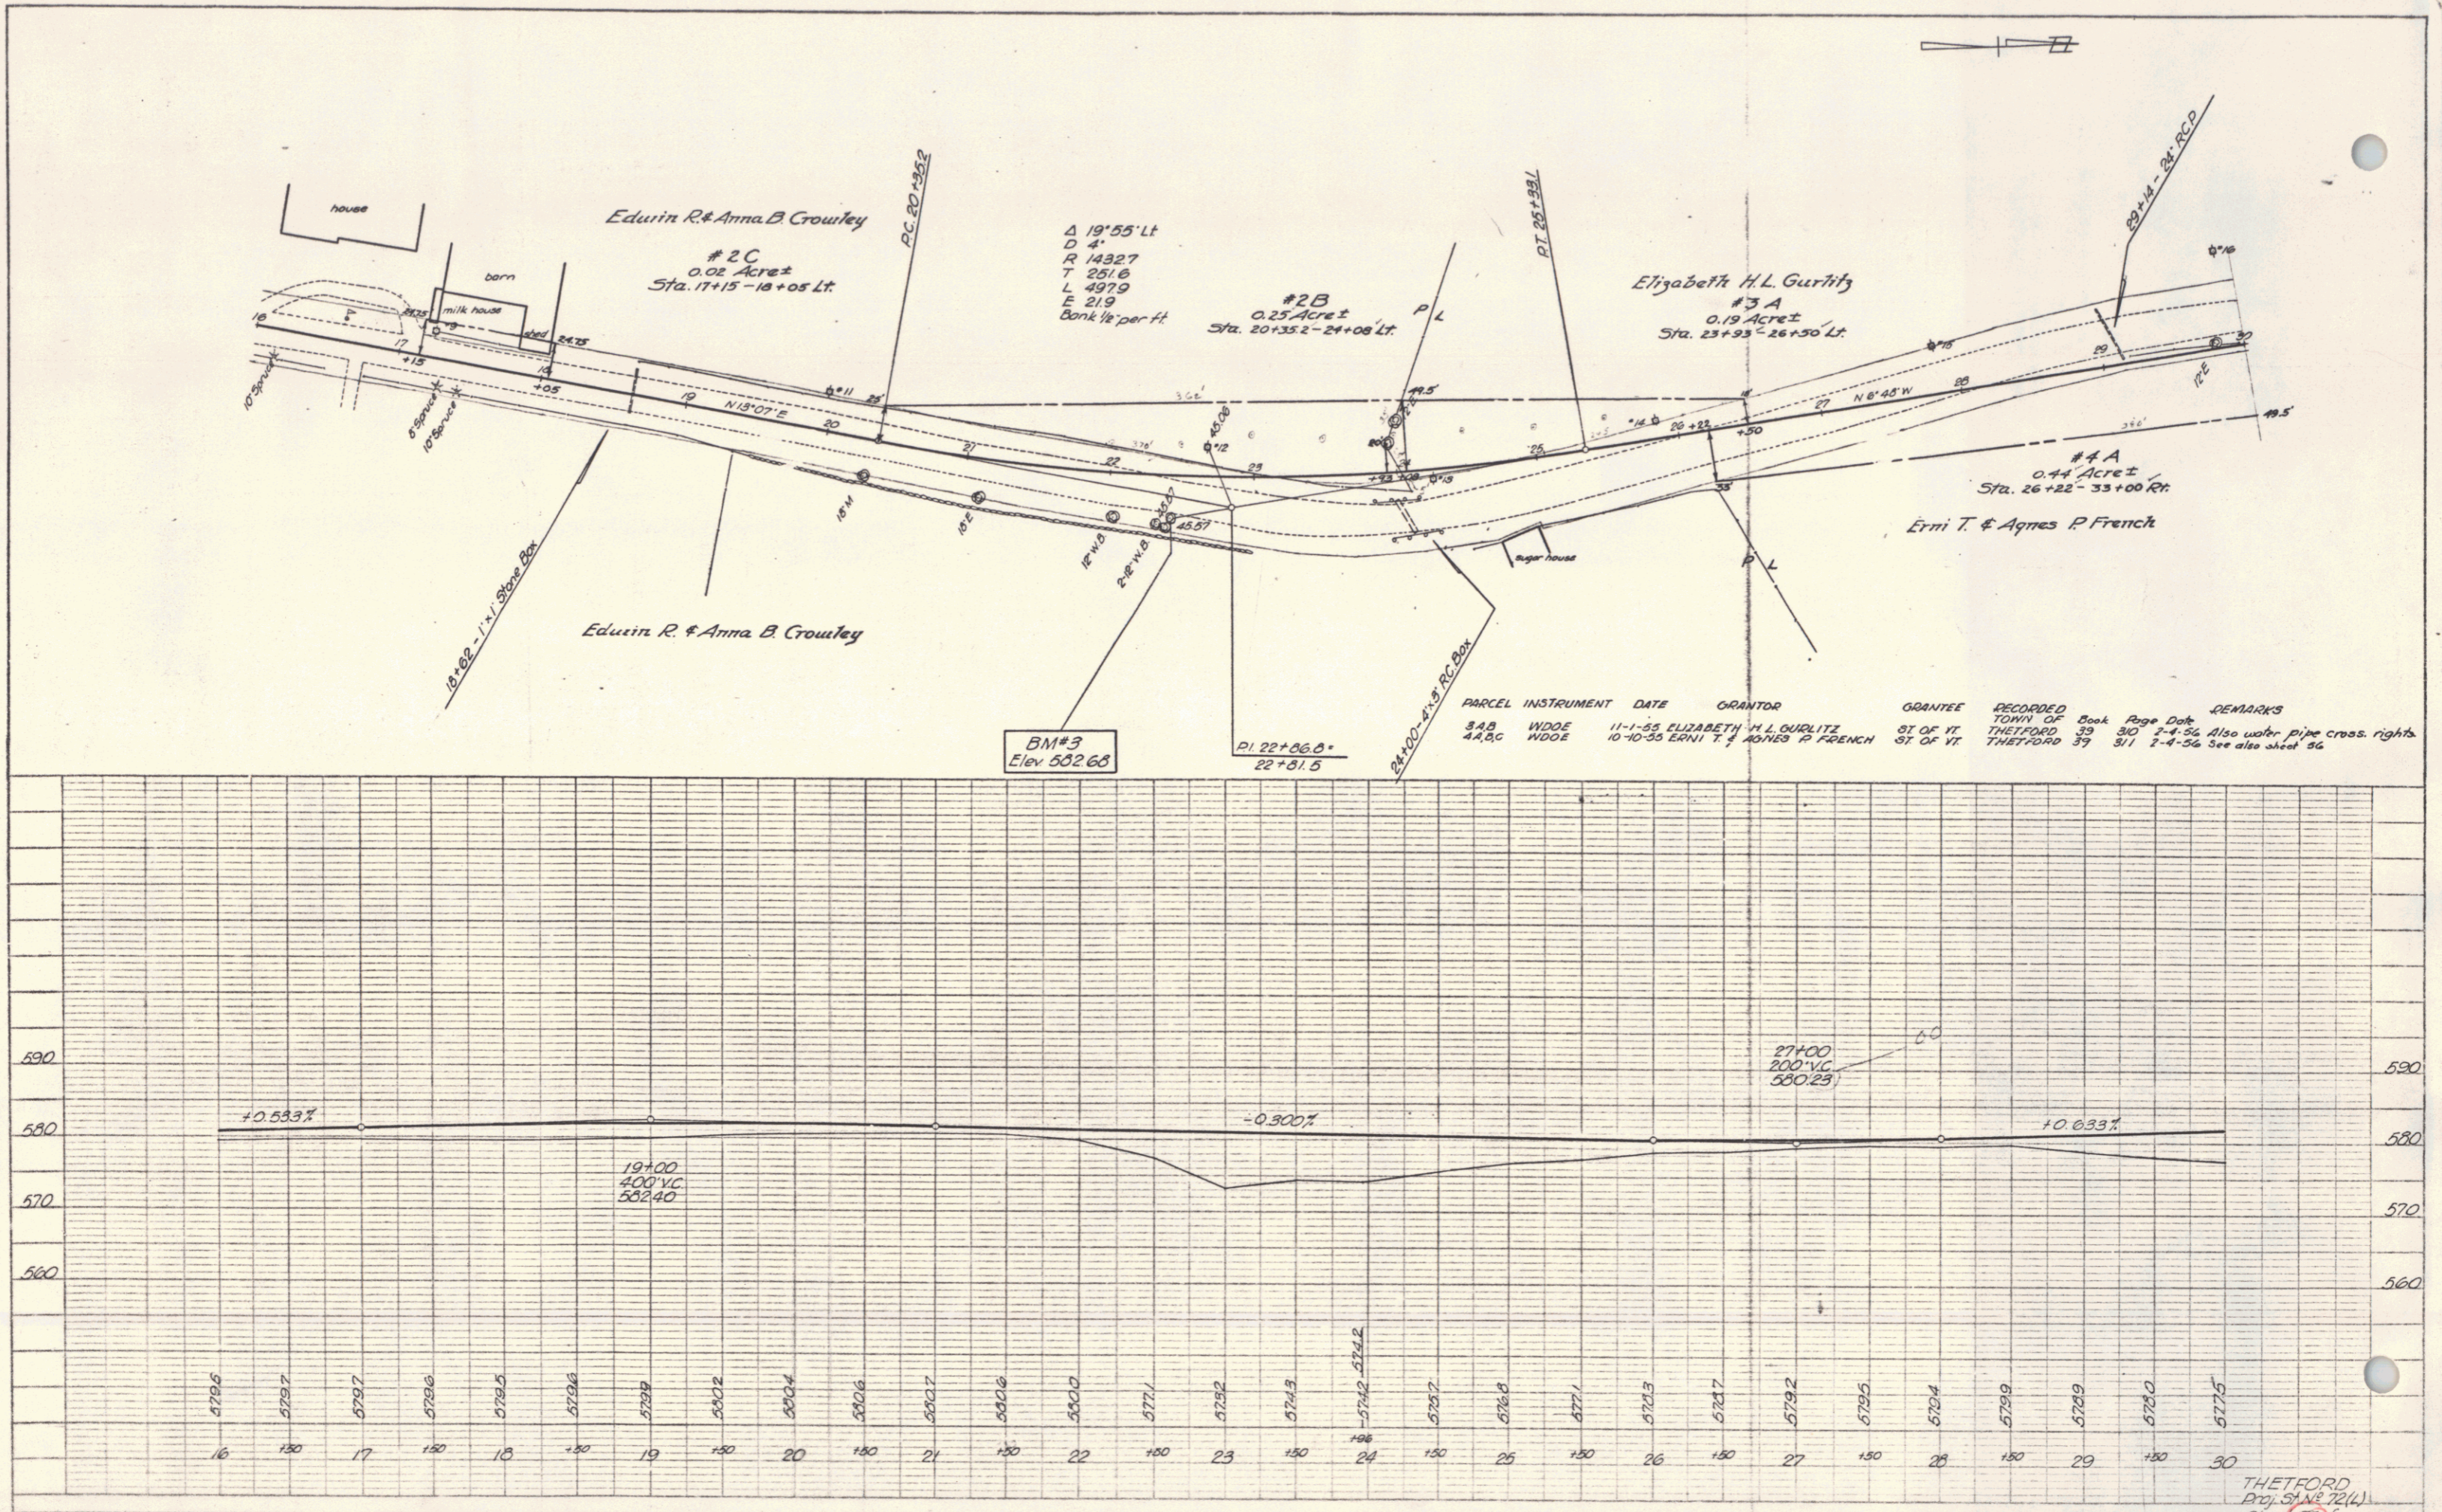

THETFORD  
 Proj. 51 NE 72(4)  
 Sheet 59 of 60