



PARCEL INSTRUMENT DATE GRANTOR GRANTEE RECORDED TOWN OF Book Page Date REMARKS
 5 WDOE 10-10-55 RUSSELL E. & ROSE E. DREW ST OF VT THETFORD 39 311-312 2-4-56

Δ 24°22' Lt
 D 5'
 R 1146.8
 T 247.5
 L 457.8
 E 26.4

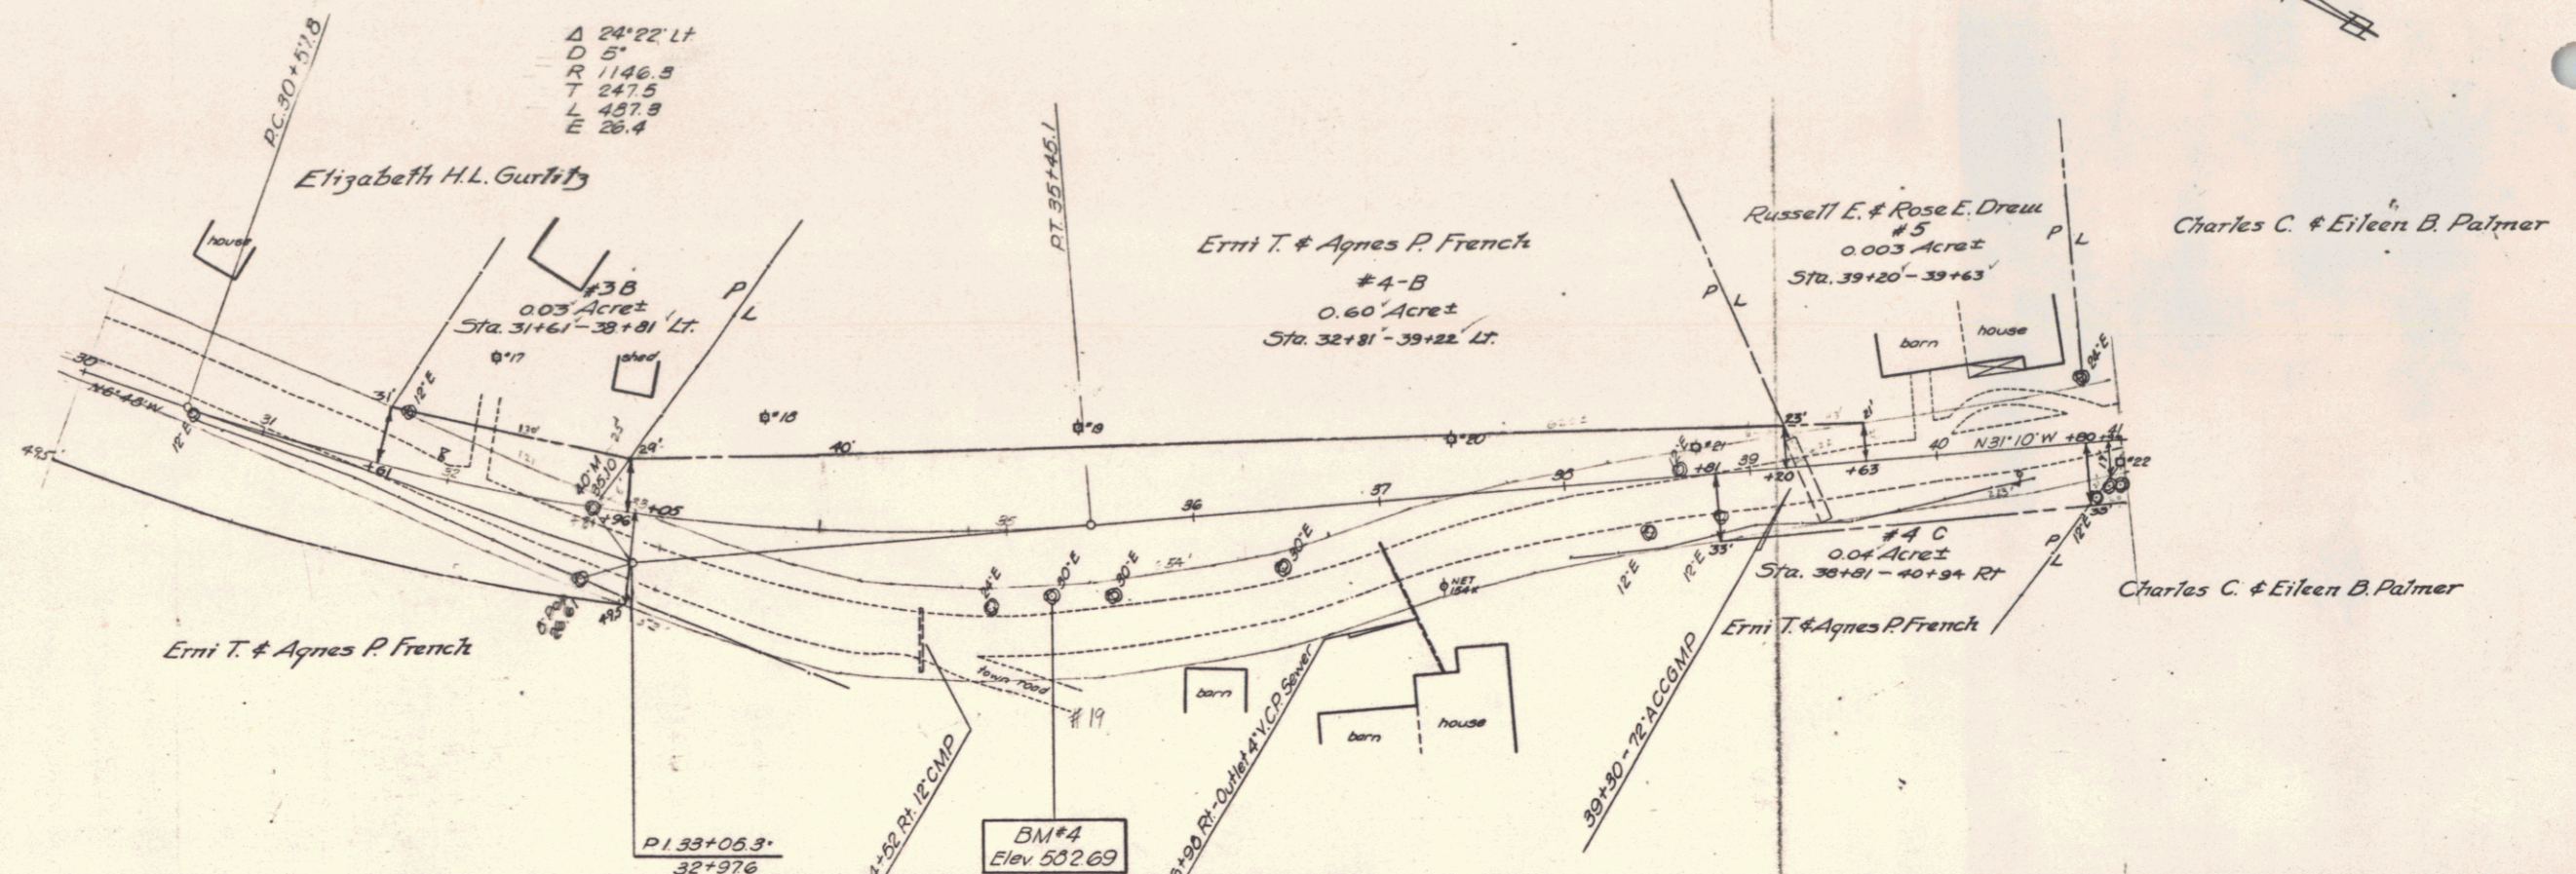

PLAN
 CHECKED BY: [Signature]
 DATE: 10/10/55
 DRAWN BY: [Signature]
 DATE: 10/10/55

PROFILE
 CHECKED BY: [Signature]
 DATE: 10/10/55
 DRAWN BY: [Signature]
 DATE: 10/10/55

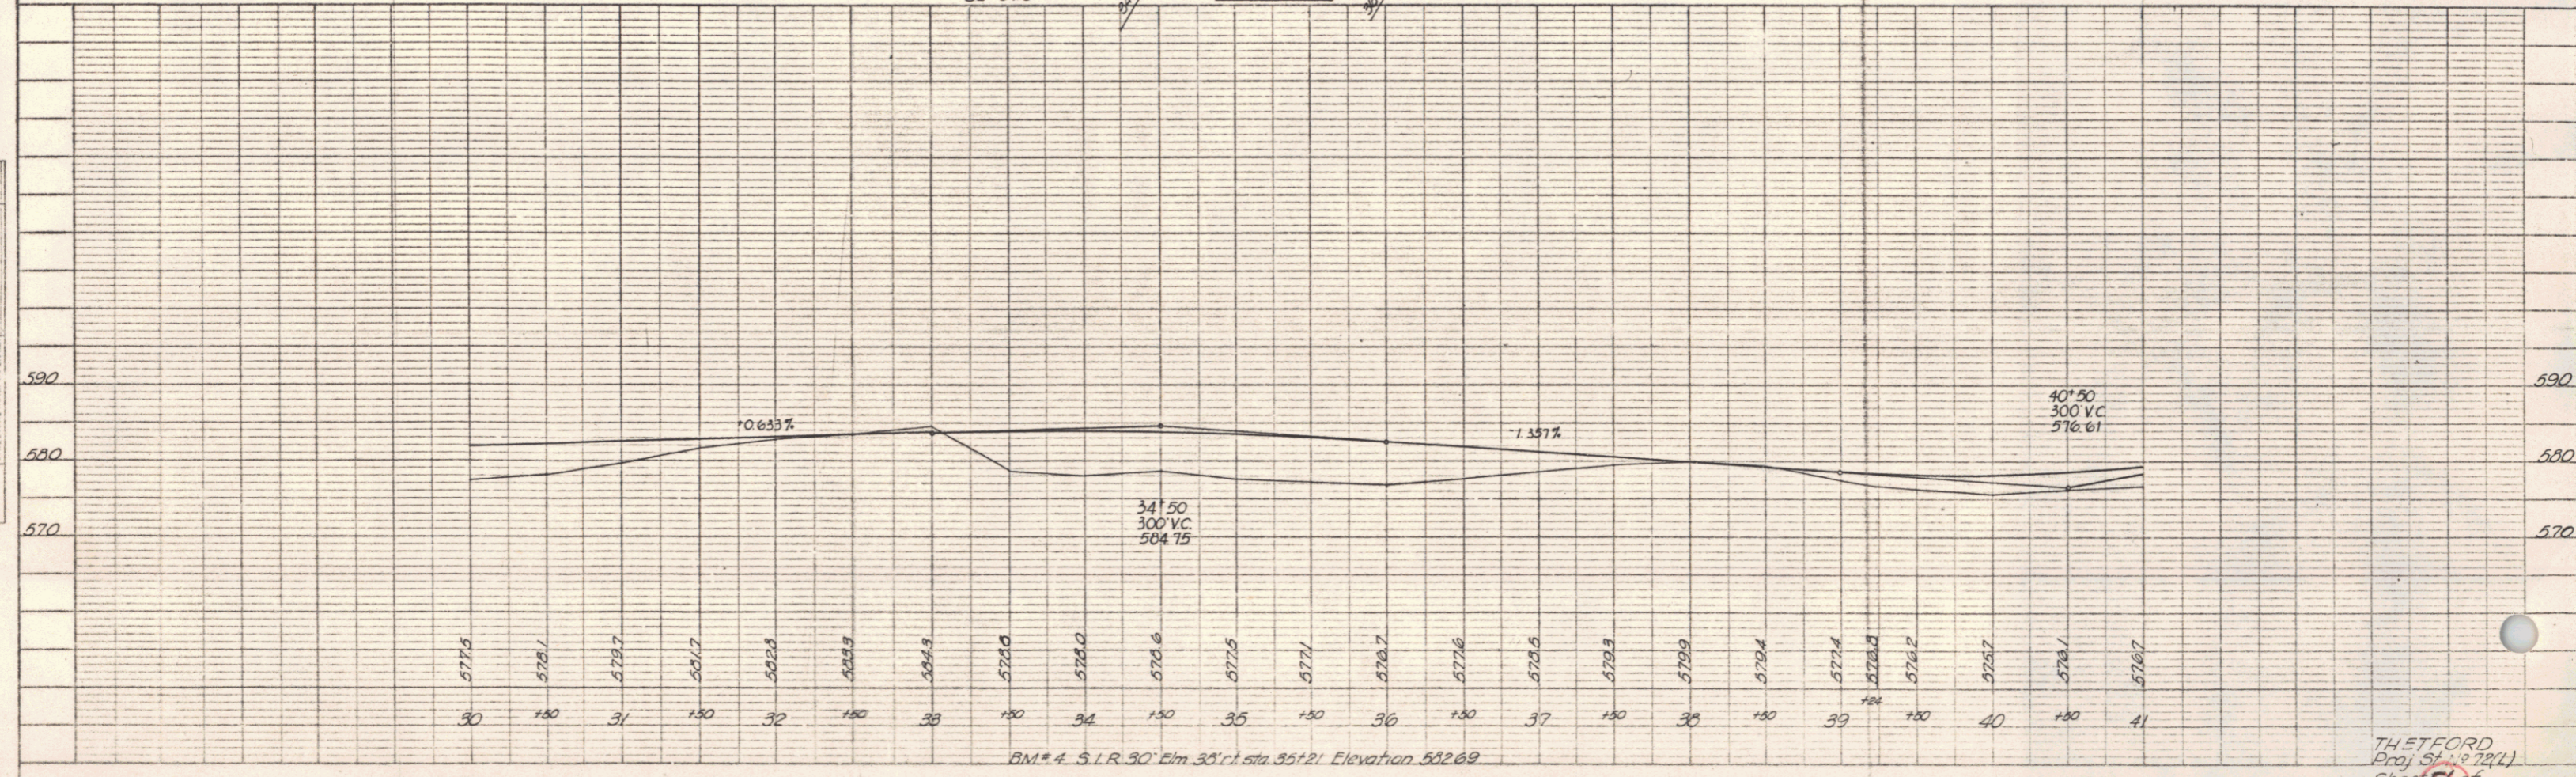

BM#4 S.I.R. 30' Elm 35' r. Sta. 35+21 Elevation 582.69

THETFORD
 Proj. St. 272(1)
 Sheet 56 of 3