
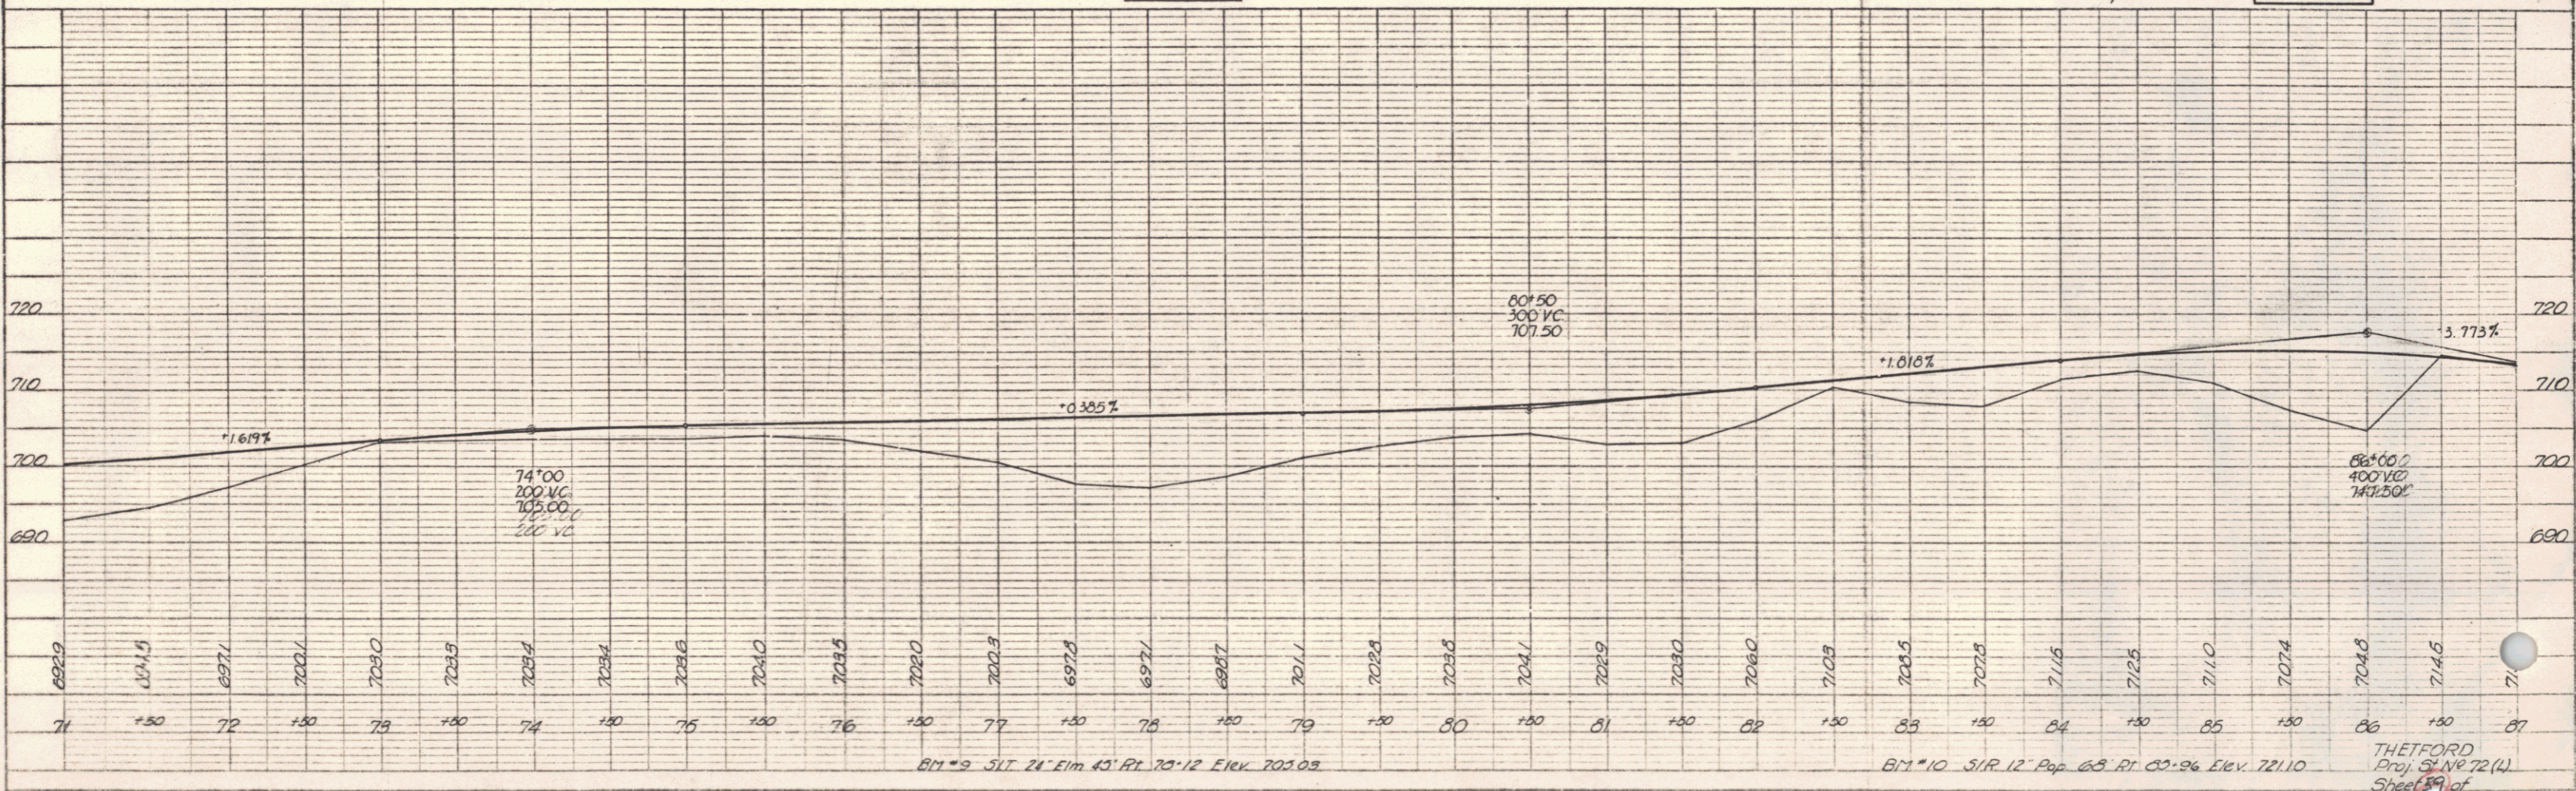


DATE: 9/25/55  
 DRAWN BY: [Signature]  
 CHECKED BY: [Signature]  
 PROJECT: [Signature]  
 SHEET: 7/55

PROFILE  
 DATE: 9/25/55  
 DRAWN BY: [Signature]  
 CHECKED BY: [Signature]  
 PROJECT: [Signature]  
 SHEET: 7/55

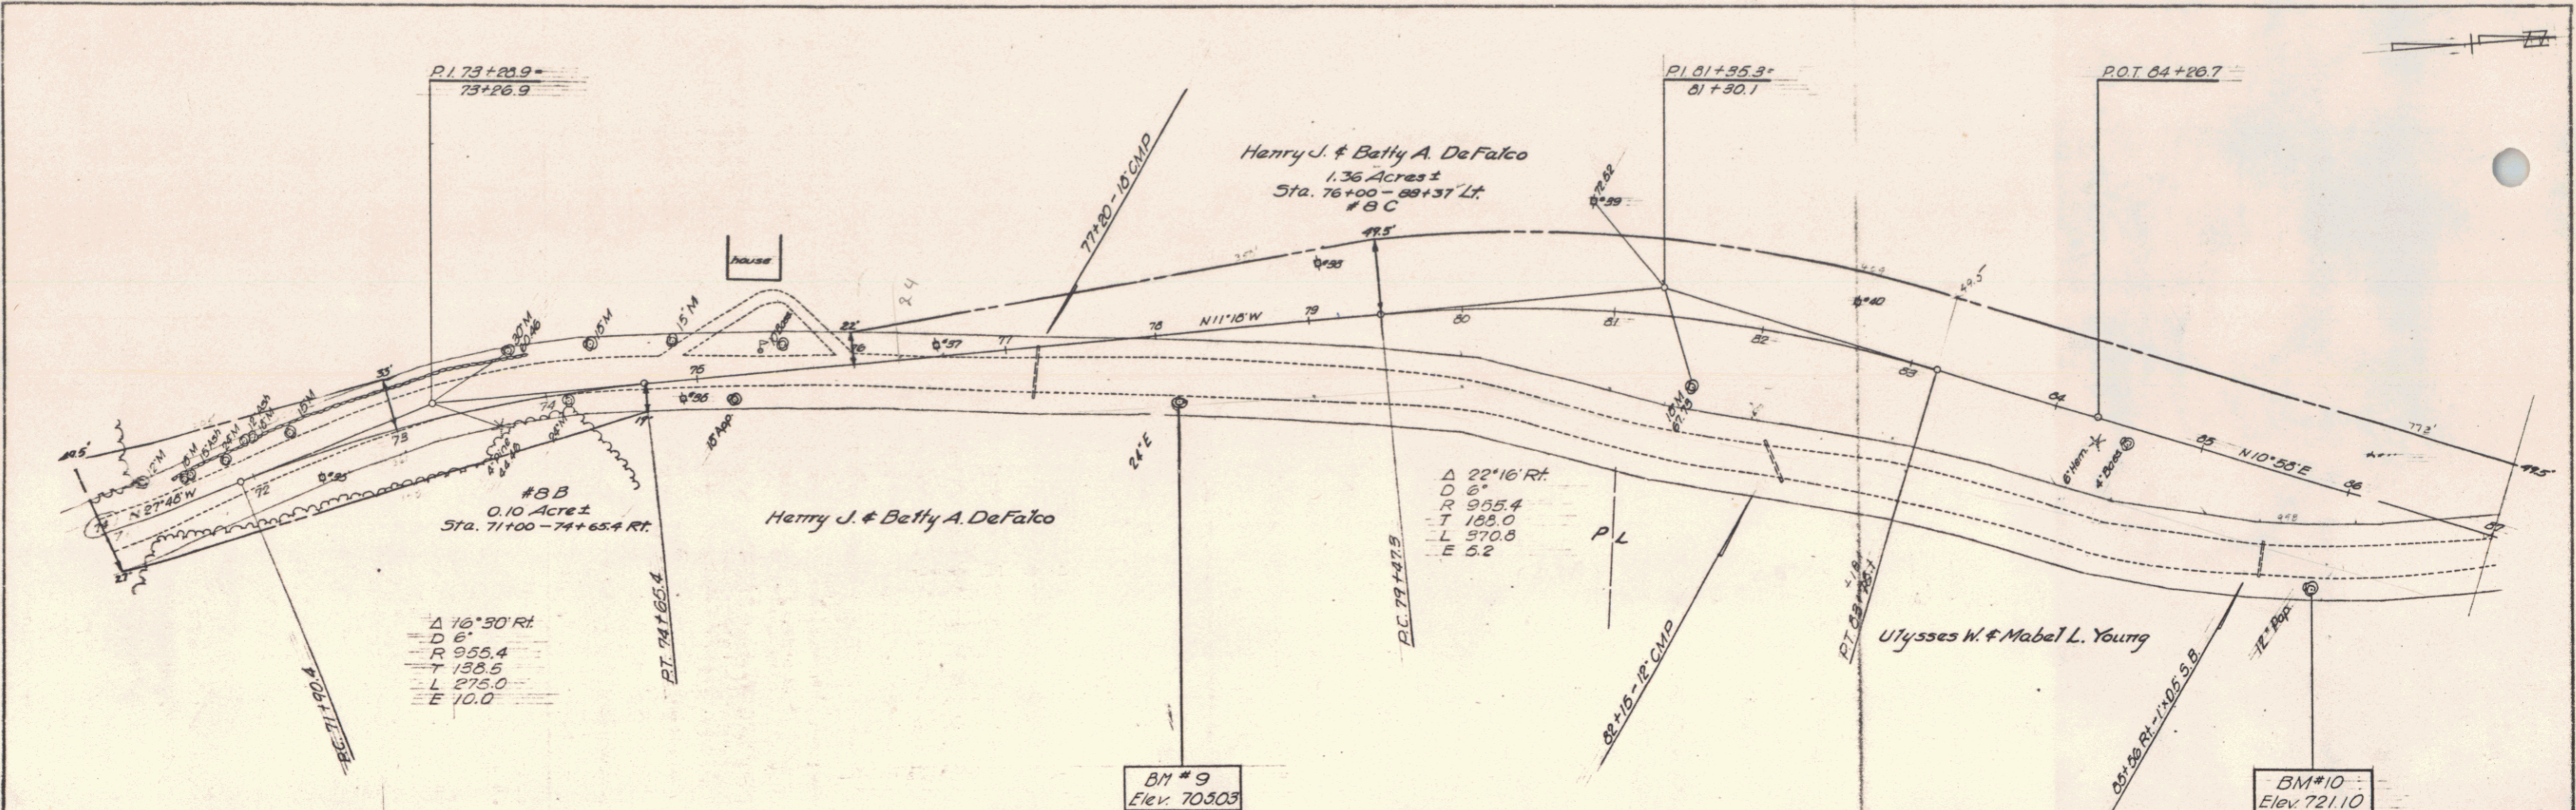

BM #9 S/LT 24' E/14' 45' RT 70°12' Elev. 705.03

BM #10 S/R 12' 12' P/12' 05' 96' Elev. 721.10

THETFORD  
 Proj. 31 NR 72 (4)  
 Sheet 8 of 10

PLATE 1 - PLAN-PROFILE - 8 1/2 x 11 - 1/2 INCHES

6