



DATE: 9/25/55
 DRAWN BY: R. A. ...
 CHECKED BY: H. ...

DATE: 9/25/55
 DRAWN BY: R. A. ...
 CHECKED BY: H. ...

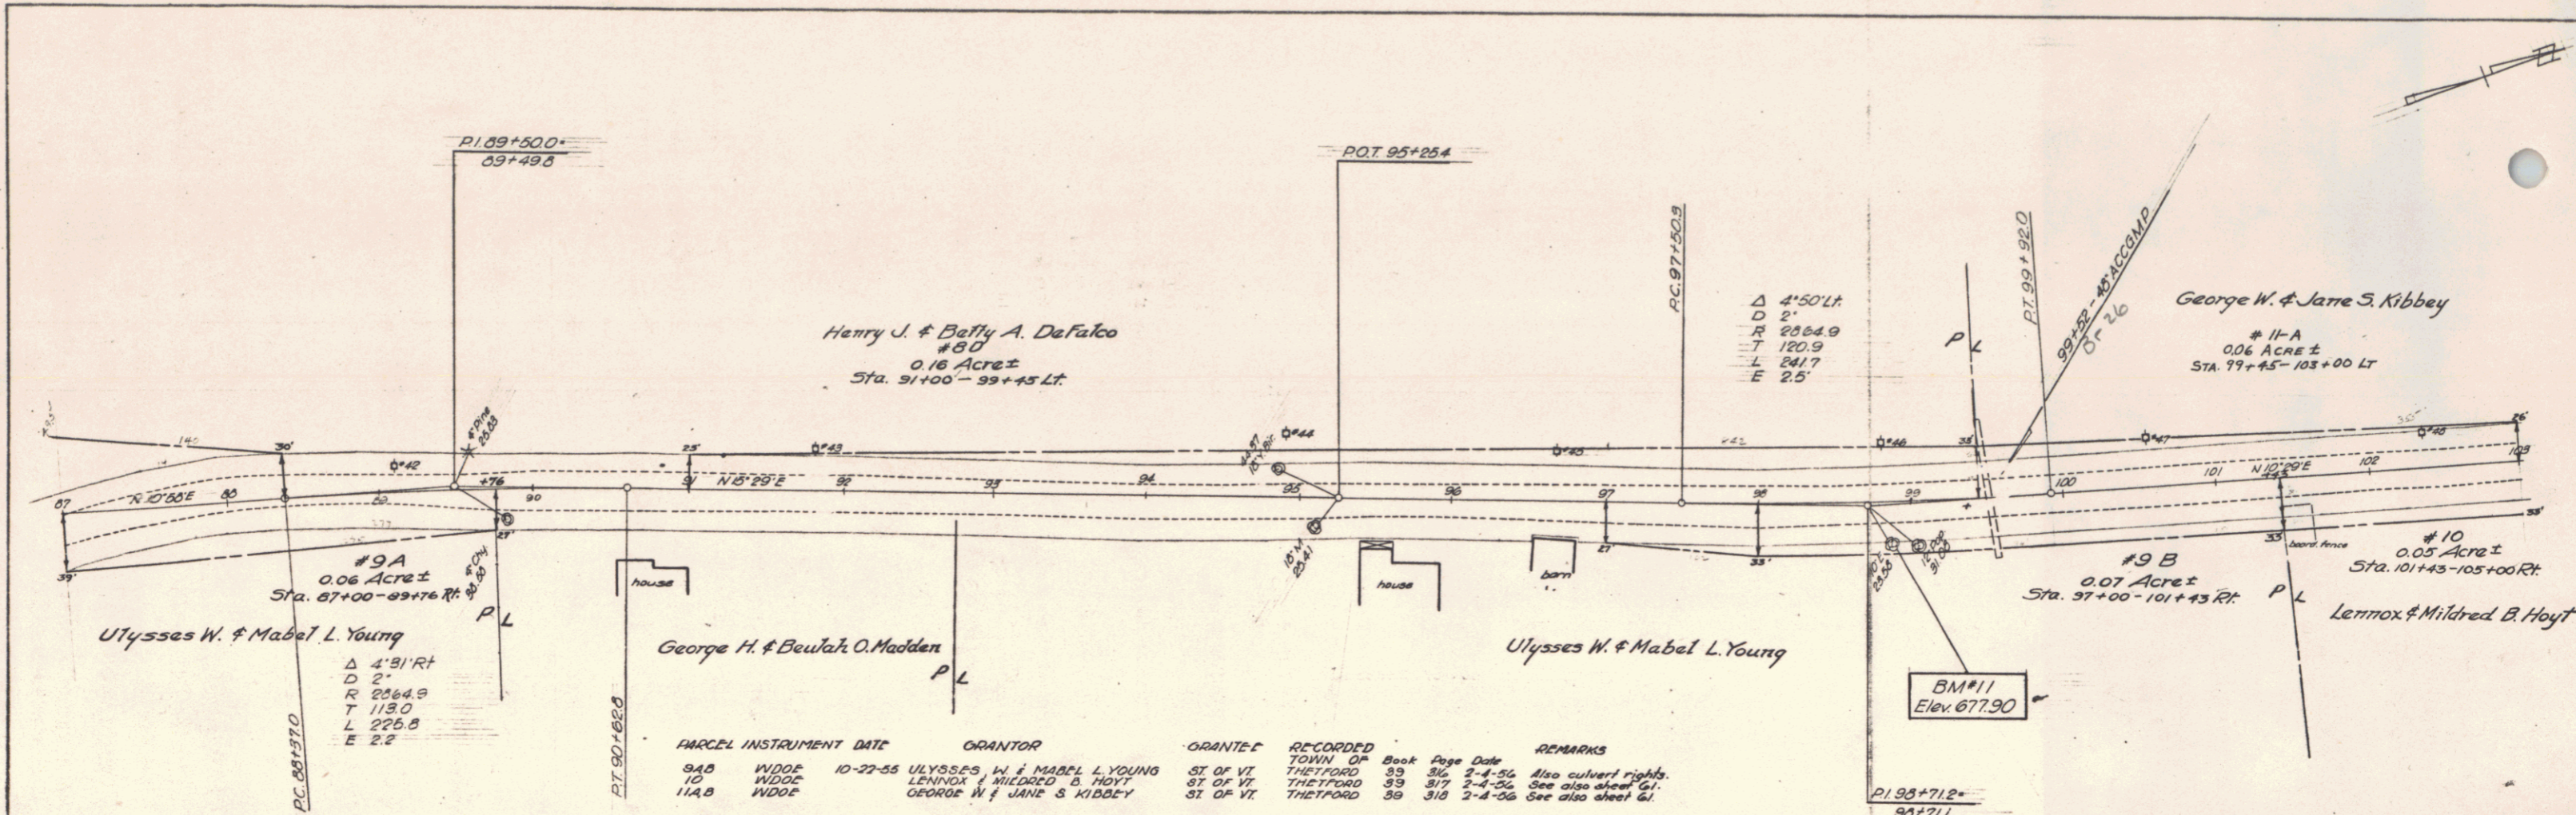

PARCEL	INSTRUMENT	DATE	GRANTOR	GRANTEE	RECORDED	TOWN	OR	BOOK	PAGE	DATE	REMARKS
94B	WDDF	10-22-55	ULYSSES, W. & MABEL L. YOUNG	ST OF VT	THETFORD	39	36	2-4-56			Also culvert rights.
10	WDDF		LENNOX & MILDRED B. HOYT	ST OF VT	THETFORD	39	37	2-4-56			See also sheet 61.
11A	WDDF		GEORGE W. & JANE S. KIBBEY	ST OF VT	THETFORD	39	318	2-4-56			See also sheet 61.

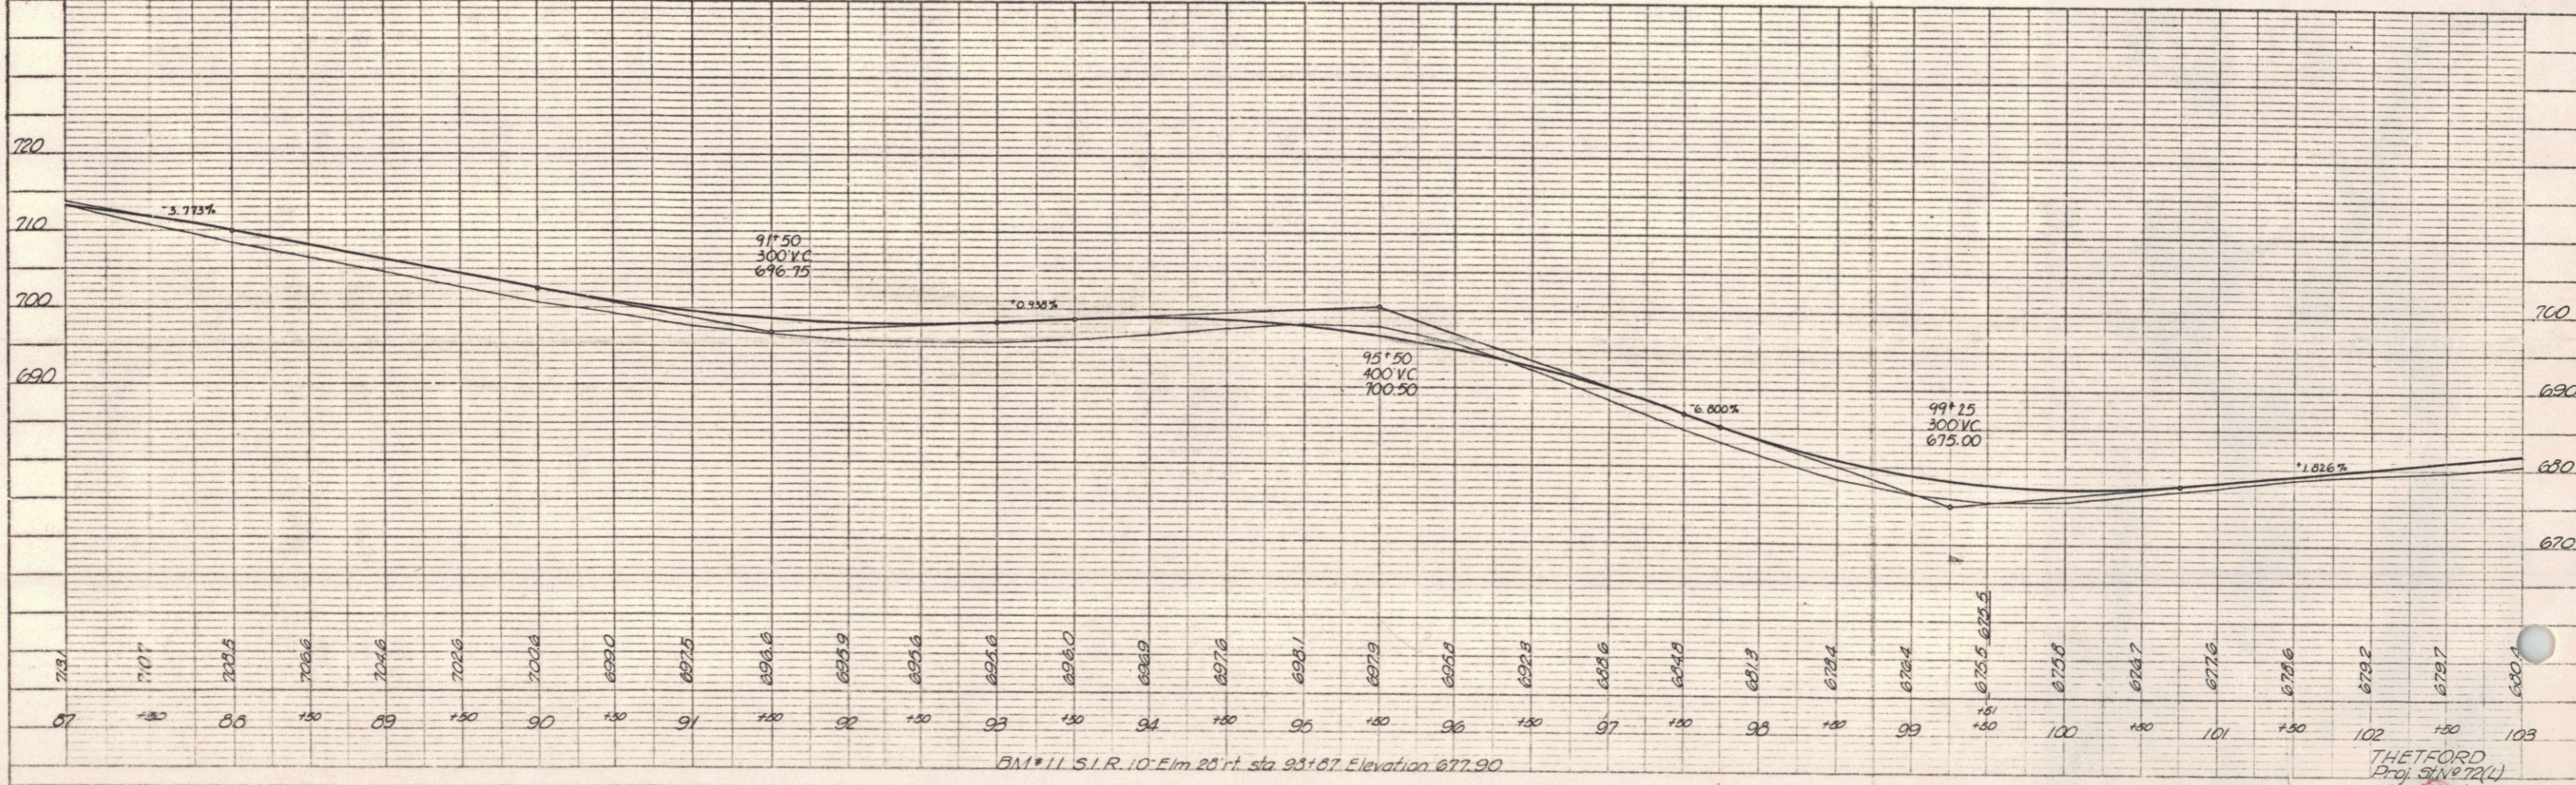

BM #11 S.I.R. 10' Elm 25' ft. sta 93+67. Elevation 677.90

THETFORD
 Proj. 314.072(1)
 Sheet 600