
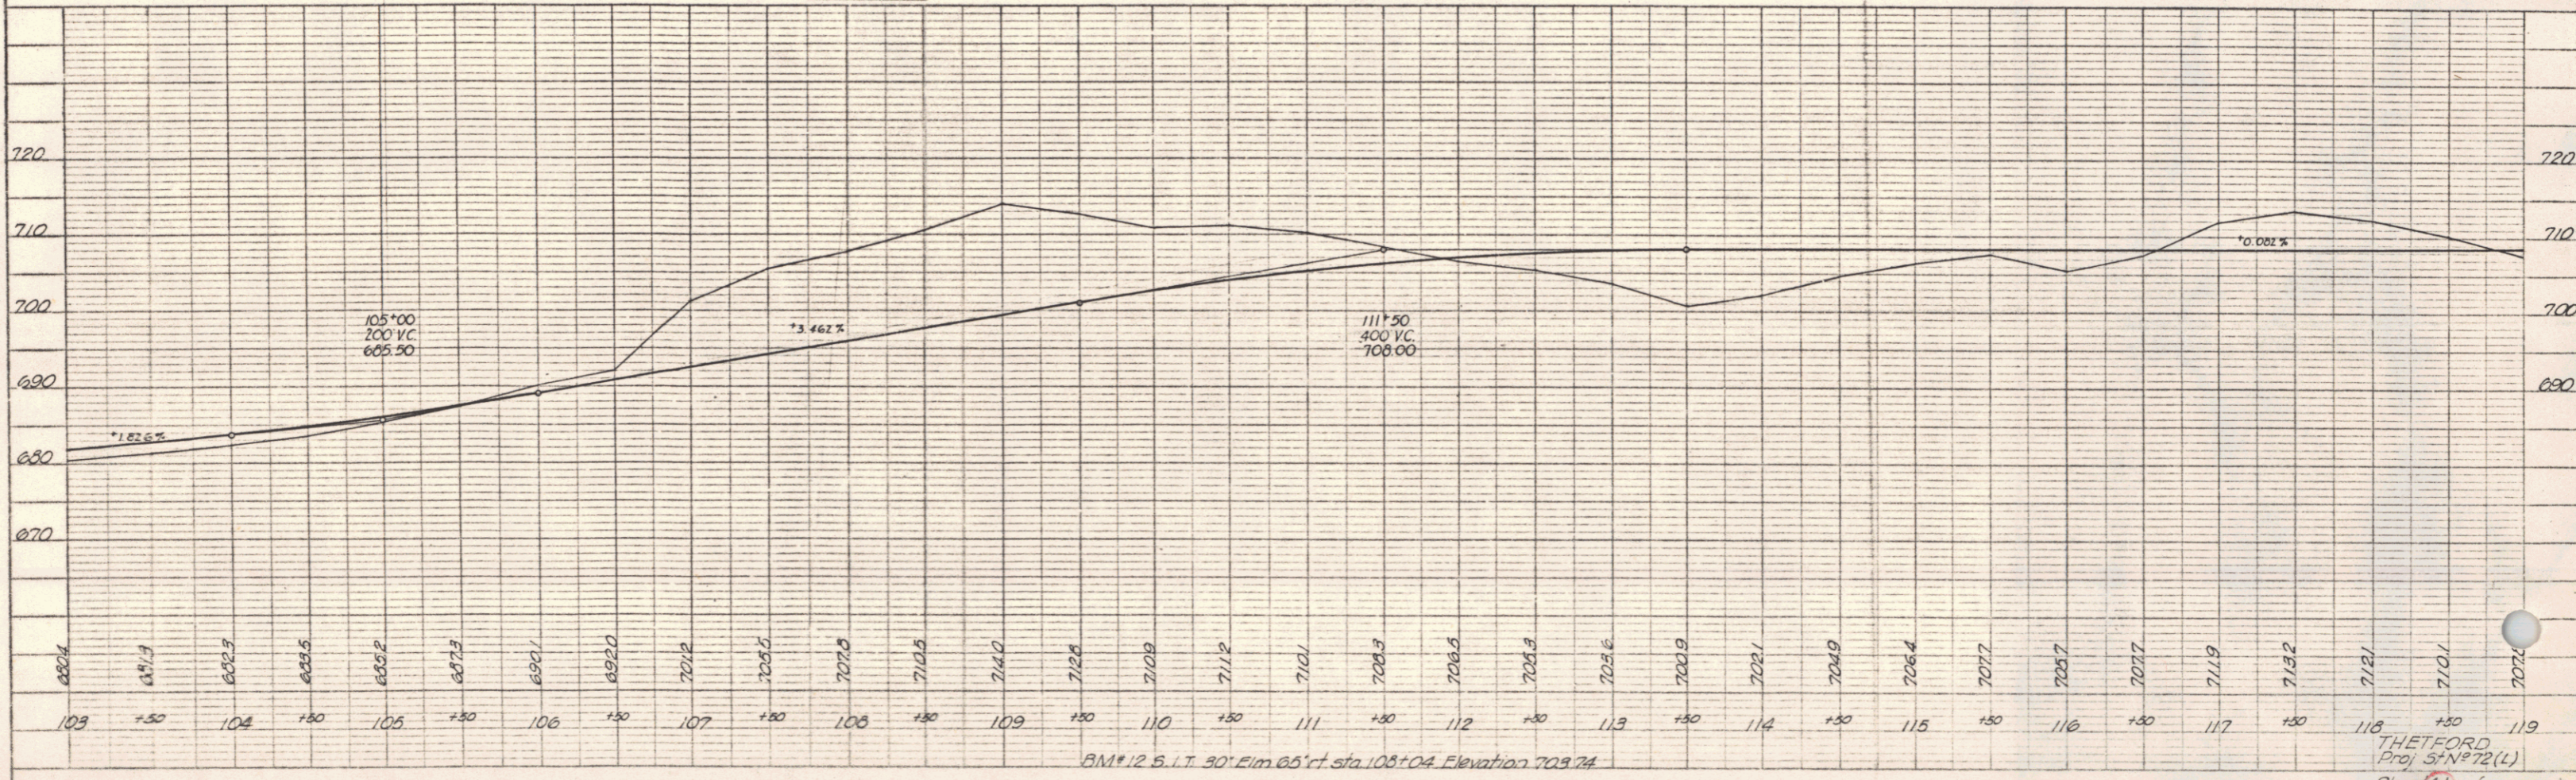


PLAN
 DRAWN BY: *W. J. ...*
 DATE: 7/53
 CHECKED BY: *...*
 DATE: *...*

PROFILE
 DRAWN BY: *...*
 DATE: *...*
 CHECKED BY: *...*
 DATE: *...*

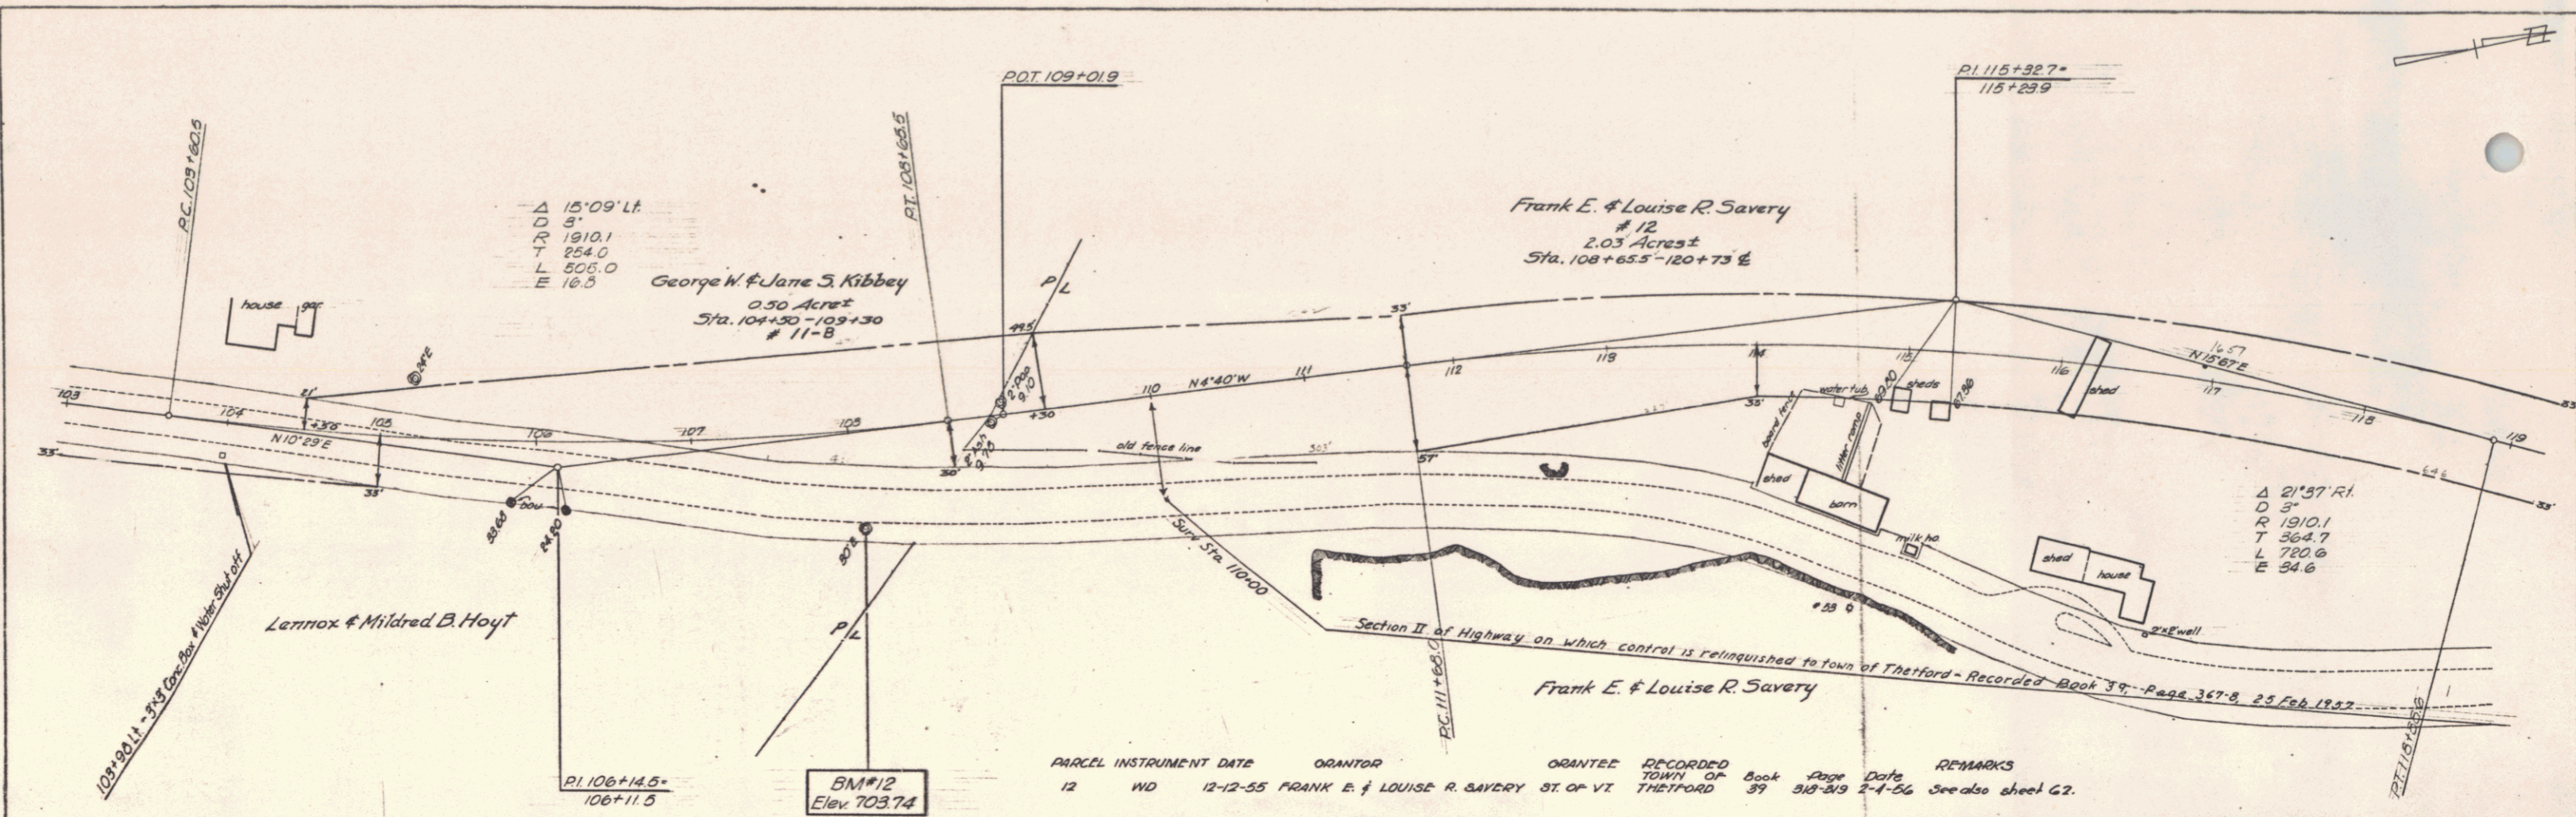

THETFORD
 Proj 51N72(L)
 Sheet 61 of 8