
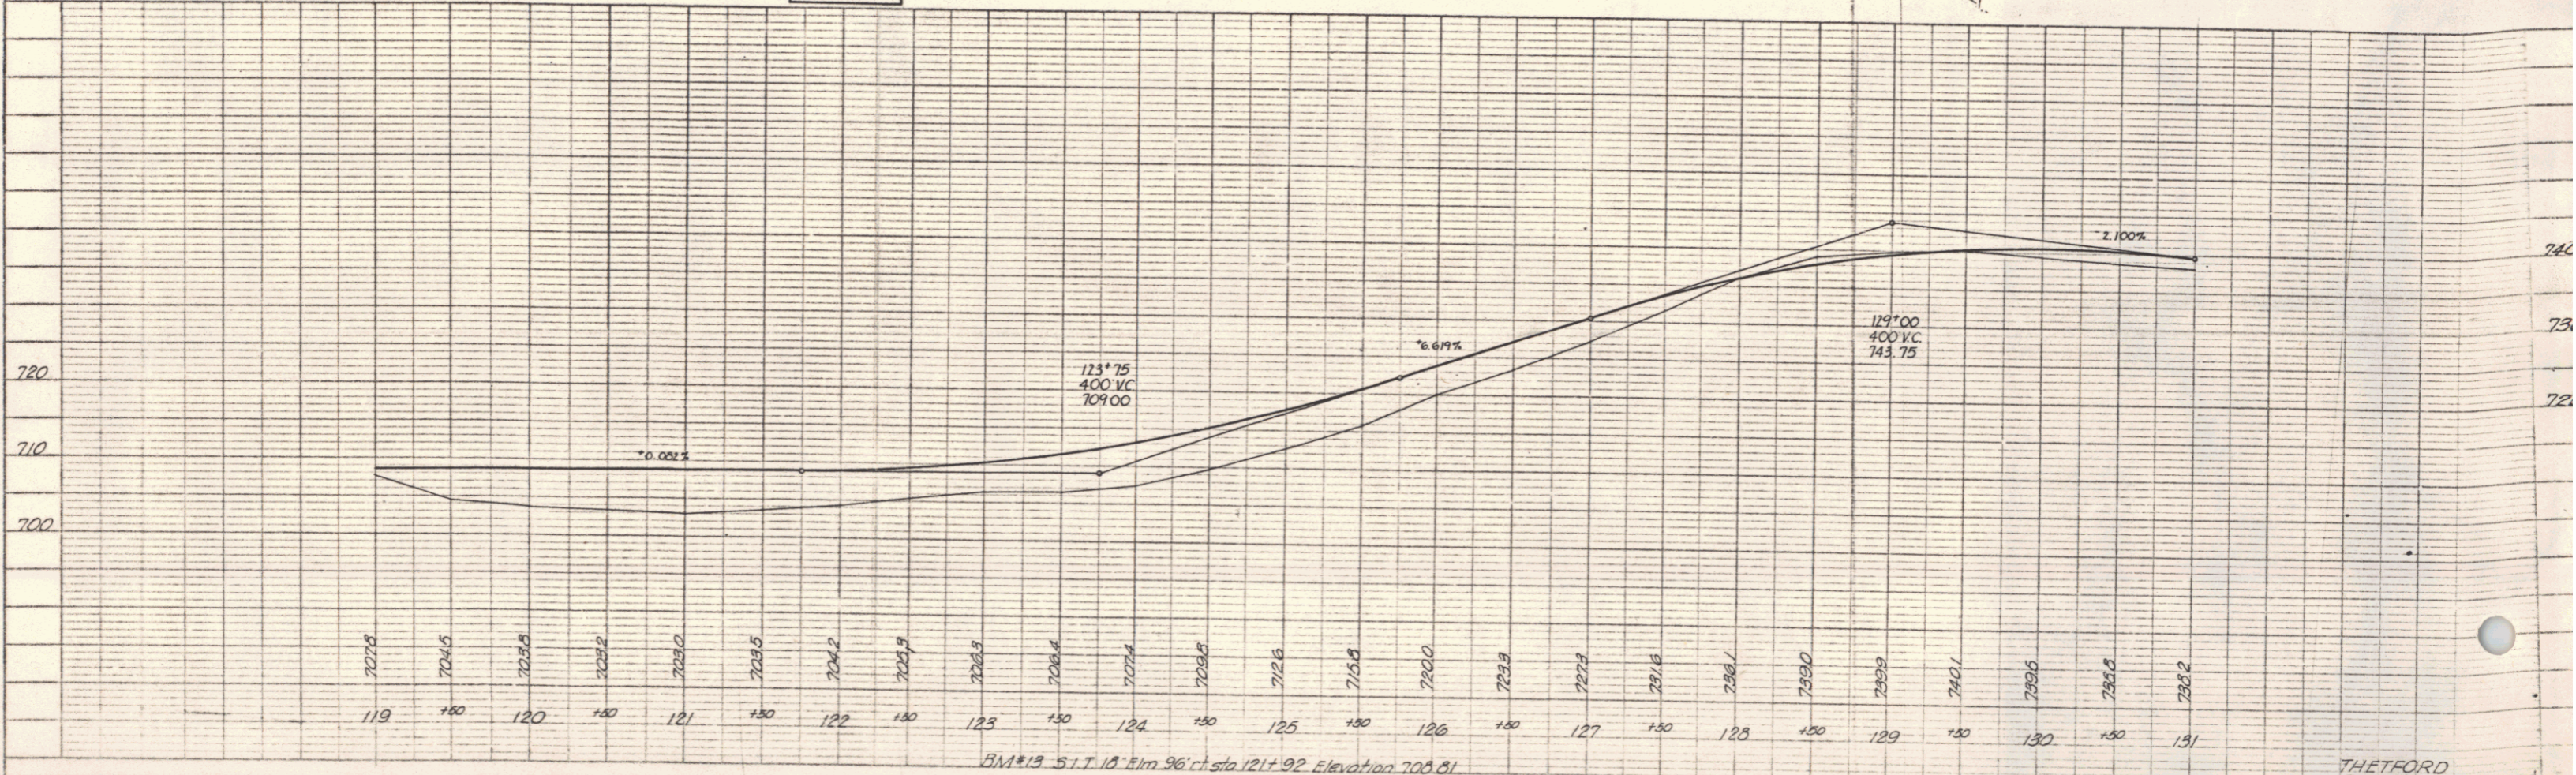


PARCEL INSTRUMENT DATE GRANTOR GRANTEE RECORDED TO WHOM OF Book Page Date REMARKS
 13.A.B.C Cond 3-30-38 FLORENCE R. MILLER ST OF VT THETFORD 39 202-286 10-1-55 See also sheets 63,64 & 65

PLAN
 DATE 9/25/55
 DRAWN BY A. H. H. H. H.
 CHECKED BY H. H. H. H. H.
 NO. 12

PROFILE
 DATE 9/25/55
 DRAWN BY A. H. H. H. H.
 CHECKED BY H. H. H. H. H.
 NO. 12

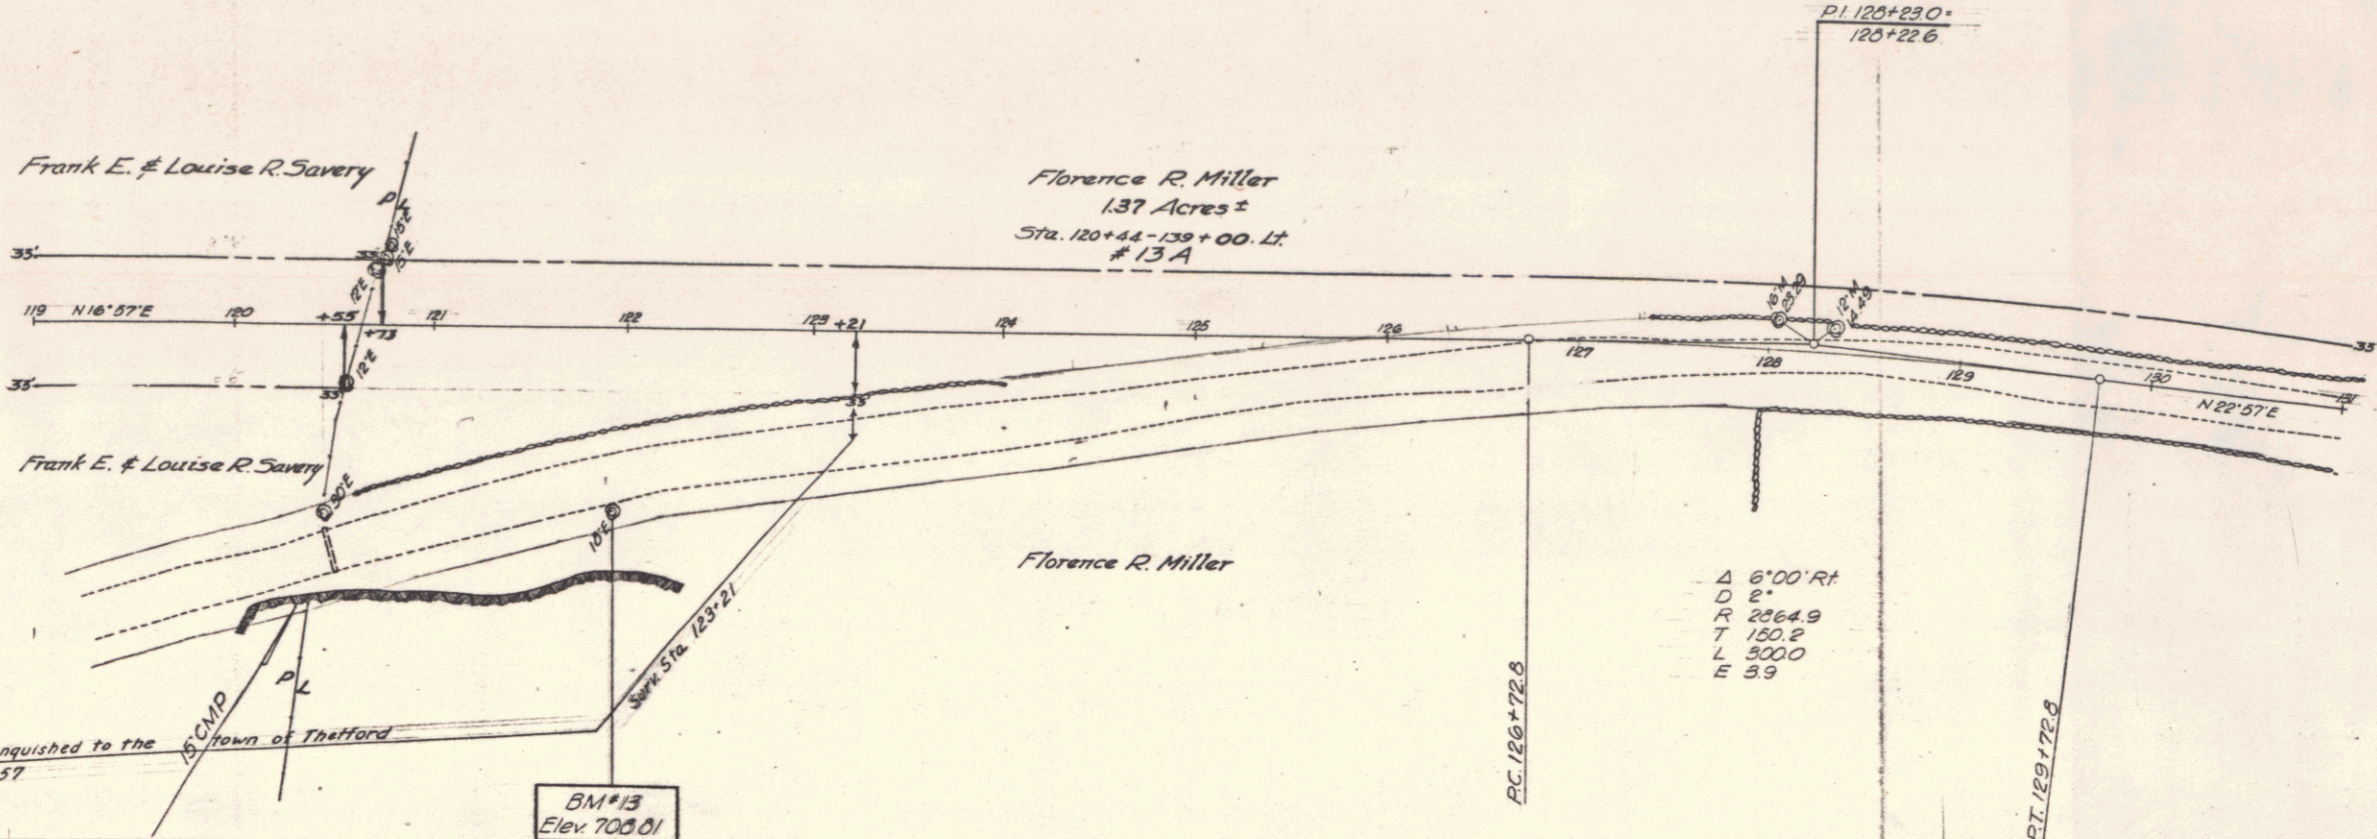

BM #13 S.I.T. 10' Elm 96' ch sta 121+92 Elevation 708.01

THETFORD
 Proj. ST-102-72
 Sheet 62 of 9