

PLAN
 DATE: 3/28/78
 DRAWN BY: R. Abbott
 CHECKED BY: M. Hurley
 NO. 785

PROFILE
 DATE: 3/28/78
 DRAWN BY: R. Abbott
 CHECKED BY: M. Hurley
 NO. 785

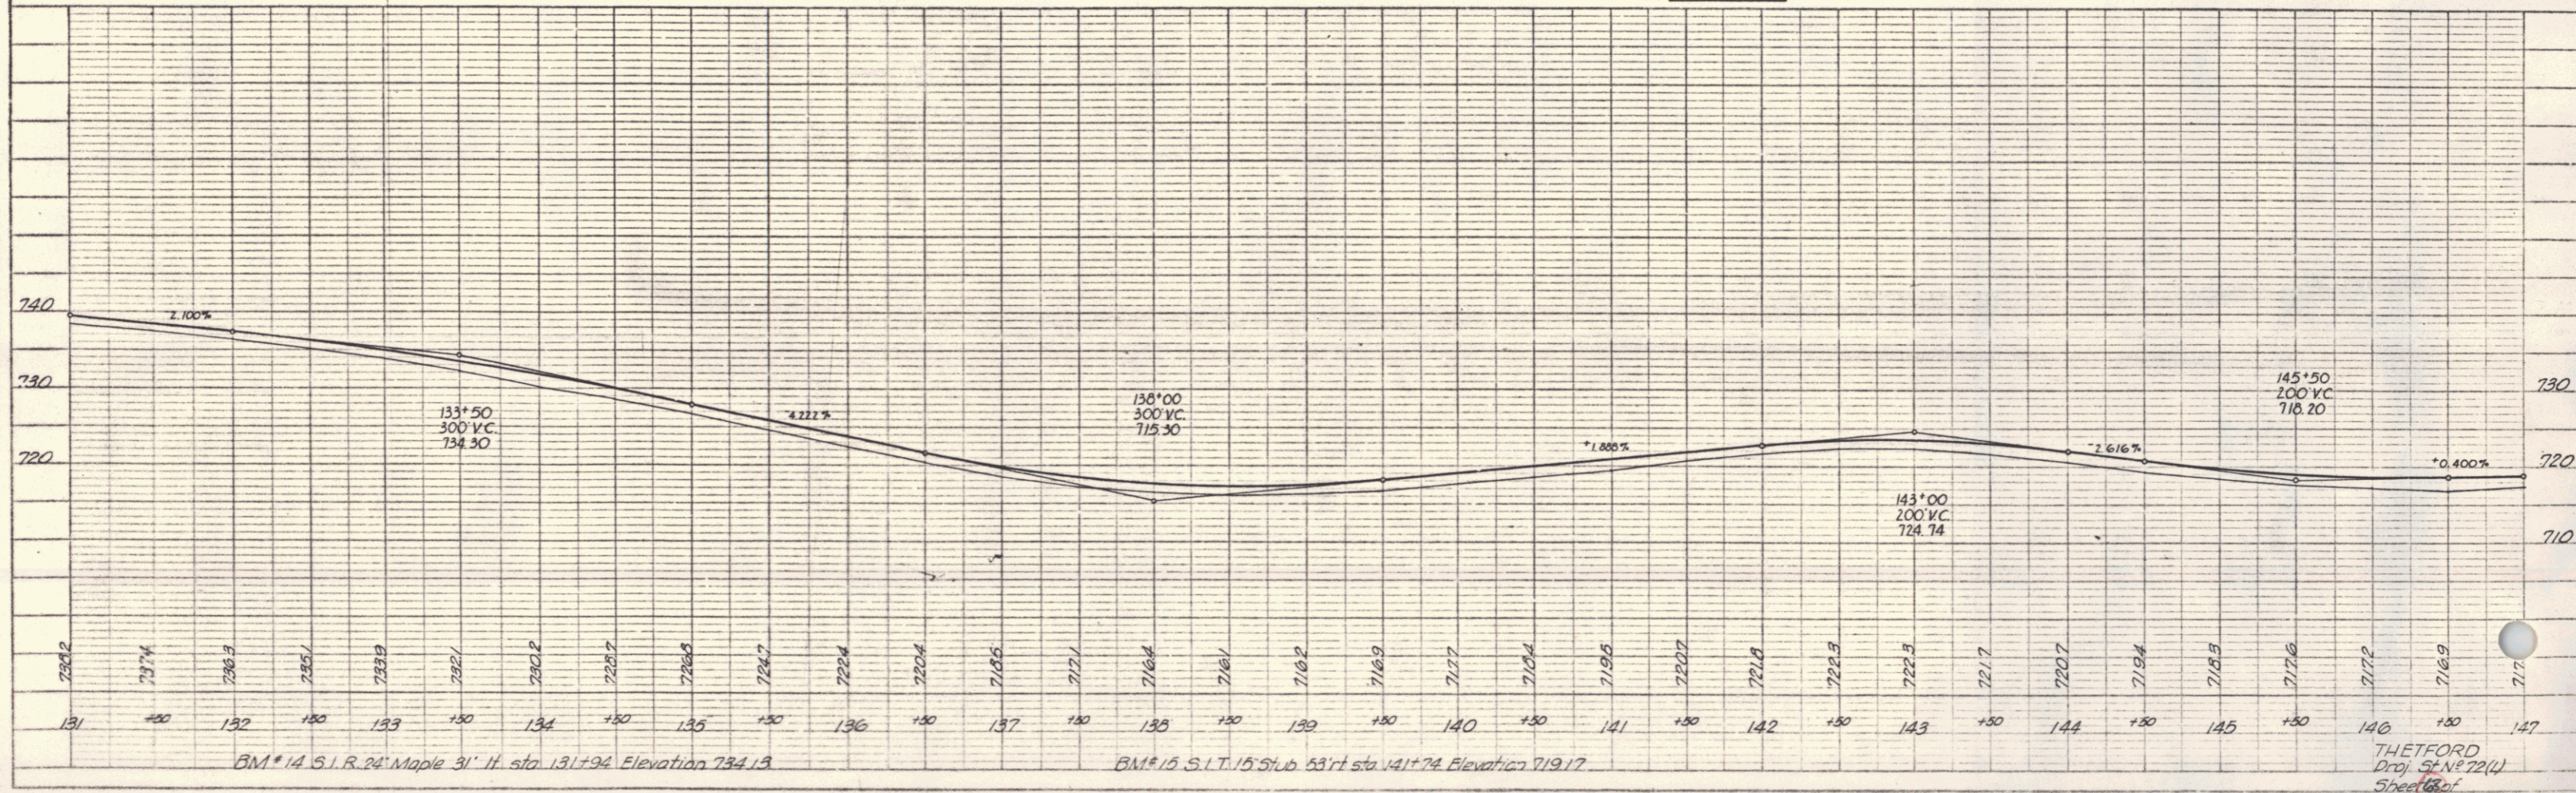
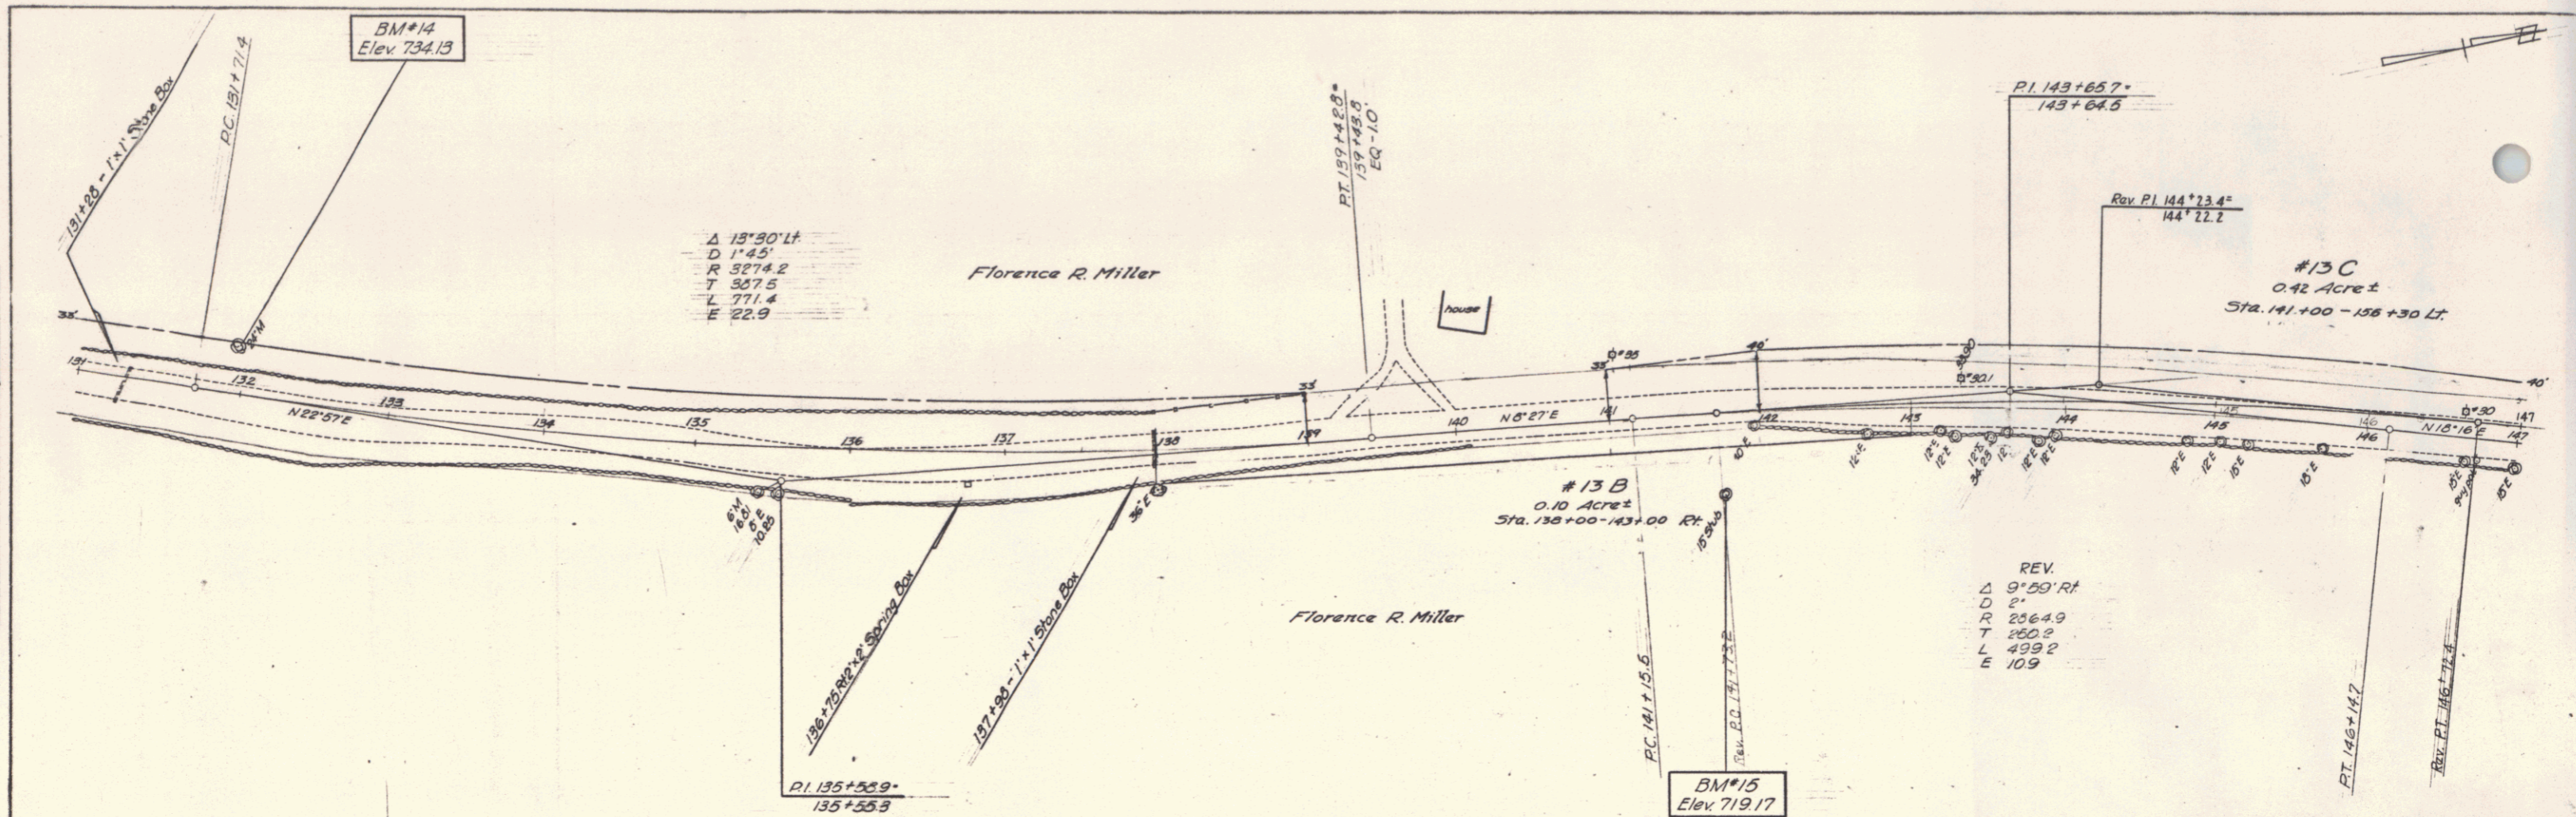


PLATE 14 PLAN & PROFILE OF R.C. & L.T. CURVES
 HURLEY & SON, INC., NEW YORK
 No. 101 No. 318-72

THETFORD
 Proj. ST 72(1)
 Sheet 18 of 18

10