



PLAN	DATE	BY
REVISIONS		
1	7/55	Hurley
2	7/55	Hurley

PROFILE	DATE	BY
REVISIONS		
1	7/55	Hurley
2	7/55	Hurley

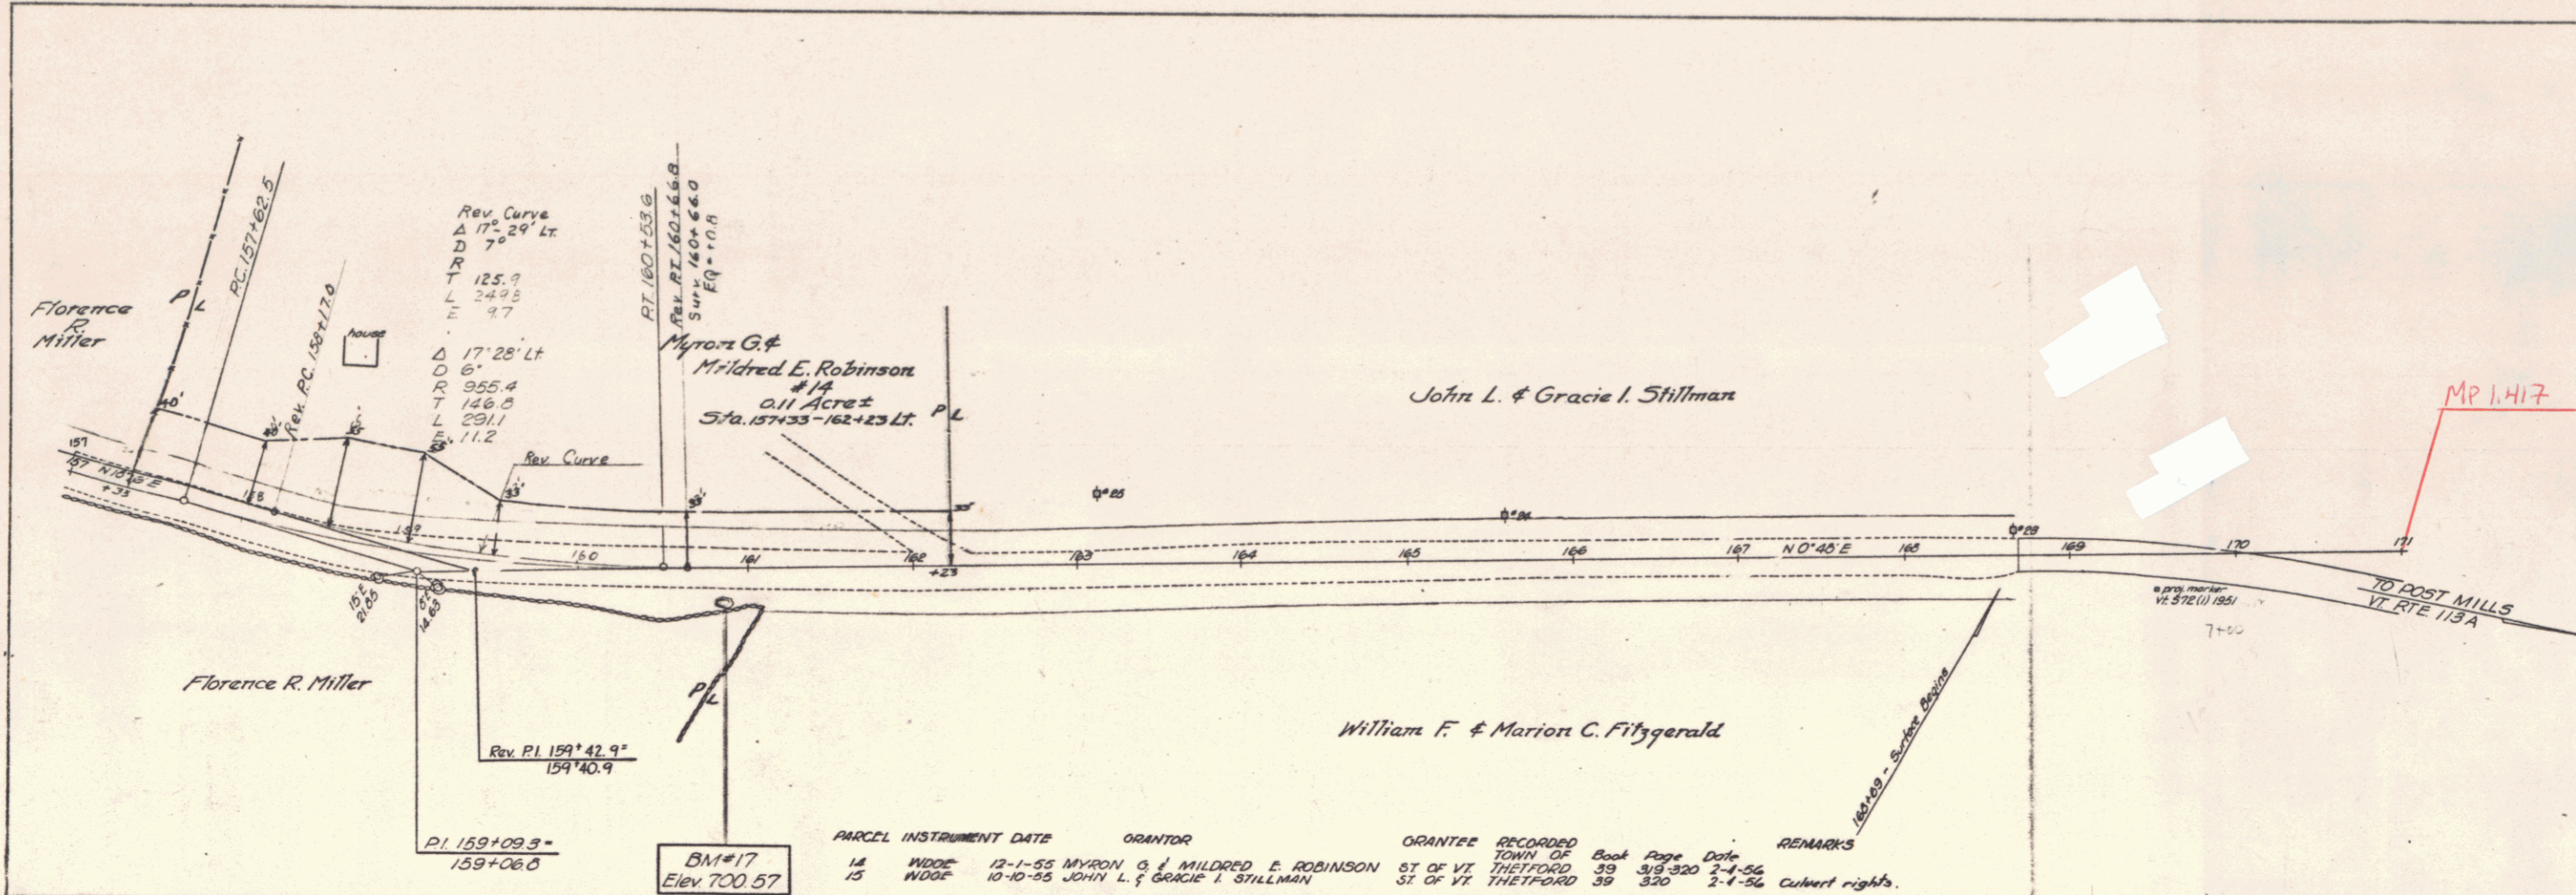

PARCEL	INSTRUMENT DATE	GRANTOR	GRANTEE	RECORDED	TOWN OF	BOOK	PAGE	DATE	REMARKS
14	WDOE 12-1-55	MYRON G. & MILDRED E. ROBINSON	ST OF VT	THETFORD	39	313	320	2-4-55	
15	WDOE 10-10-55	JOHN L. & GRACIE I. STILLMAN	ST OF VT	THETFORD	39	330	330	2-1-56	Culvert rights.

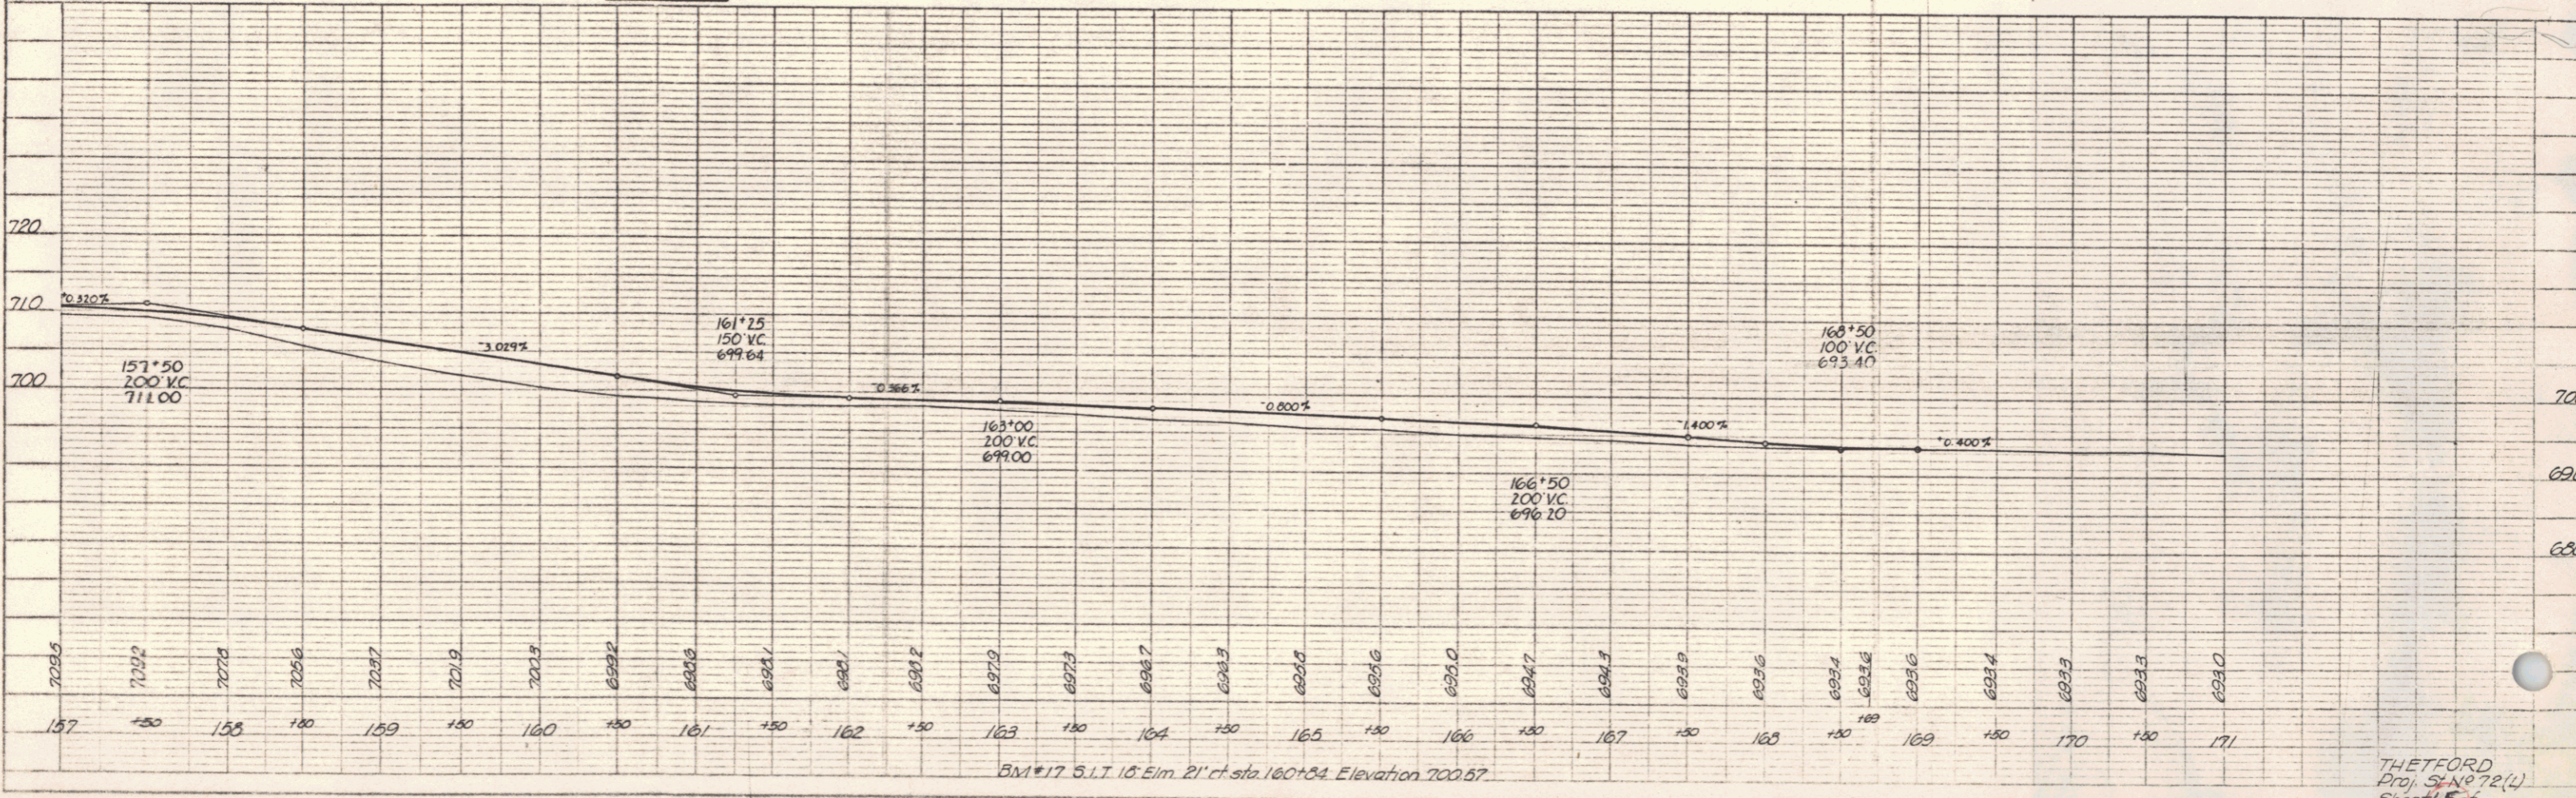

BM#17 5.1.T. 15' Elm. 21' ch. sta. 180+34. Elevation 700.87.

THETFORD
Proj. 51-N-72(1)
Sheet 65 of 12