


PARCEL	INSTRUMENT	DATE	GRANTOR	GRANTEE	TOWN OF	Book	Page	Date	REMARKS
1	W.D.	8-15-55	FREDERICK P HOWARD JR	ST. OF VT.	THETFORD	39	275-6	8-26-55	
2A,B	W.D.O.E.	8-15-55	CHARLES A & NINA HERSCHLEB	ST. OF VT.	THETFORD	39	275	8-26-55	
3	Q.C.D.	8-15-55	DOROTHY BACON	ST. OF VT.	THETFORD	39	274	8-26-55	
4A,B	COND.	5-6-55	FANNIE L. HUGHES	ST. OF VT.	THETFORD	39	248-254	5-7-55	See Report and Notice of Hearing
5	W.D.O.E.	8-15-55	IVA FIFIELD	ST. OF VT.	THETFORD	39	273-4	8-26-55	
6	W.D.O.E.	8-15-55	JEAN M. REINGER	ST. OF VT.	THETFORD	39	271-2	8-26-55	
7A,B	Q.C.D.	9-12-55	TOWN OF THETFORD	ST. OF VT.	THETFORD	39	295	10-17-55	

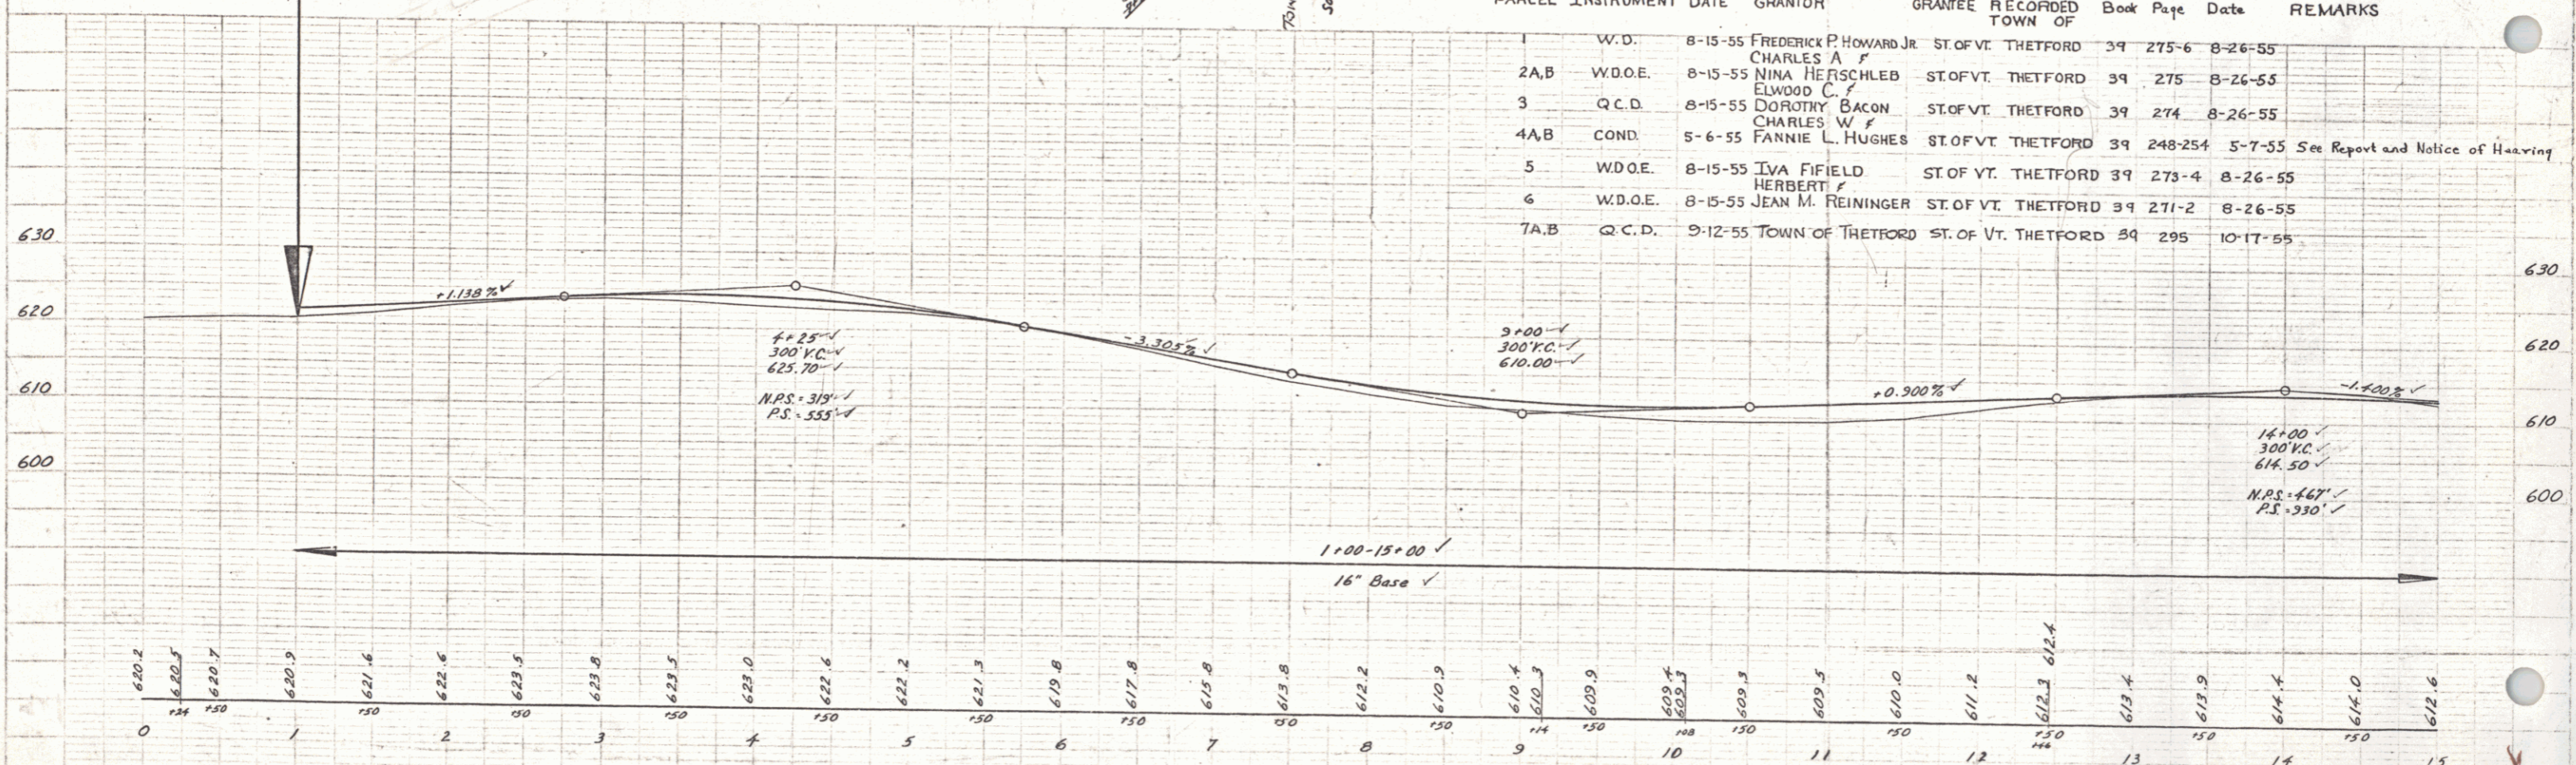

B.M. #1 Spike in Power Pole #3, 26' Lt. of Station 2+12, Elev. 623.67
 B.M. #2 Point on Concrete Header, 12' At Station 12+47.1, Elev. 612.86
 B.M. #3 Point on First Step of School House (S.E. Corner), 54' Rt. of Station 13+82, Elev. 615.39