


PARCEL	INSTRUMENT	DATE	GRANTOR	GRANTEE	RECORDED TOWN OF	Book	Page	Date	REMARKS
8	W.D.	8-15-55	MILFORD V & BERTHA PRESTON	ST. OF VT. THETFORD	39	272	8-26-55		
9	W.D.	8-20-55	CHARLES A. & MARY E. BANKER	ST. OF VT. THETFORD	39	272-3	8-26-55		
10	W.D.O.E.	8-15-55	RODNEY M. PALMER	ST. OF VT. THETFORD	39	271	8-26-55		
11	W.D.	8-15-55	G. CASS & CORNELIA G. LIGHTNER	ST. OF VT. THETFORD	39	270	8-26-55		
12	W.D.	8-15-55	MARY JULIAN GLOVER	ST. OF VT. THETFORD	39	270	8-26-55		
13	W.D.	8-20-55	RALPH & ALICE FIFIELD	ST. OF VT. THETFORD	39	269-70	8-26-55	See also Sheets 9 & 10	

Revised Curve
 A 1'-02" Rr ✓
 D 0'-30" ✓
 T 11439.13' ✓
 L 183.4' ✓
 E 206.7' ✓
 0.22' ✓
 Bank - No Banking ✓

25+00
 Sta. 25+00 R.R. & Sta. 28+56 R.R.
 Construct Approaches

Construct Drives

15+90	16+10	LT	20+12	LT
18+62	18+65	LT	27+30	RT
18+32	18+85	RT	27+75	RT
2+00	20+75	20+15	20+62	RT
21+82	22+00	LT		
22+00	22+50	LT		
25+12	24+32	RT		
25+12	25+20	RT		
25+12	25+20	RT		
27+15	27+20	LT		

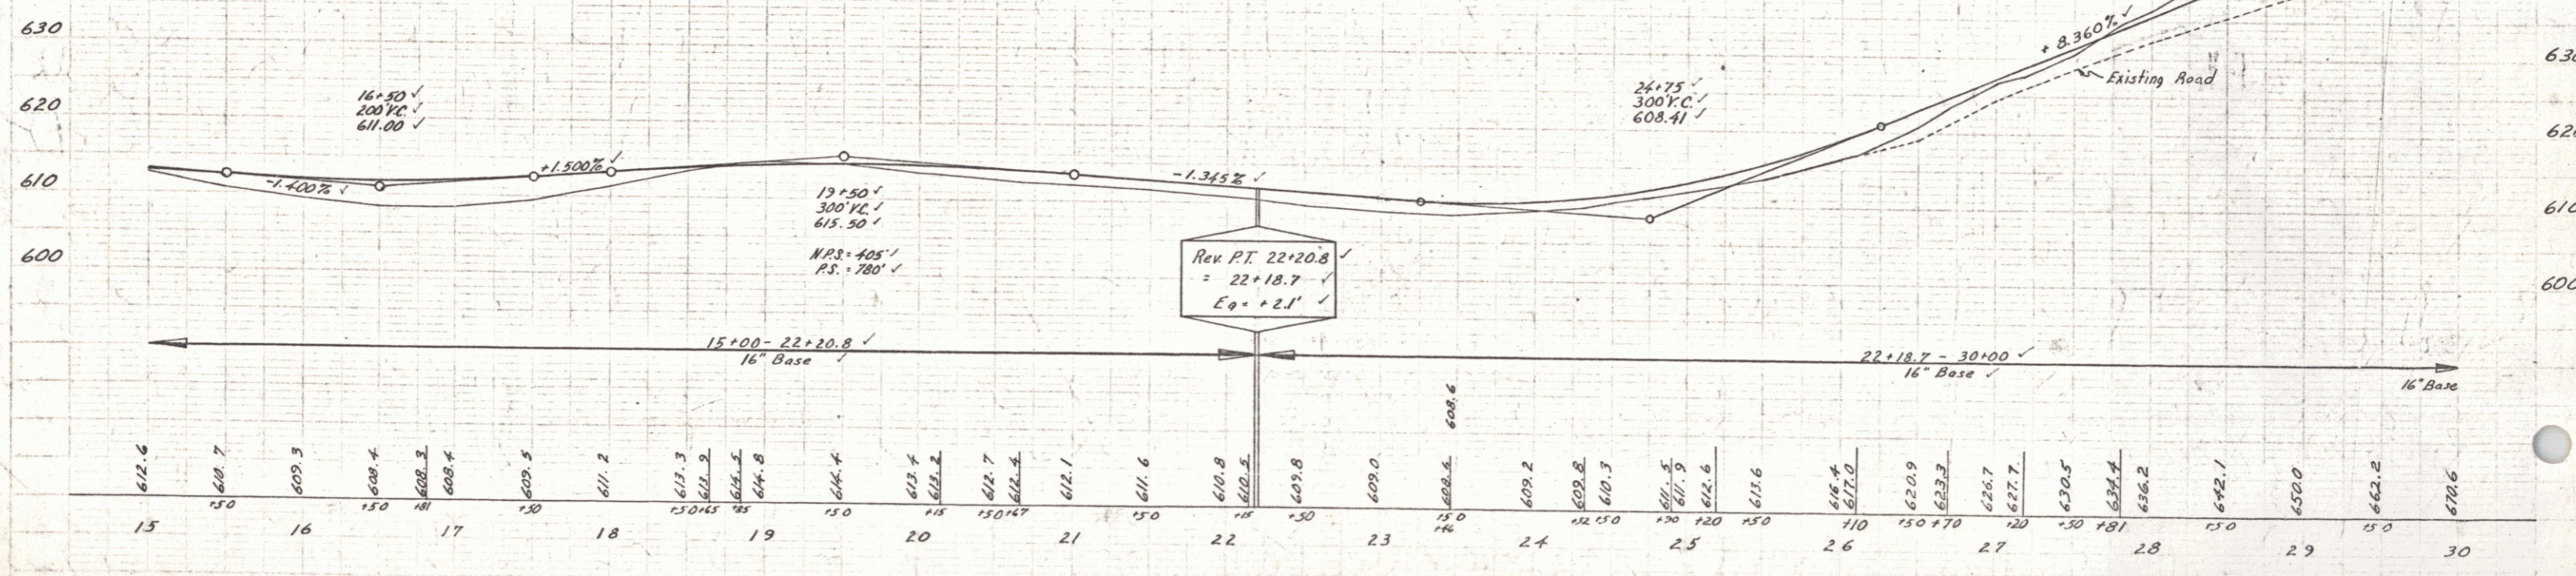

B.M. #4 Pin in Center of State Highway Bound, 31.5' Rr of Station 20+67, Elev. 612.74

B.M. #5 S.I.T. 24" M, 51' Rr of Station 26+01, Elev. 619.54