


PLAN
 DATE
 SCALE
 NOTE BOOK ELEMENT CHECKED
 DATE

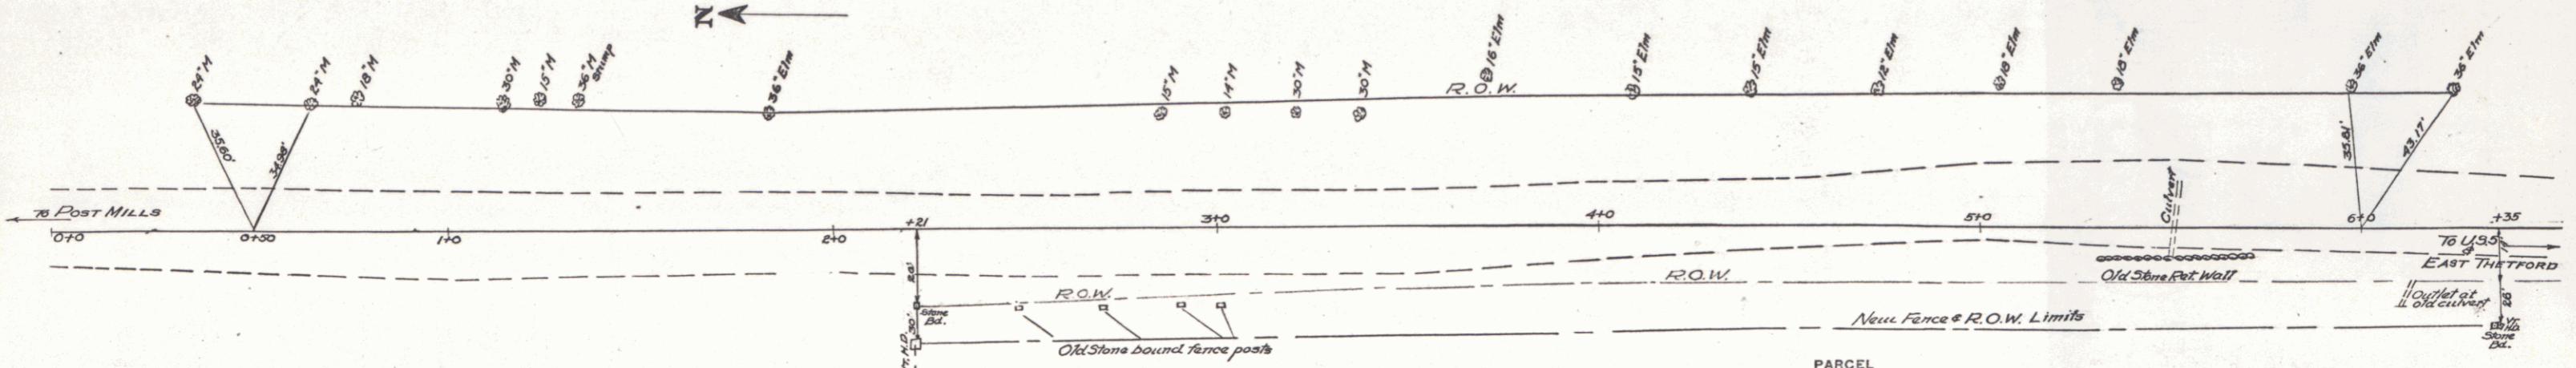

PALMER'S GARAGE

*See sta
 21412 area
 S 72(2)*

G. CASS & CORNELIA G. LIGHTNER

PARCEL INSTRUMENT W.D.O.E.
 DATE 5-17-51
 GRANTOR G. CASS & CORNELIA G. LIGHTNER
 GRANTEE STATE OF VERMONT
 RECORDED THETFORD BOOK 39 PAGE 39-40 DATE 5-25-51
 REMARKS-

THETFORD ROUTE 113-A
 THETFORD CENTER
 LIGHTNER PROPERTY
 SURVEY BY VT. HIGHWAY DEPT.
 MAY 1950

PROFILE
 DATE
 SCALE
 NOTE BOOK ELEMENT CHECKED
 DATE



*S 72(2)
 Record Plans*

THETFORD ROUTE 113-A
 SHEET 8A