
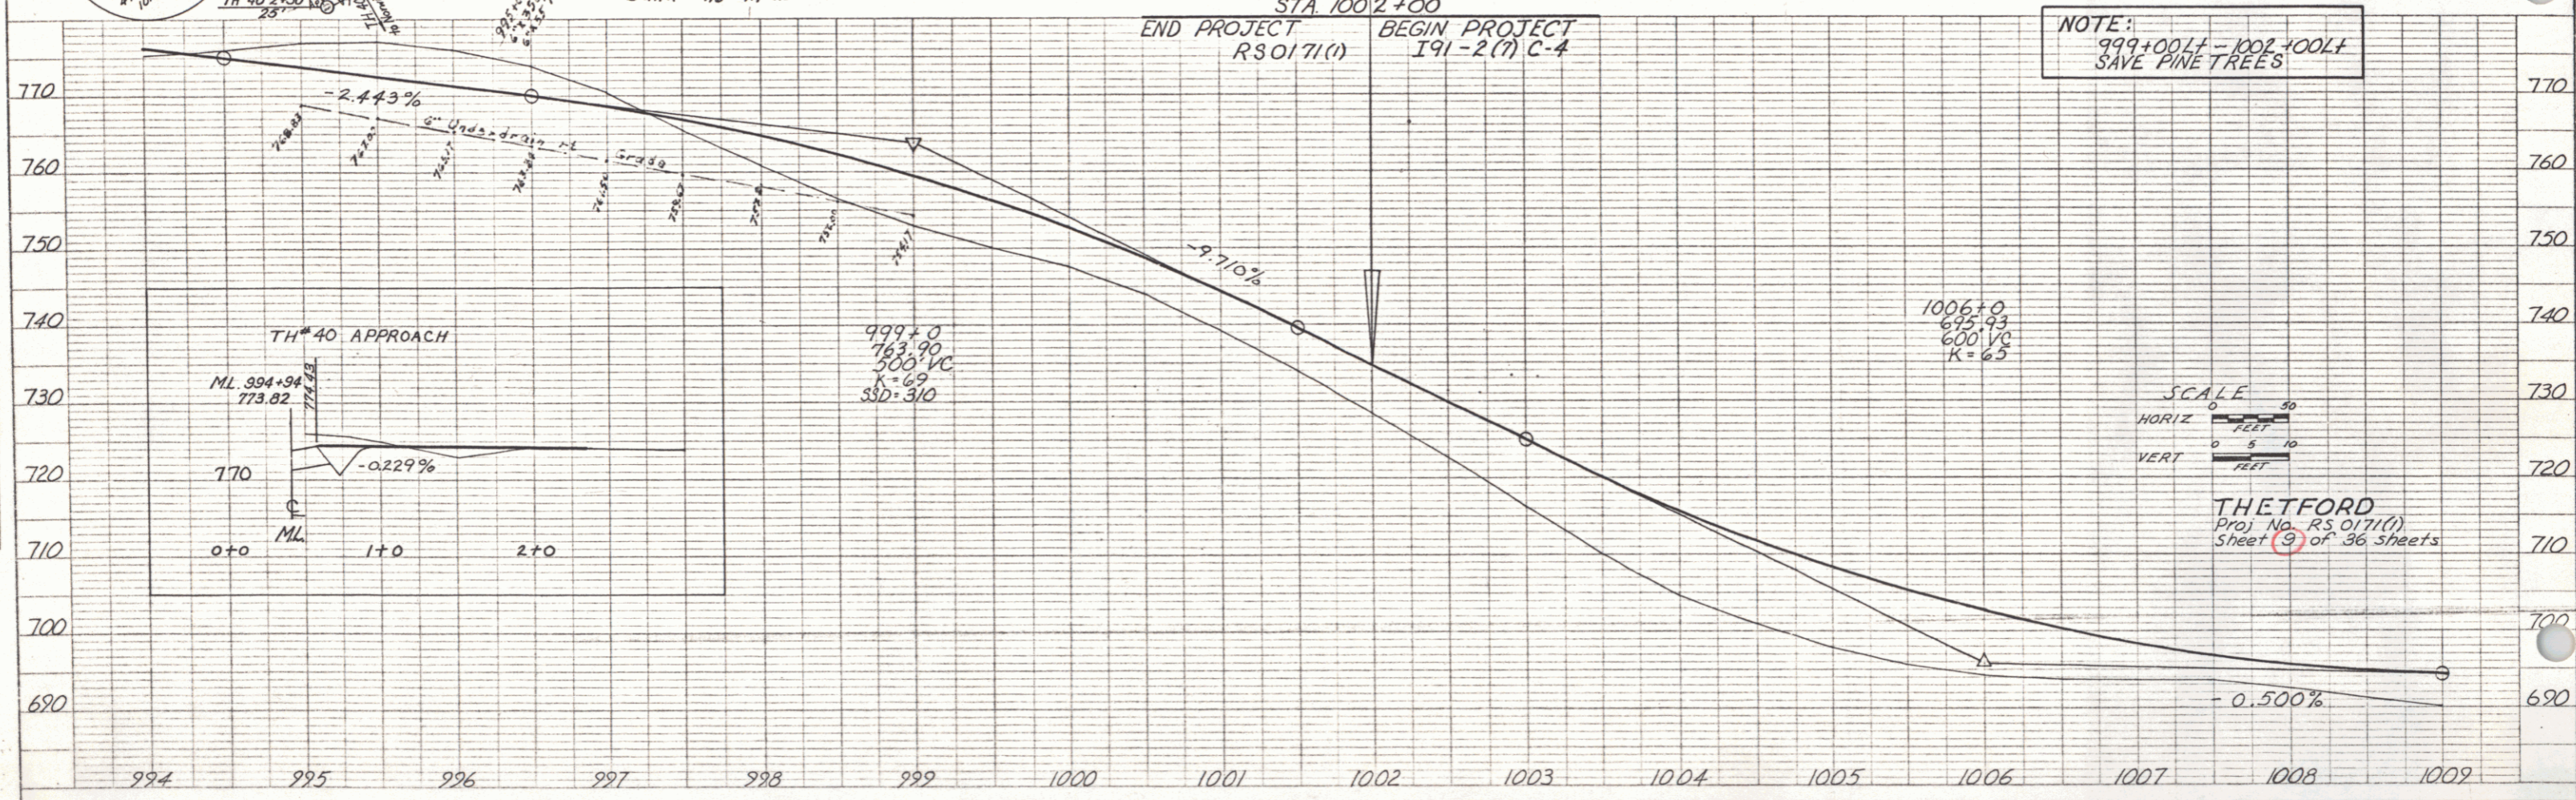


CONSTRUCT BERM  
998+75 Rt. ~ 1000+35 Rt.

CONSTRUCT APPROACH  
Rt. 994+94'

CONSTRUCT DRIVE  
Lt. 994+50' Rt. 998+45'  
998+15' Rt. 1001+20'  
998+83'

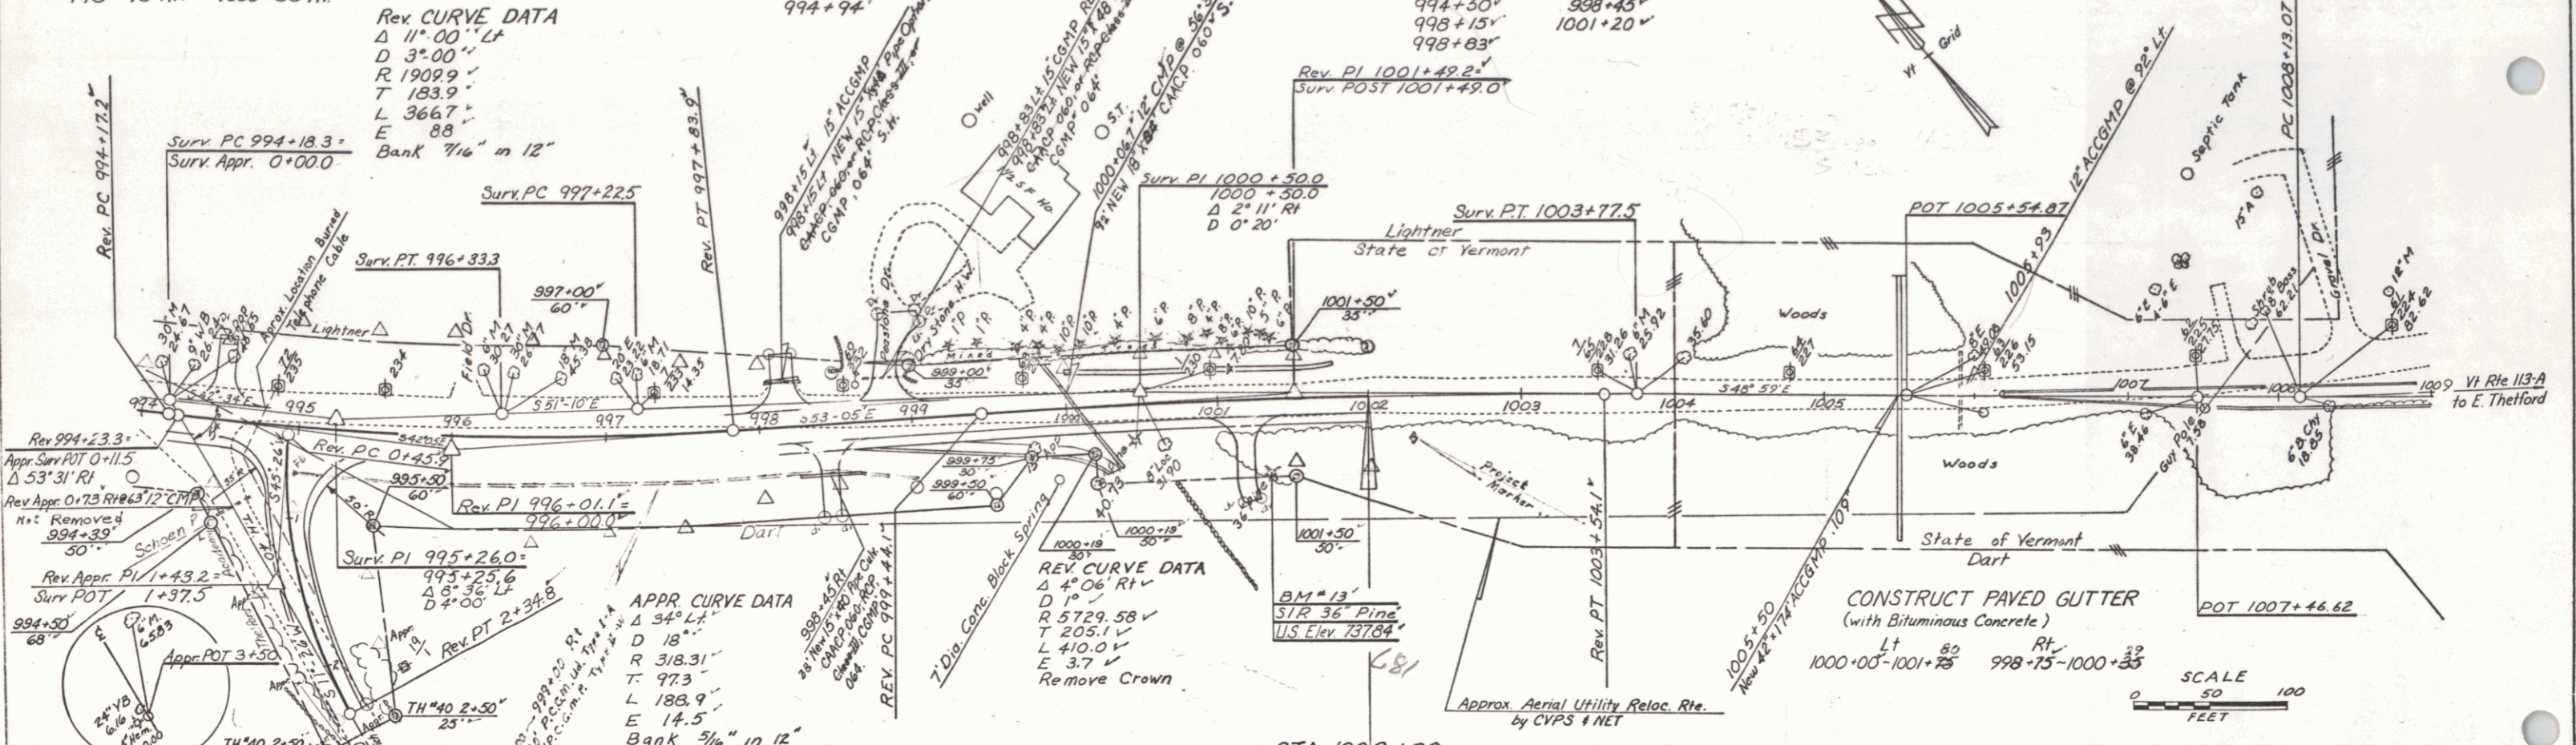

PLAN  
DATE 4-88  
DRAWN BY J. Larson  
CHECKED BY [Signature]  
NOTED BY [Signature]

PROF. E  
DATE 4-88  
DRAWN BY [Signature]  
CHECKED BY [Signature]  
NOTED BY [Signature]