


PROJECT: ST 176 V
 DATE: 10/01/1949
 ROUTE: VT 113
 TOWN: THETFORD
 PIN: 00R457

MP 8.505-6.914
 RIGHT-OF-WAY DIVISION
 TOWN FILE
 PERPETUAL
 Town of VT 113
 [To Be Returned To R.O.W. Division]

PROJECT NUMBER	ST 176 V
TYPE	
CONTRACTOR	
LOCATION	
YEAR	
LENGTH	
MI.	

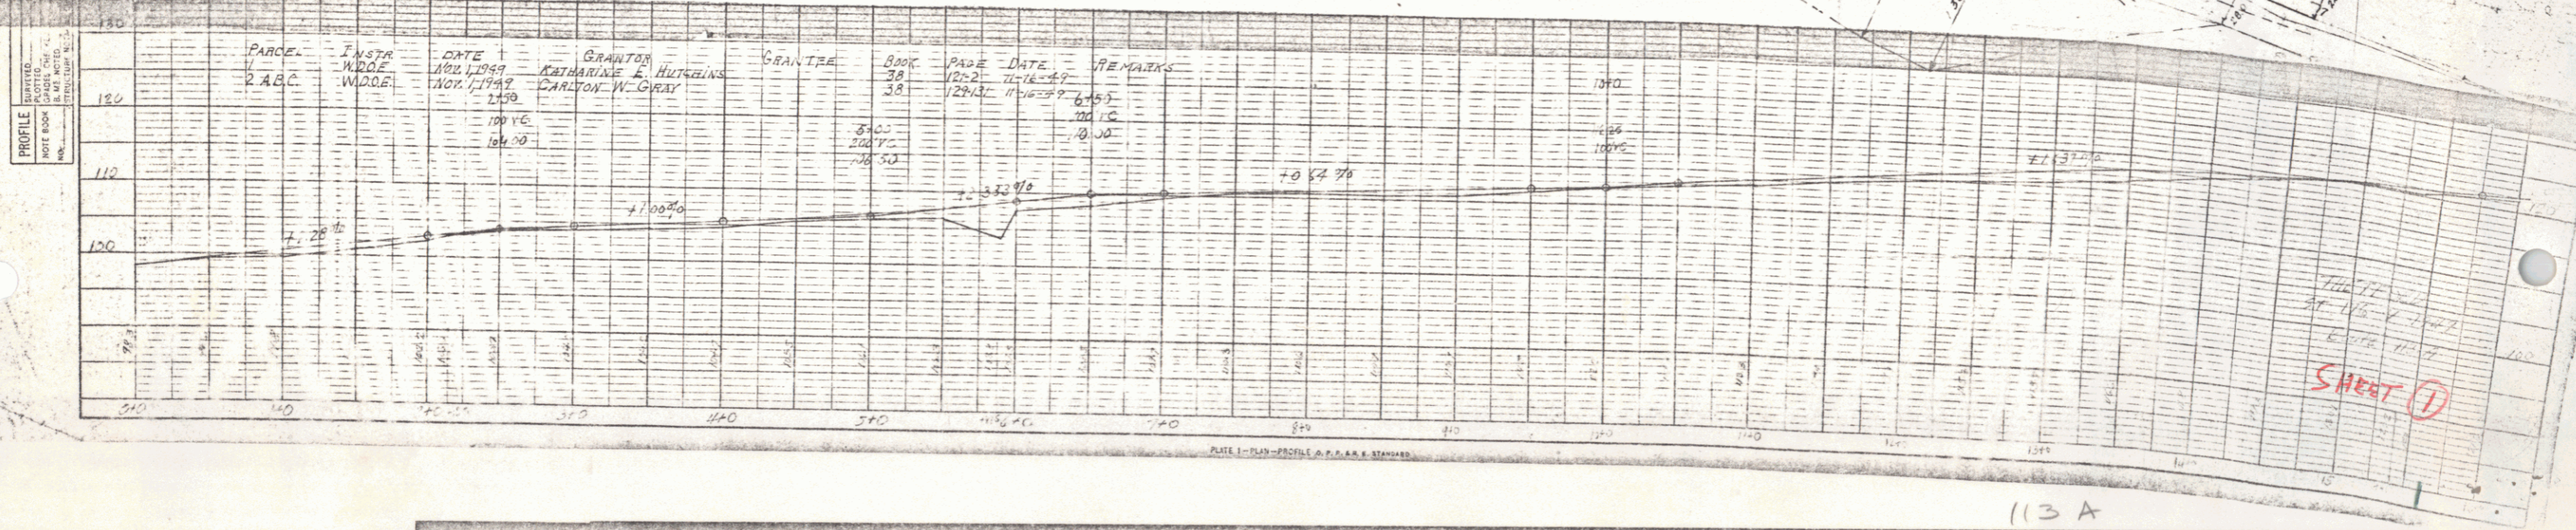

SHEET ①