


DATE	
BY	
DESIGNED	
CHECKED	
DATE	
NO.	

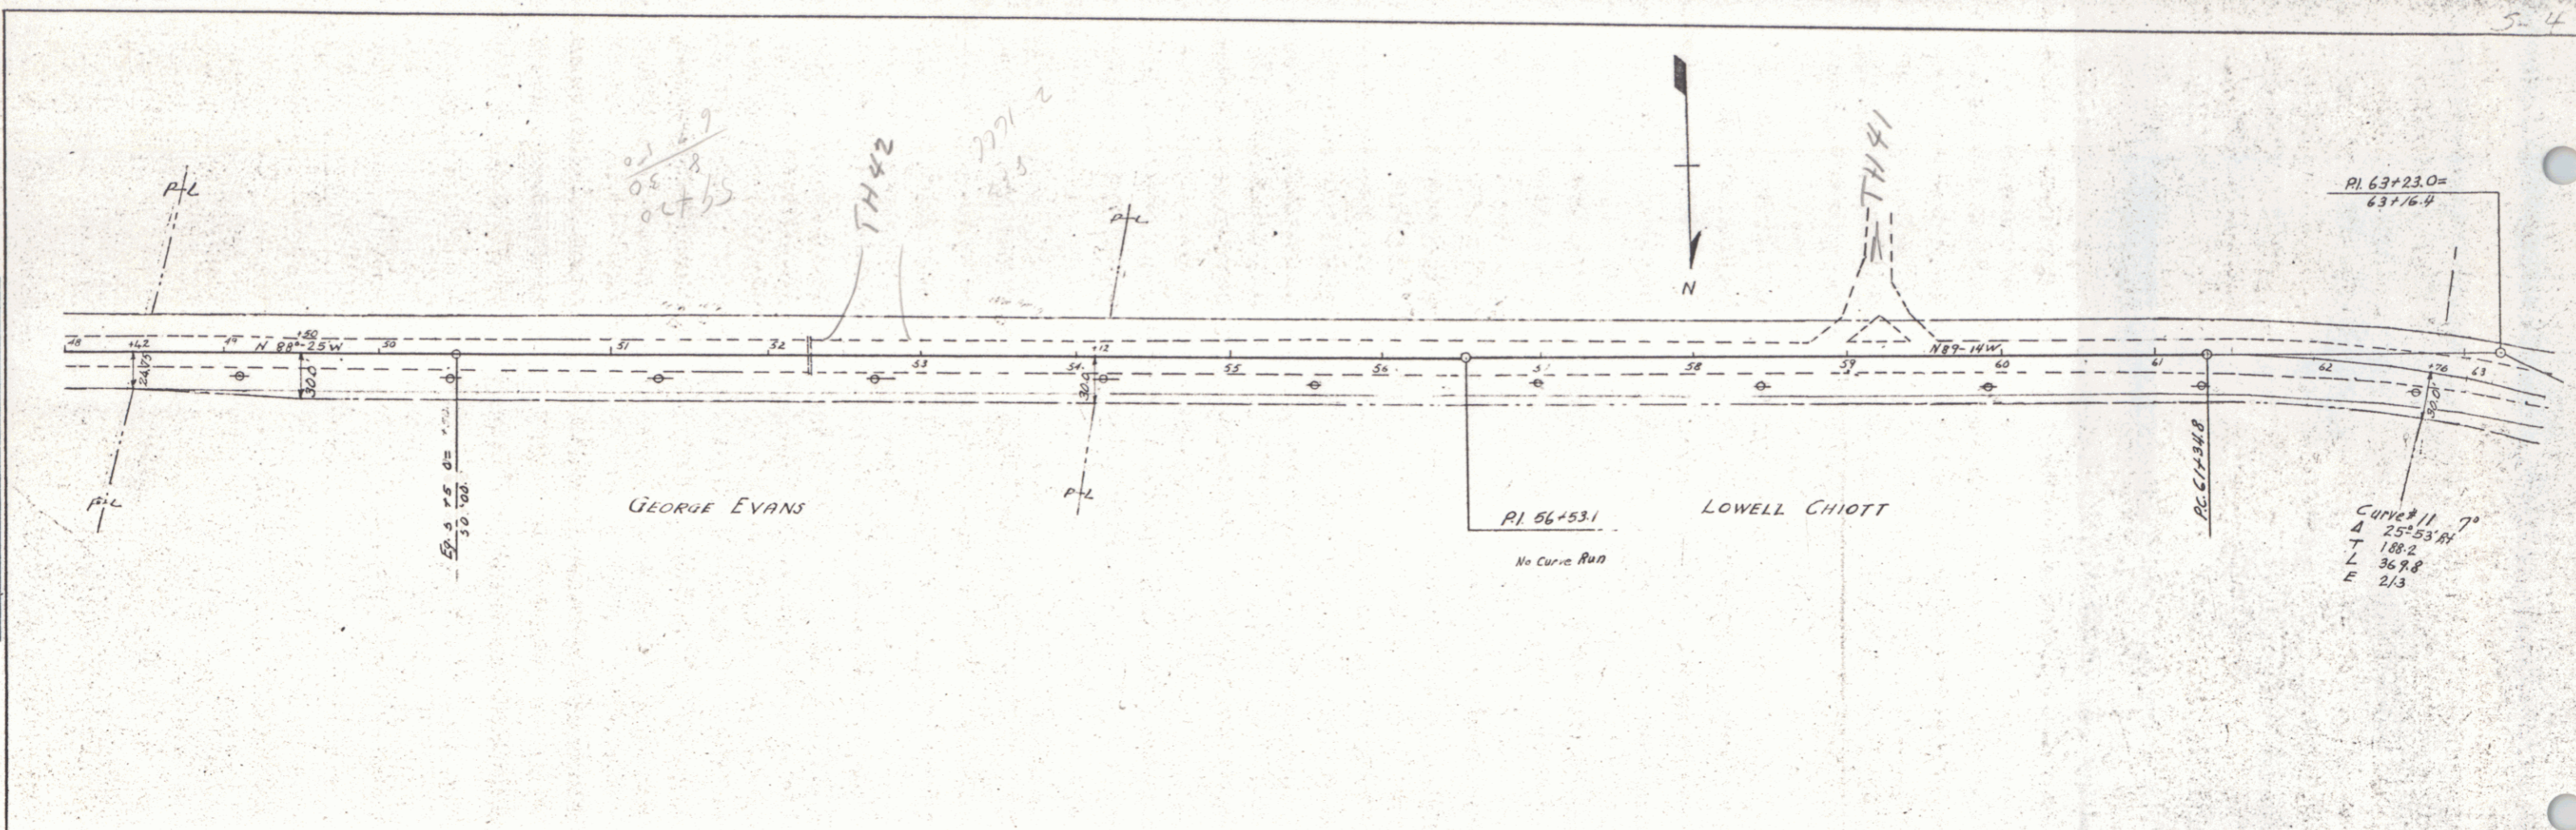

DATE	
BY	
DESIGNED	
CHECKED	
DATE	
NO.	

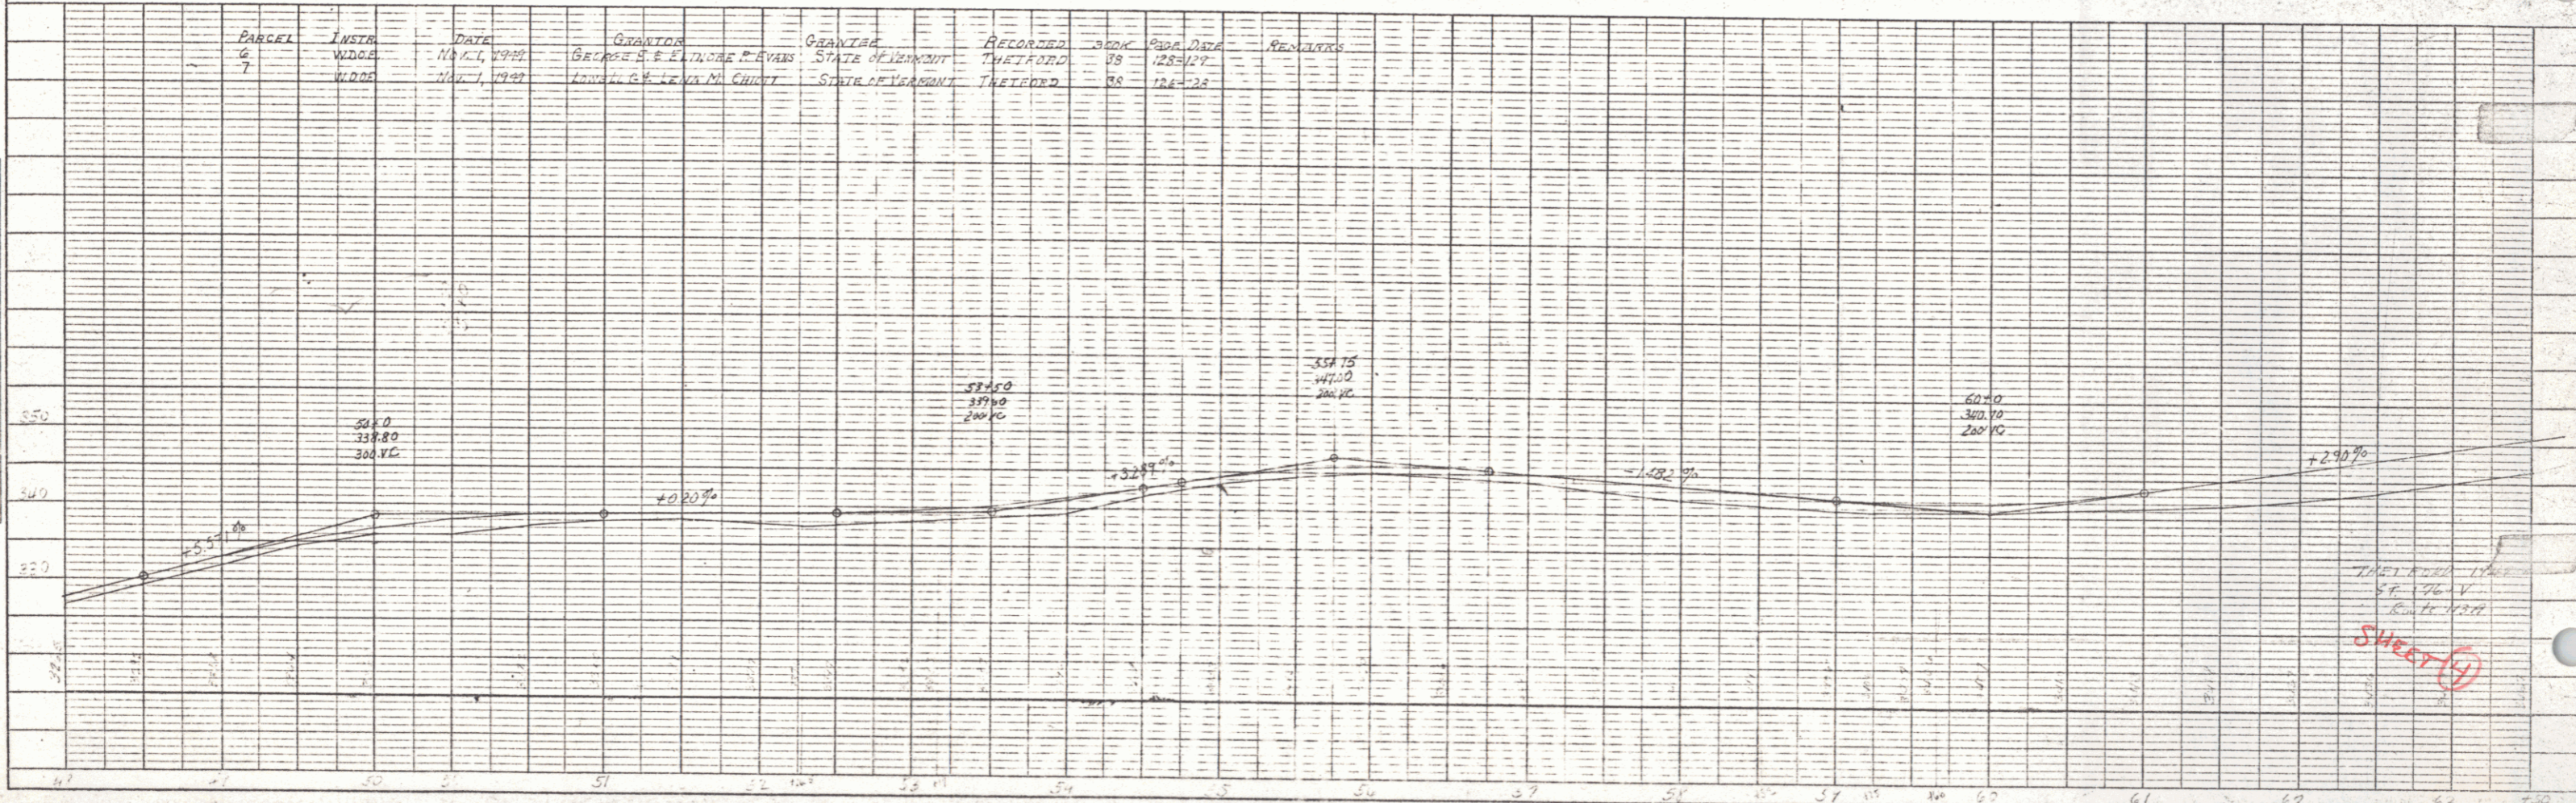


PLATE 1 - PLAN - PROFILE - S. P. & W. E. BINGHAM
 KETCHUM & ASSOC. INC. - SIOUX FALLS, S.D.