


PLAN  
 DRAWN BY  
 CHECKED BY  
 DATE  
 SCALE  
 PROJECT NO.



Curve #13 3°  
 Δ 7°48'00"  
 T 128.5  
 L 256.7  
 E 4.3

*Inductance*

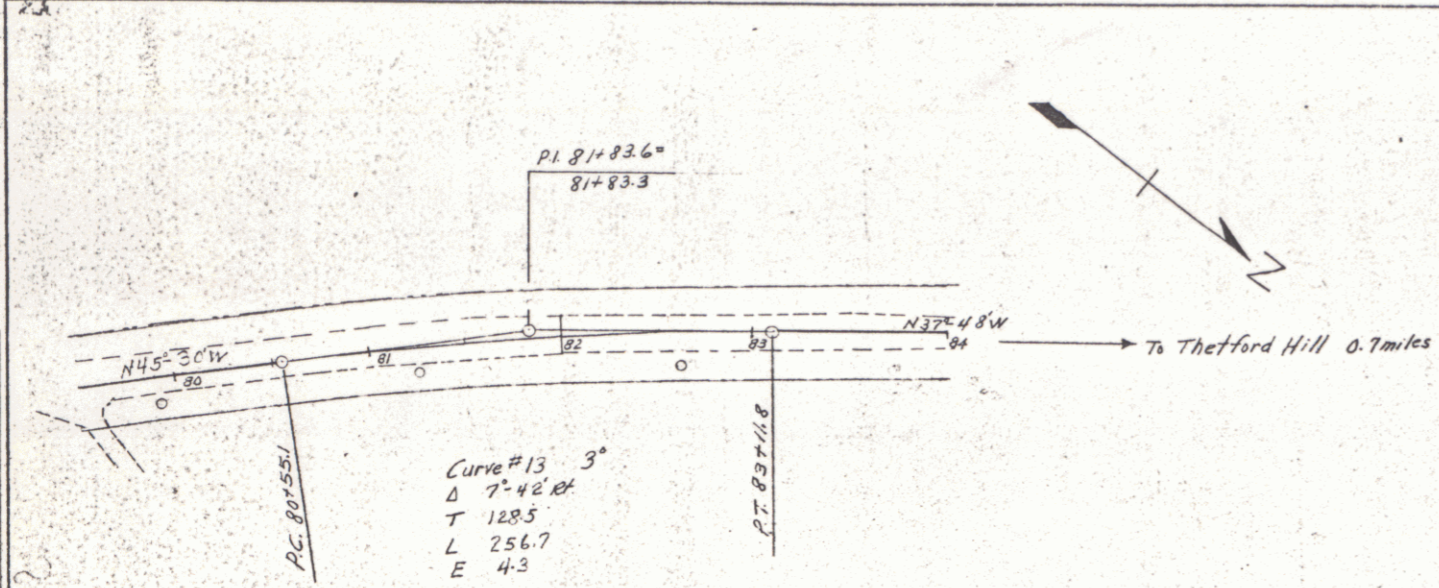

THET FORD HILL 1987  
 ST 176-V  
 ROAD MAP

SHEET 6



10