

INDEX OF SHEETS

1. Title Sheet
2. Typical Section
3. Summary of Quantities & Item Detail Sheet
4. Earthworks
- 5-6. R.O.W. Sheets
- 7-8. Plan/Profile Sheets
9. B-1 Costing Tables 12/ 6/71
10. B-2 Slope Sounding 12/ 6/71
11. D-2 Roadways & Underdrain 3/ 6/72
12. E-2 Const. Approach Signs 12/18/71
13. E-3 Betterment Project Signs 12/19/71
14. E-6 On-Project Const. Signs 12/15/71
15. E-7 Delineation & Barricades for Const. Area 3/15/72
- 16-17. Blank
- 18-27. Cross Sections

WARREN GORE - BP 0321-7304

RECORD PLANS

MATERIALS

Sub-base of Gravel Devost Norton, Vt.
 Bituminous Concrete Pavement L.M. Pike Coventry, Vt.
 Concrete Class B Caulkins Coventry, Vt.
 ACCGMP - 15" (.064) .48" (.109) Lane Metal Products, Ballston Spa, N.Y.
 Guard Rail - 2-Cable, with wood posts District 9 Stock
 Anchors for 2-Cable Guard Rail District 9 Stock
 Seed and Fertilizer - Griswold Fence Co., Williston, Vt.

CONTRACTOR:

State of Vermont Project Begun 9-73
 District 9 Completed 6-75
 Record Plans P.F.W. 12-75

STATE OF VERMONT DEPARTMENT OF HIGHWAYS



PROPOSED IMPROVEMENT



BETTERMENT PROJECT

WARREN GORE COUNTY OF ESSEX

VERMONT ROUTE 114 ISLAND POND - NORTON ROAD

BEGINNING AT A POINT APPROXIMATELY 2.1 MILES
 SOUTH OF THE NORTON-WARREN GORE TOWN LINE
 AND EXTENDING 0.4 MILES NORTHERLY.

LENGTH OF PROJECT 2000 FT. 0.4 MI.
 LENGTH OF ROADWAY 2000 FT. 0.4 MI.
 V = 50 MPH

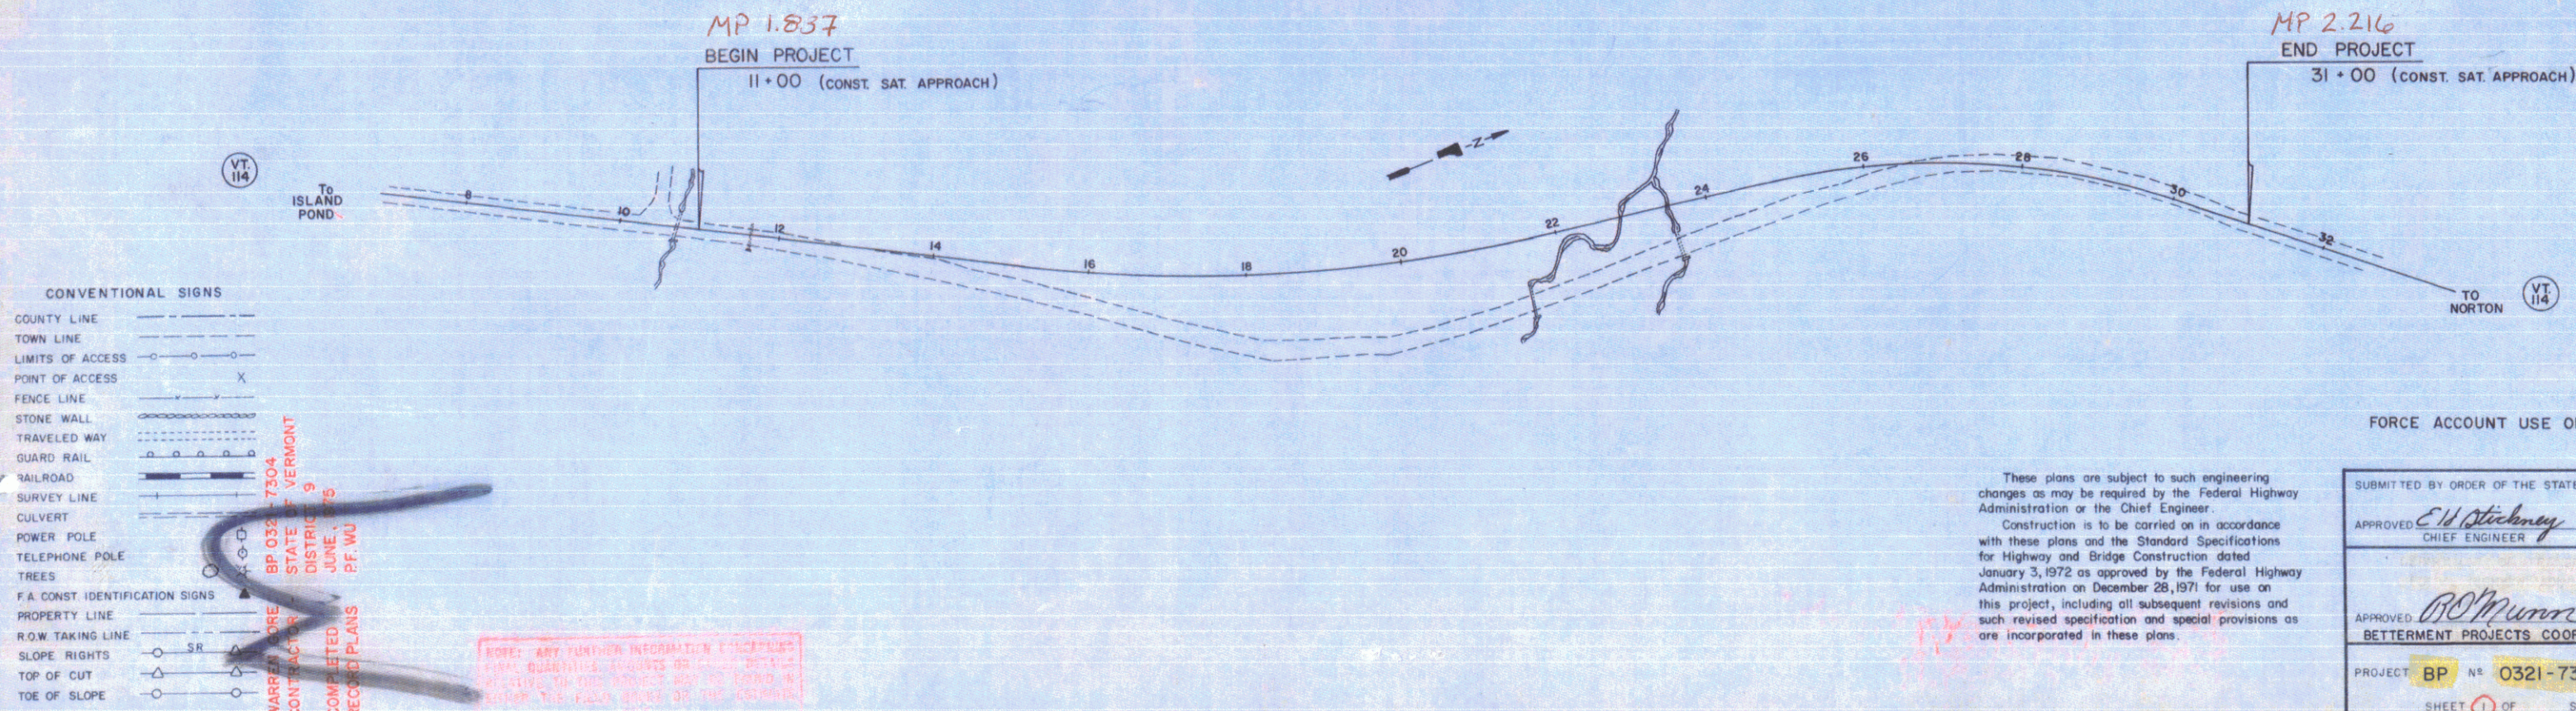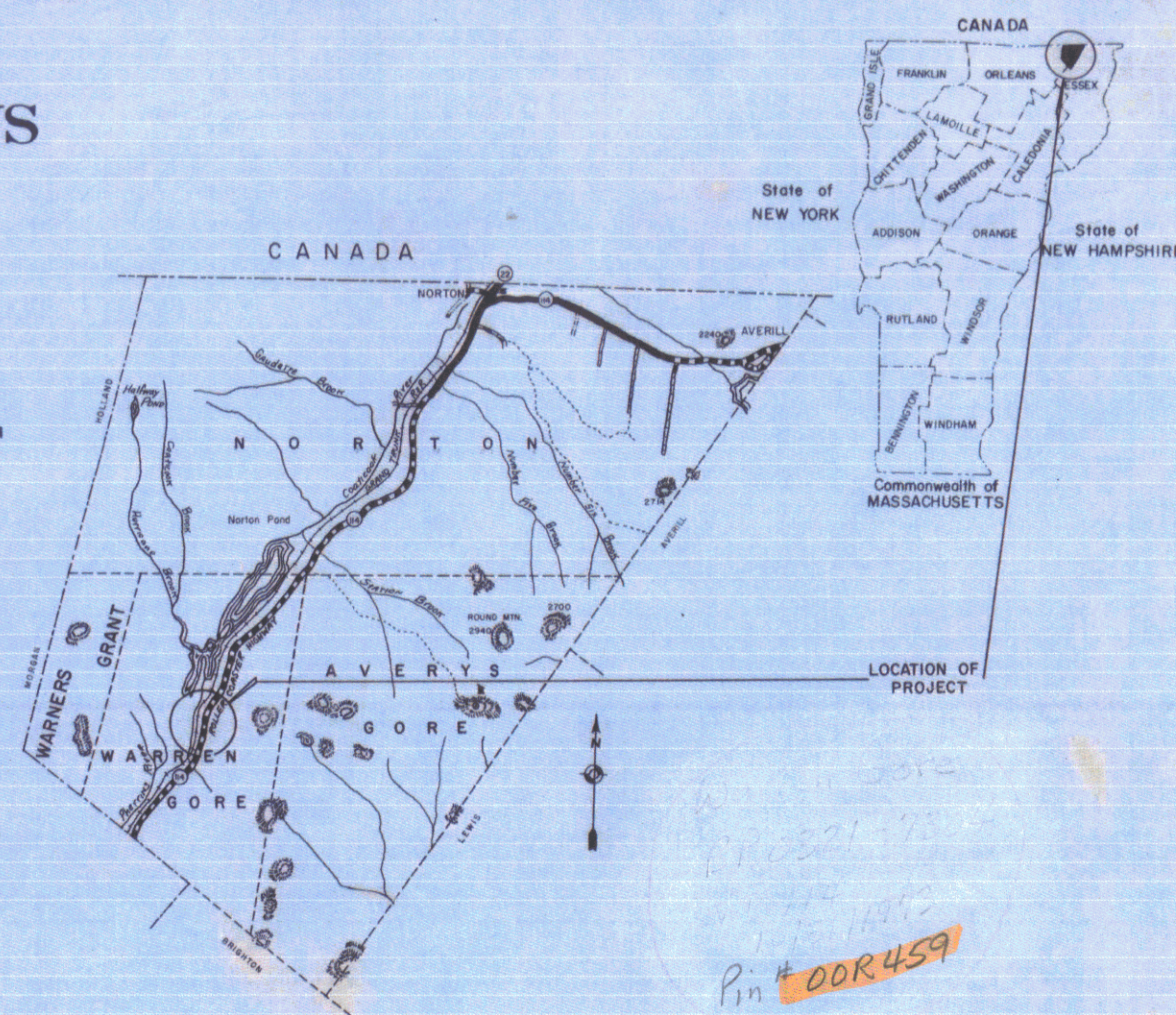

CONVENTIONAL SIGNS

- COUNTY LINE
- TOWN LINE
- LIMITS OF ACCESS
- POINT OF ACCESS
- FENCE LINE
- STONE WALL
- TRAVELED WAY
- GUARD RAIL
- RAILROAD
- SURVEY LINE
- CULVERT
- POWER POLE
- TELEPHONE POLE
- TREES
- F.A. CONST. IDENTIFICATION SIGNS
- PROPERTY LINE
- R.O.W. TAKING LINE
- SLOPE RIGHTS
- TOP OF CUT
- TOE OF SLOPE

BP 0321-7304
 STATE OF VERMONT
 DISTRICT 9
 COMPLETED
 RECORD PLANS
 P.F.W.

NOTE: ANY FURTHER INFORMATION CONCERNING
 THIS PROJECT SHOULD BE OBTAINED FROM THE
 RECORD PLANS OR THE FIELD BOOKS OF THE PROJECT.

FORCE ACCOUNT USE ONLY

These plans are subject to such engineering changes as may be required by the Federal Highway Administration or the Chief Engineer. Construction is to be carried on in accordance with these plans and the Standard Specifications for Highway and Bridge Construction dated January 3, 1972 as approved by the Federal Highway Administration on December 28, 1971 for use on this project, including all subsequent revisions and such revised specification and special provisions as are incorporated in these plans.

SUBMITTED BY ORDER OF THE STATE HIGHWAY BOARD
 APPROVED *E.H. Steinhilber* DATE 10/31/73
 CHIEF ENGINEER

APPROVED *B.C. Munn* DATE 10/31/73
 BETTERMENT PROJECTS COORDINATOR

PROJECT BP N° 0321-7304
 SHEET 1 OF SHEETS

D-10 S.R.S. 12/17/70