
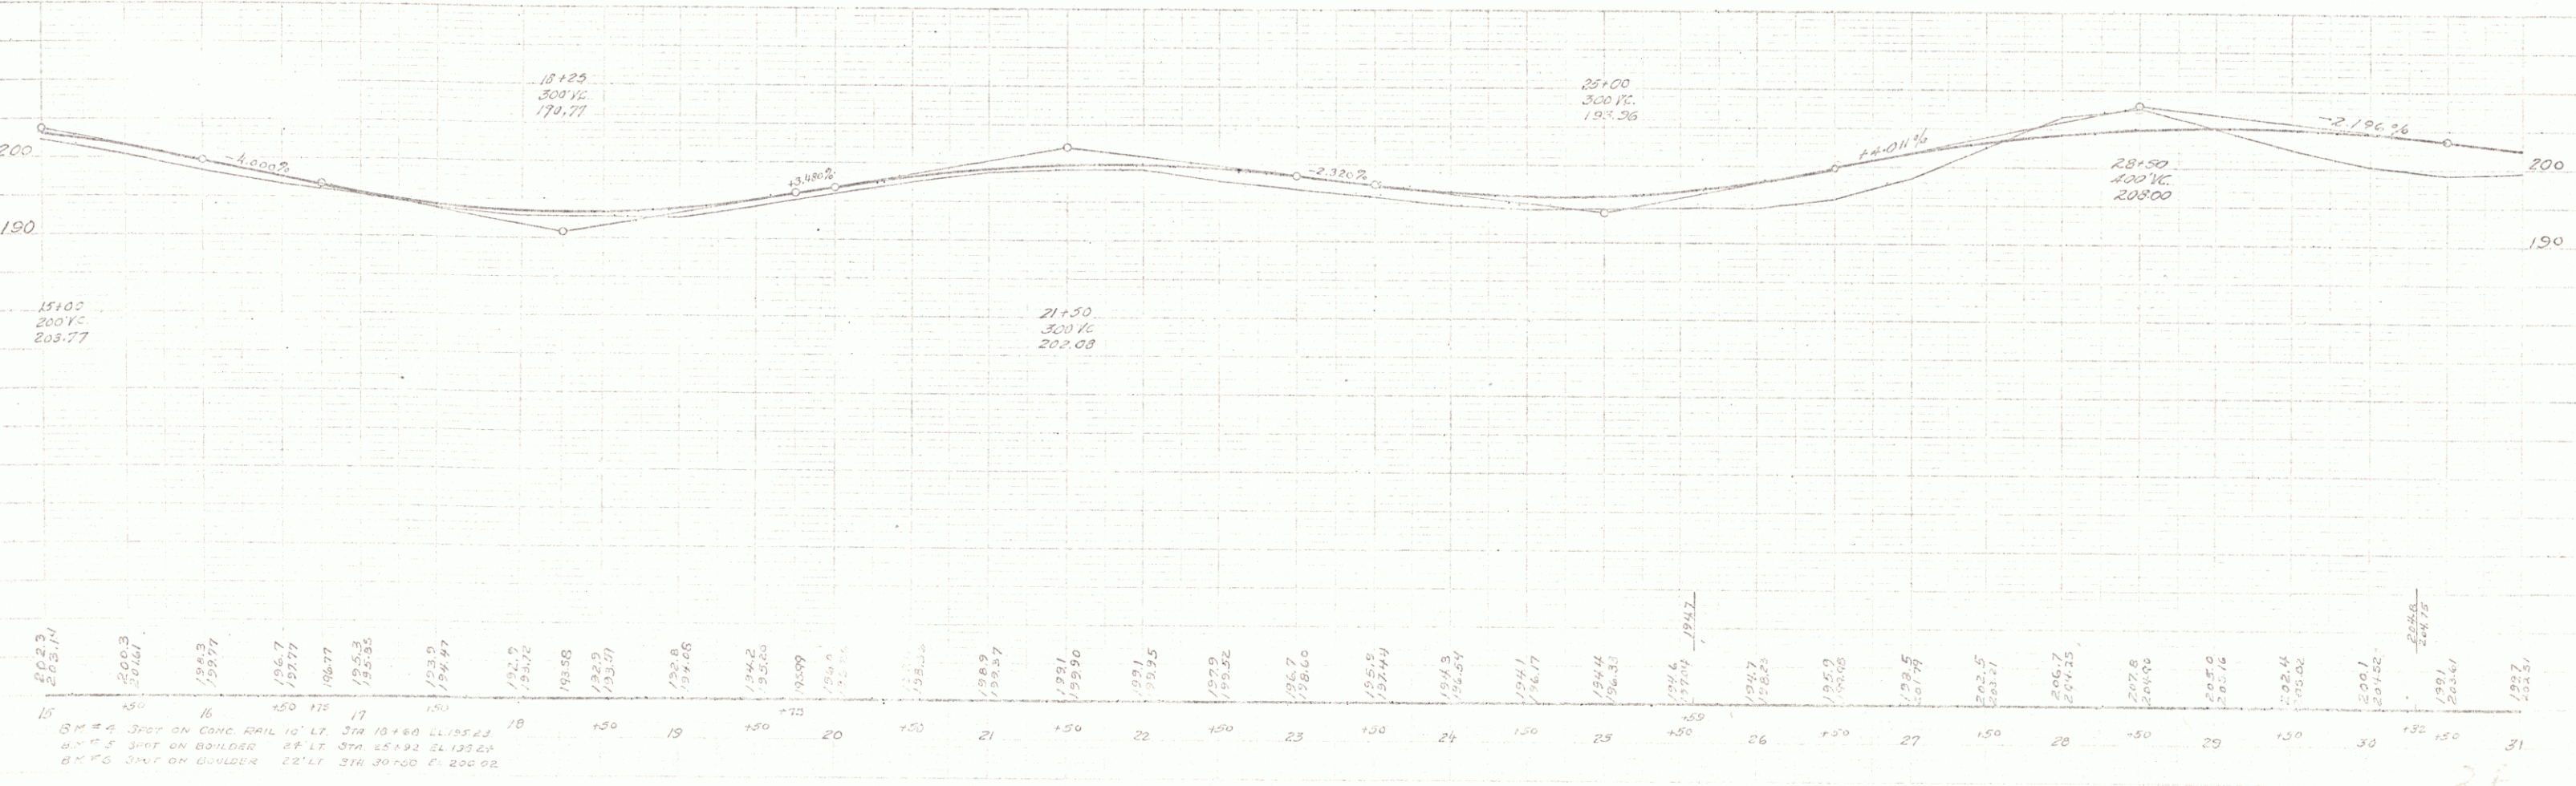


PLN
 DATE
 DRAWN
 CHECKED
 7-29-08

15102
 200 YC
 203.77

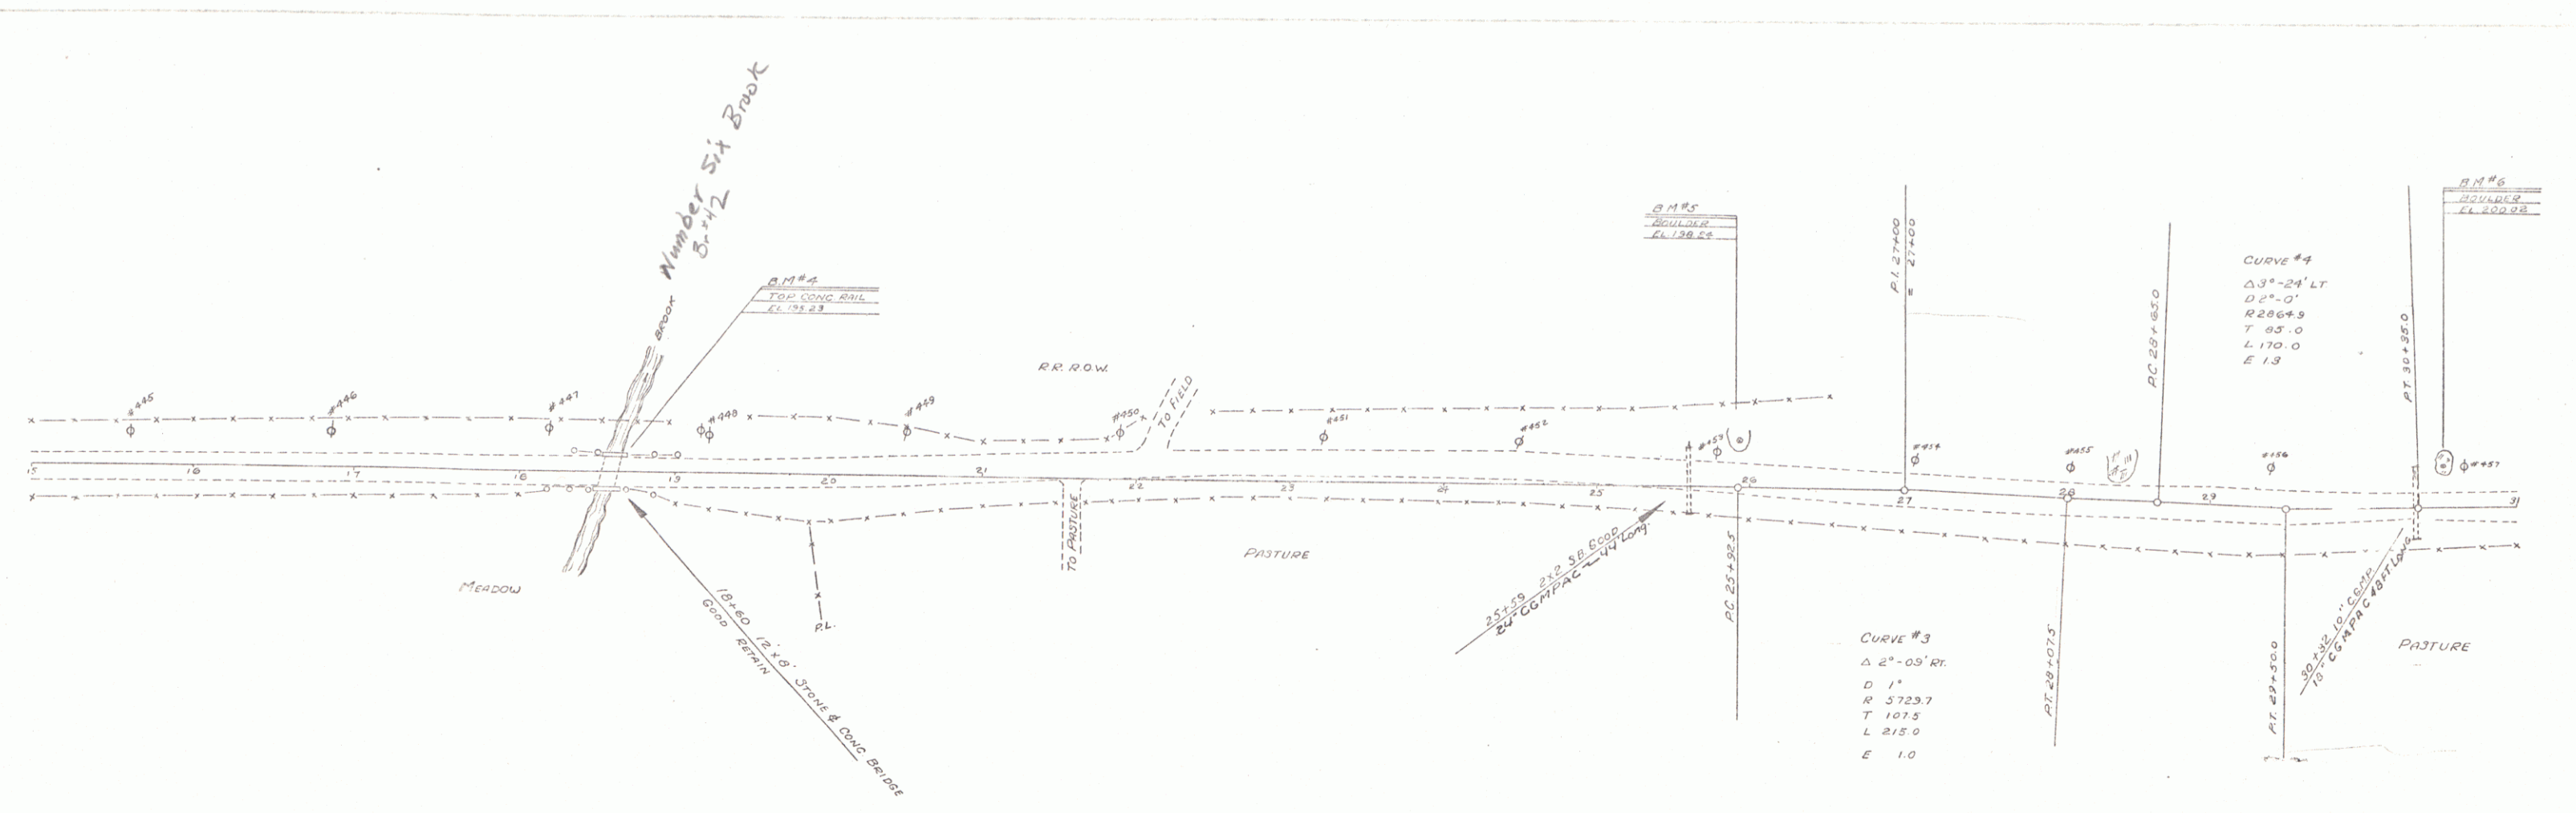

15	15+00	15102	200 YC	203.77
16	15+25	196.3		
17	15+50	196.7		
18	16+00	195.3		
19	16+25	193.5		
20	16+50	192.2		
21	17+00	191.9		
22	17+25	191.7		
23	17+50	191.7		
24	18+00	191.7		
25	18+25	191.7		
26	18+50	191.7		
27	19+00	191.7		
28	19+25	191.7		
29	19+50	191.7		
30	20+00	191.7		
31	20+25	191.7		

NORTH BOLLER CORNER HIGHWAY
 SHEET 2