
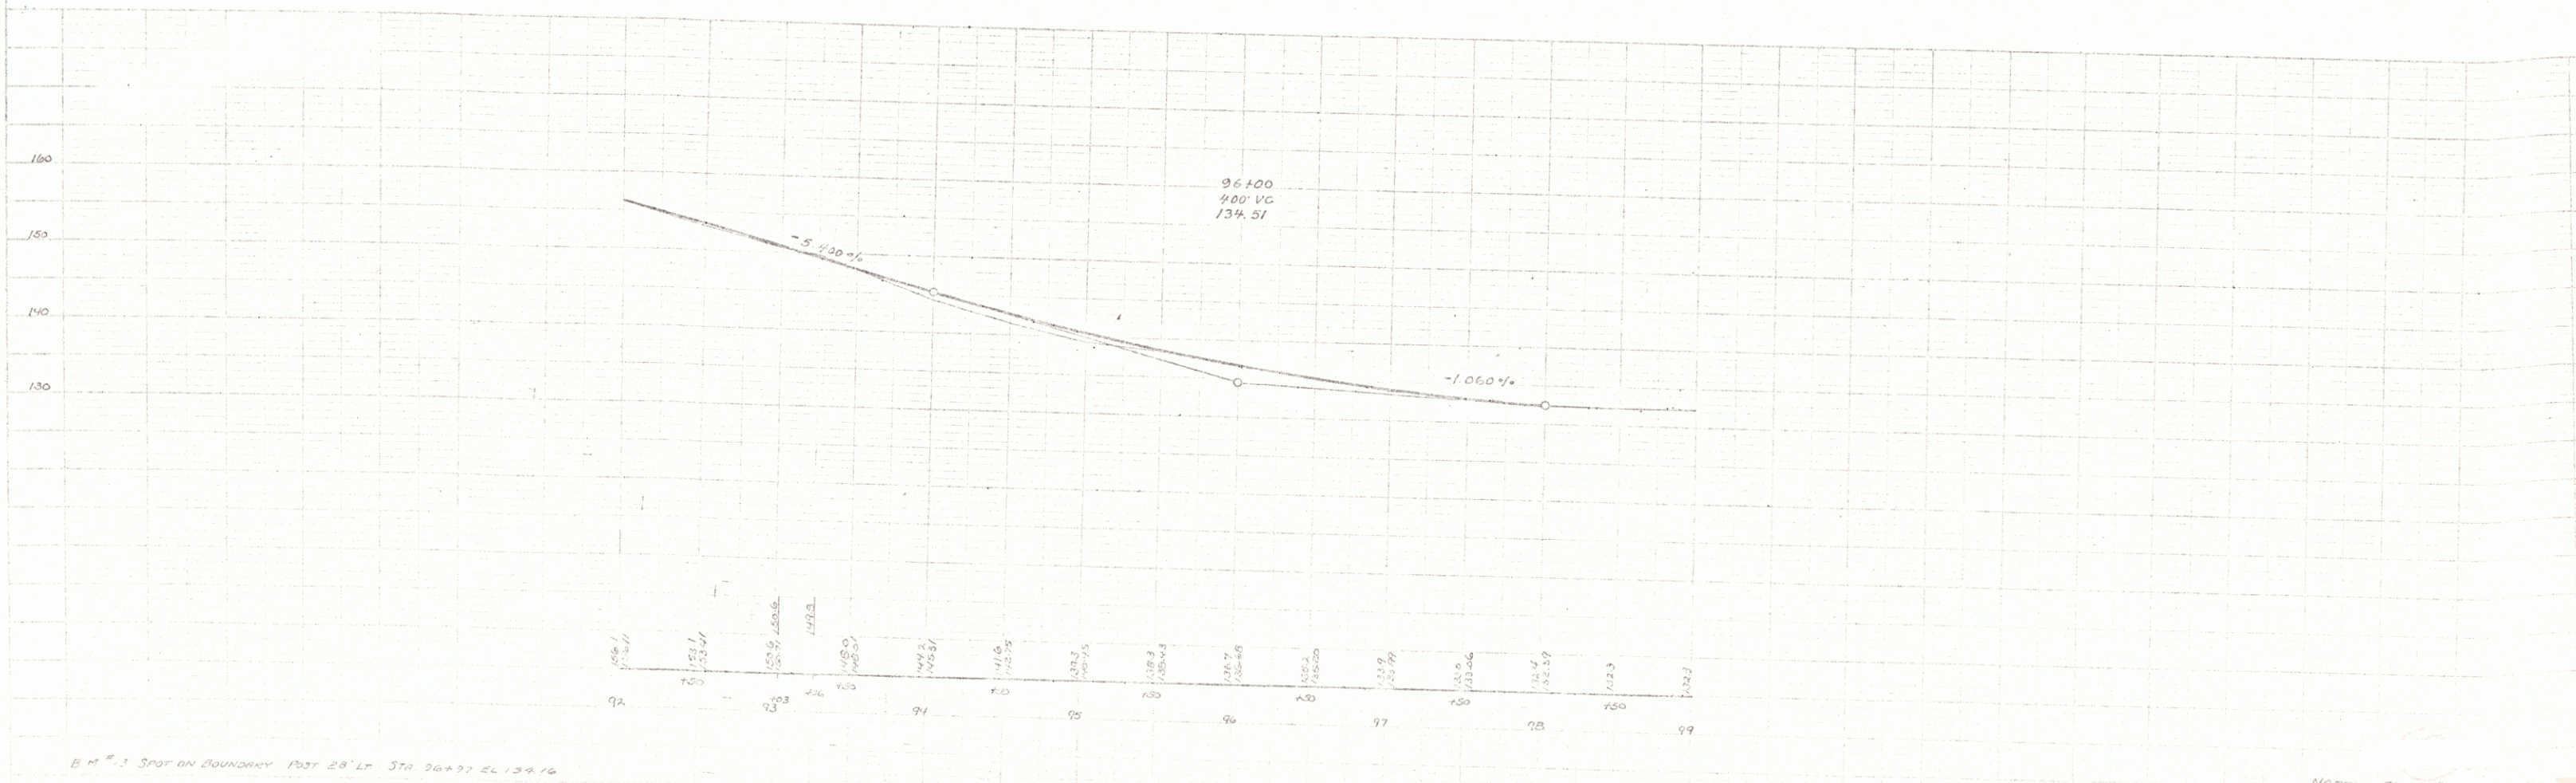


PLAN
 DATE: 7-20-28
 DRAWN BY: PUTNAM
 CHECKED BY: CLARK
 PROJECT NO.: 8-1-28

PLAN
 DATE: 7-20-28
 DRAWN BY: PUTNAM
 CHECKED BY: CLARK
 PROJECT NO.: 8-1-28

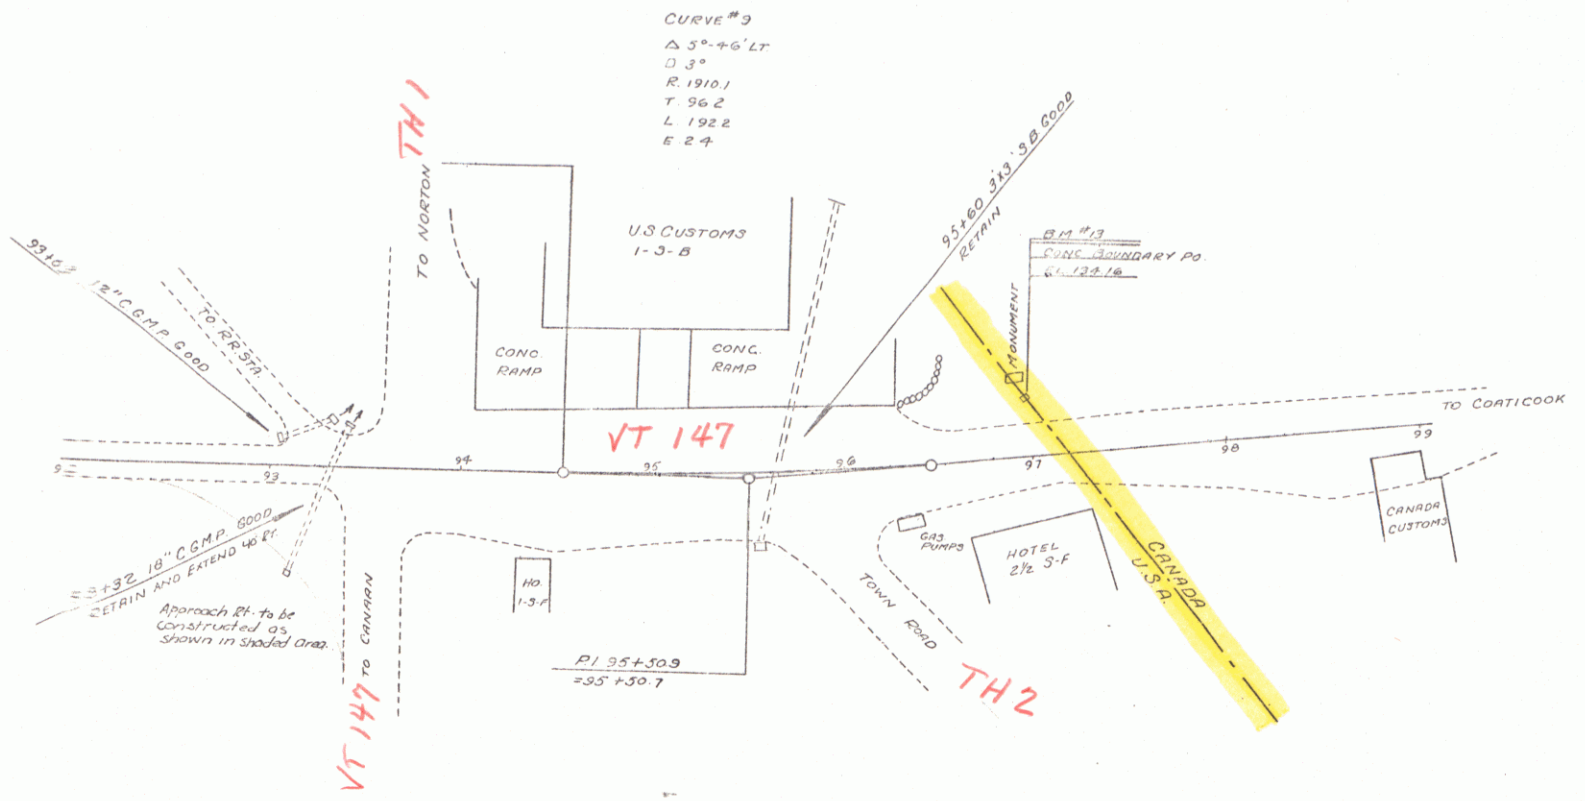

B.M. #3 SPOT ON BOUNDARY POST 20' LT. STA. 26+97 EL. 124.16