

INDEX OF SHEETS

- 1 TITLE PAGE
- 2 TYPICAL CROSS-SECTION OF IMPROVEMENT (2 1/2" BLENDED GRAVEL MIXED-IN-PLACE SURFACE COURSE WITH REFINED TAR, ITEM 3-4)
- 3 BANKING AND WIDENING TABLES
- 4 QUANTITY SHEET - ITEMS
- 5 QUANTITY SHEET - DRAINAGE
- 6-13 EARTHWORK SHEETS
- 14-26 PLAN AND PROFILE
- 27 STANDARD STRUCTURE SHEET S-40 BARRICADES, SIGNS & LIGHTS
- 28 " " " S-41 ROUNDING OF SLOPES
- 29 " " " S-46-45 MARKERS
- 30 " " " S-47-45 PIPE CULVERTS
- 31-56 CROSS SECTIONS

STANDARD STRUCTURE SHEETS APPROVED BY THE CHIEF ENGINEER, VERMONT STATE DEPARTMENT OF HIGHWAYS.

S-40 FEB. 28, 1949
 S-46-45 FEB. 28, 1949
 S-47-45 FEB. 28, 1949

STATE OF VERMONT
 STATE HIGHWAY DEPARTMENT

PLAN AND PROFILE OF PROPOSED
 STATE HIGHWAY


TOWN OF NORTON
 COUNTY OF ESSEX
 NORTON CANAAN ROAD
 VERMONT ROUTE 114

Pin# 00R465

BEGINNING AT A POINT APPROXIMATELY 700.0 FEET SOUTHERLY OF THE U.S. CUSTOMS BUILDING AND EXTENDING EASTERLY 16,098.0 FEET
 LENGTH OF PROJECT 16,098.0 FEET = 3.049 MILES

FED. ROAD DIST. NO.	STATE	PROJ. NO.	FISCAL YEAR	SHEET NO.	TOTAL SHEETS
9	VT.	209(1)		1	56


POST WAR SECONDARY

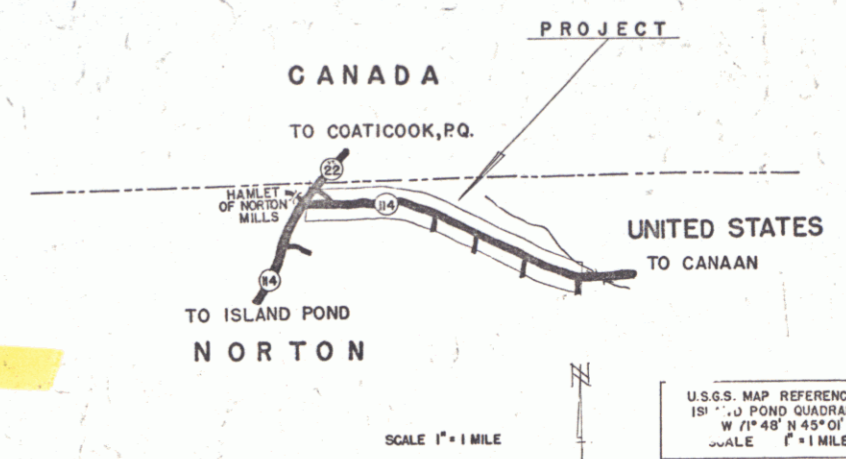

PROJECT NAME AND NUMBER	TYPE	PAVEMENT AREA
NORTON	CR. GRAVEL MIX SURFACE ON TAR	35,773 S.Y.
RECORD PLANS		
MATERIALS		
CEMENT PORTLAND CEMENT	LONE STAR	GRAVEL FROM CANADA
SAND	CORKINS PIT	C.R.M. FROM PROJECT
STONE	CORKINS PIT	
TAR	DAILEY CO. (COLD COLONY) MONTELLIER, VERMONT	
R.C.P.	VERMONT CONC. PIPE MONTELLIER, VERMONT	
A.C.C.M.P.	N.E. METAL CULVERT CO.	
CONTRACTOR	W.E. DAILEY	CONTRACT DATED SEPT. 13, 1949
RESIDENT ENGR.	P. Z. BUNLEY	CONTRACT STARTED SEPT. 13, 1949
INSPECTOR		CONTRACT COMPLETED AUG. 1, 1951
RECORD PLANS	30' B.P.R. ZONE	CONTRACT ACCEPTED AUG. 2, 1951

ANY FURTHER INFORMATION CONCERNING FINAL QUANTITIES AMOUNTS OR OTHER DETAILS RELATIVE TO THIS PROJECT MAY BE FOUND IN EITHER THE FIELD BOOKS OR THE ESTIMATE FILE.

Norton '81

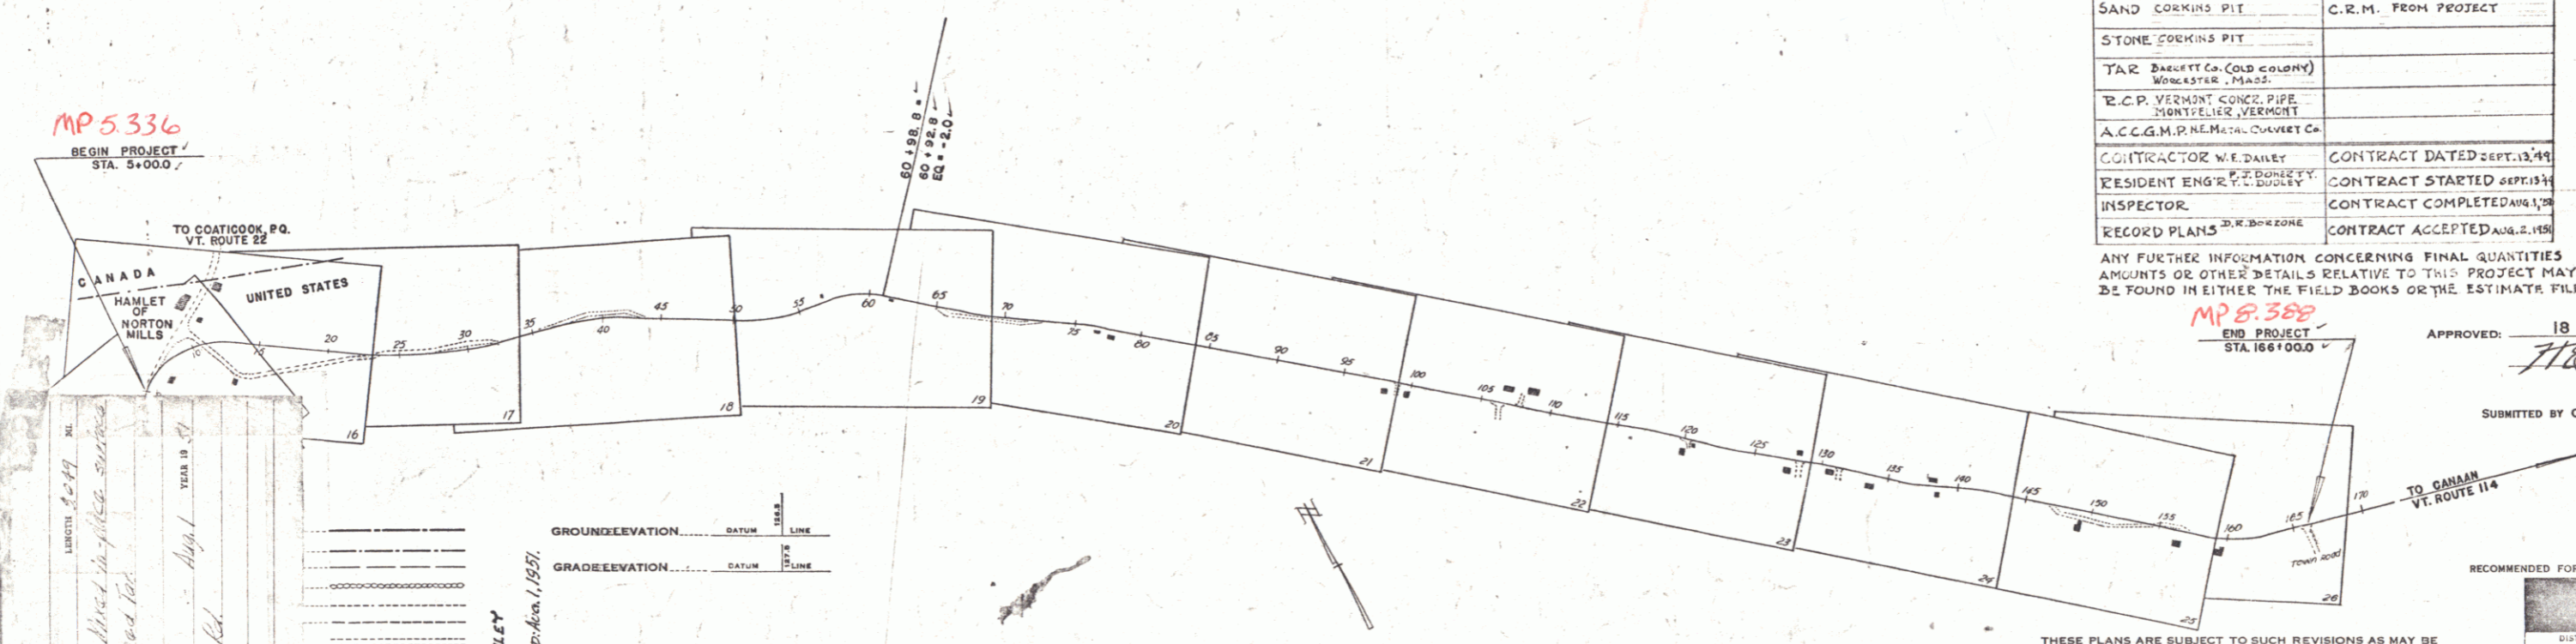

CURVE DATA

DEFLECTION ANGLE	Δ
DEGREE OF CURVE	D
RADIUS OF CURVE	R
TANGENT DISTANCE	T
LENGTH OF CURVE	L
EXTERNAL DISTANCE	E
POINT OF INTERSECTION	P. I.
POINT OF CURVE	P. C.
POINT OF TANGENT	P. T.
POINT OF TANGENT	P. O. T.

SCALES

TITLE	1" = 600'
TYPICAL	1" = 2'
PLAN	1" = 50'
PROFILE HORIZONTAL	1" = 50'
PROFILE VERTICAL	1" = 10'
CROSS SECTIONS	1" = 5'

MP 5.336
 BEGIN PROJECT STA. 5+00.0

TO COATICOOK P.O. VT. ROUTE 22

CANADA
 HAMLET OF NORTON MILLS
 UNITED STATES

TO ISLAND POND
 NORTON

TO CANAAN
 VT. ROUTE 114

CONTRACTOR: W.E. DAILEY
 NORTON-CANAAN RD.
 NORTON, VT.

APPROVED: 18 MARCH, 1949
H. August
 COMMISSIONER OF HIGHWAYS

RIGHT-OF-WAY DIVISION
 TOWN FILE
 PERPETUAL
 Town of Norton
 (To Be Returned To R.O.W. Division)

APPROVED: MAR. 30, 1949
 DISTRICT HIGHWAY COMMISSIONER

SERIES 3 No. 209(1) FILED
 SHEET 1 OF 56