
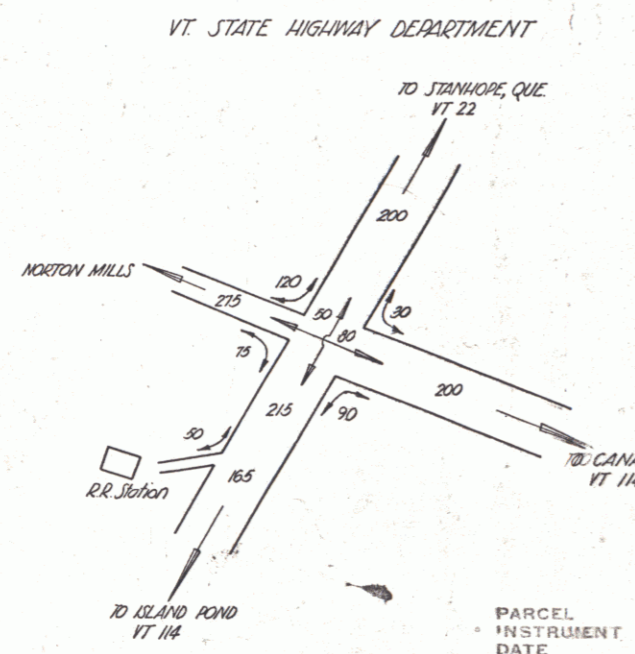


FED. ROAD DIST. NO.	STATE	PROJ. NO.	FISCAL YEAR	SHEET NO.	TOTAL SHEETS
9	VT.	209(1)		14	5

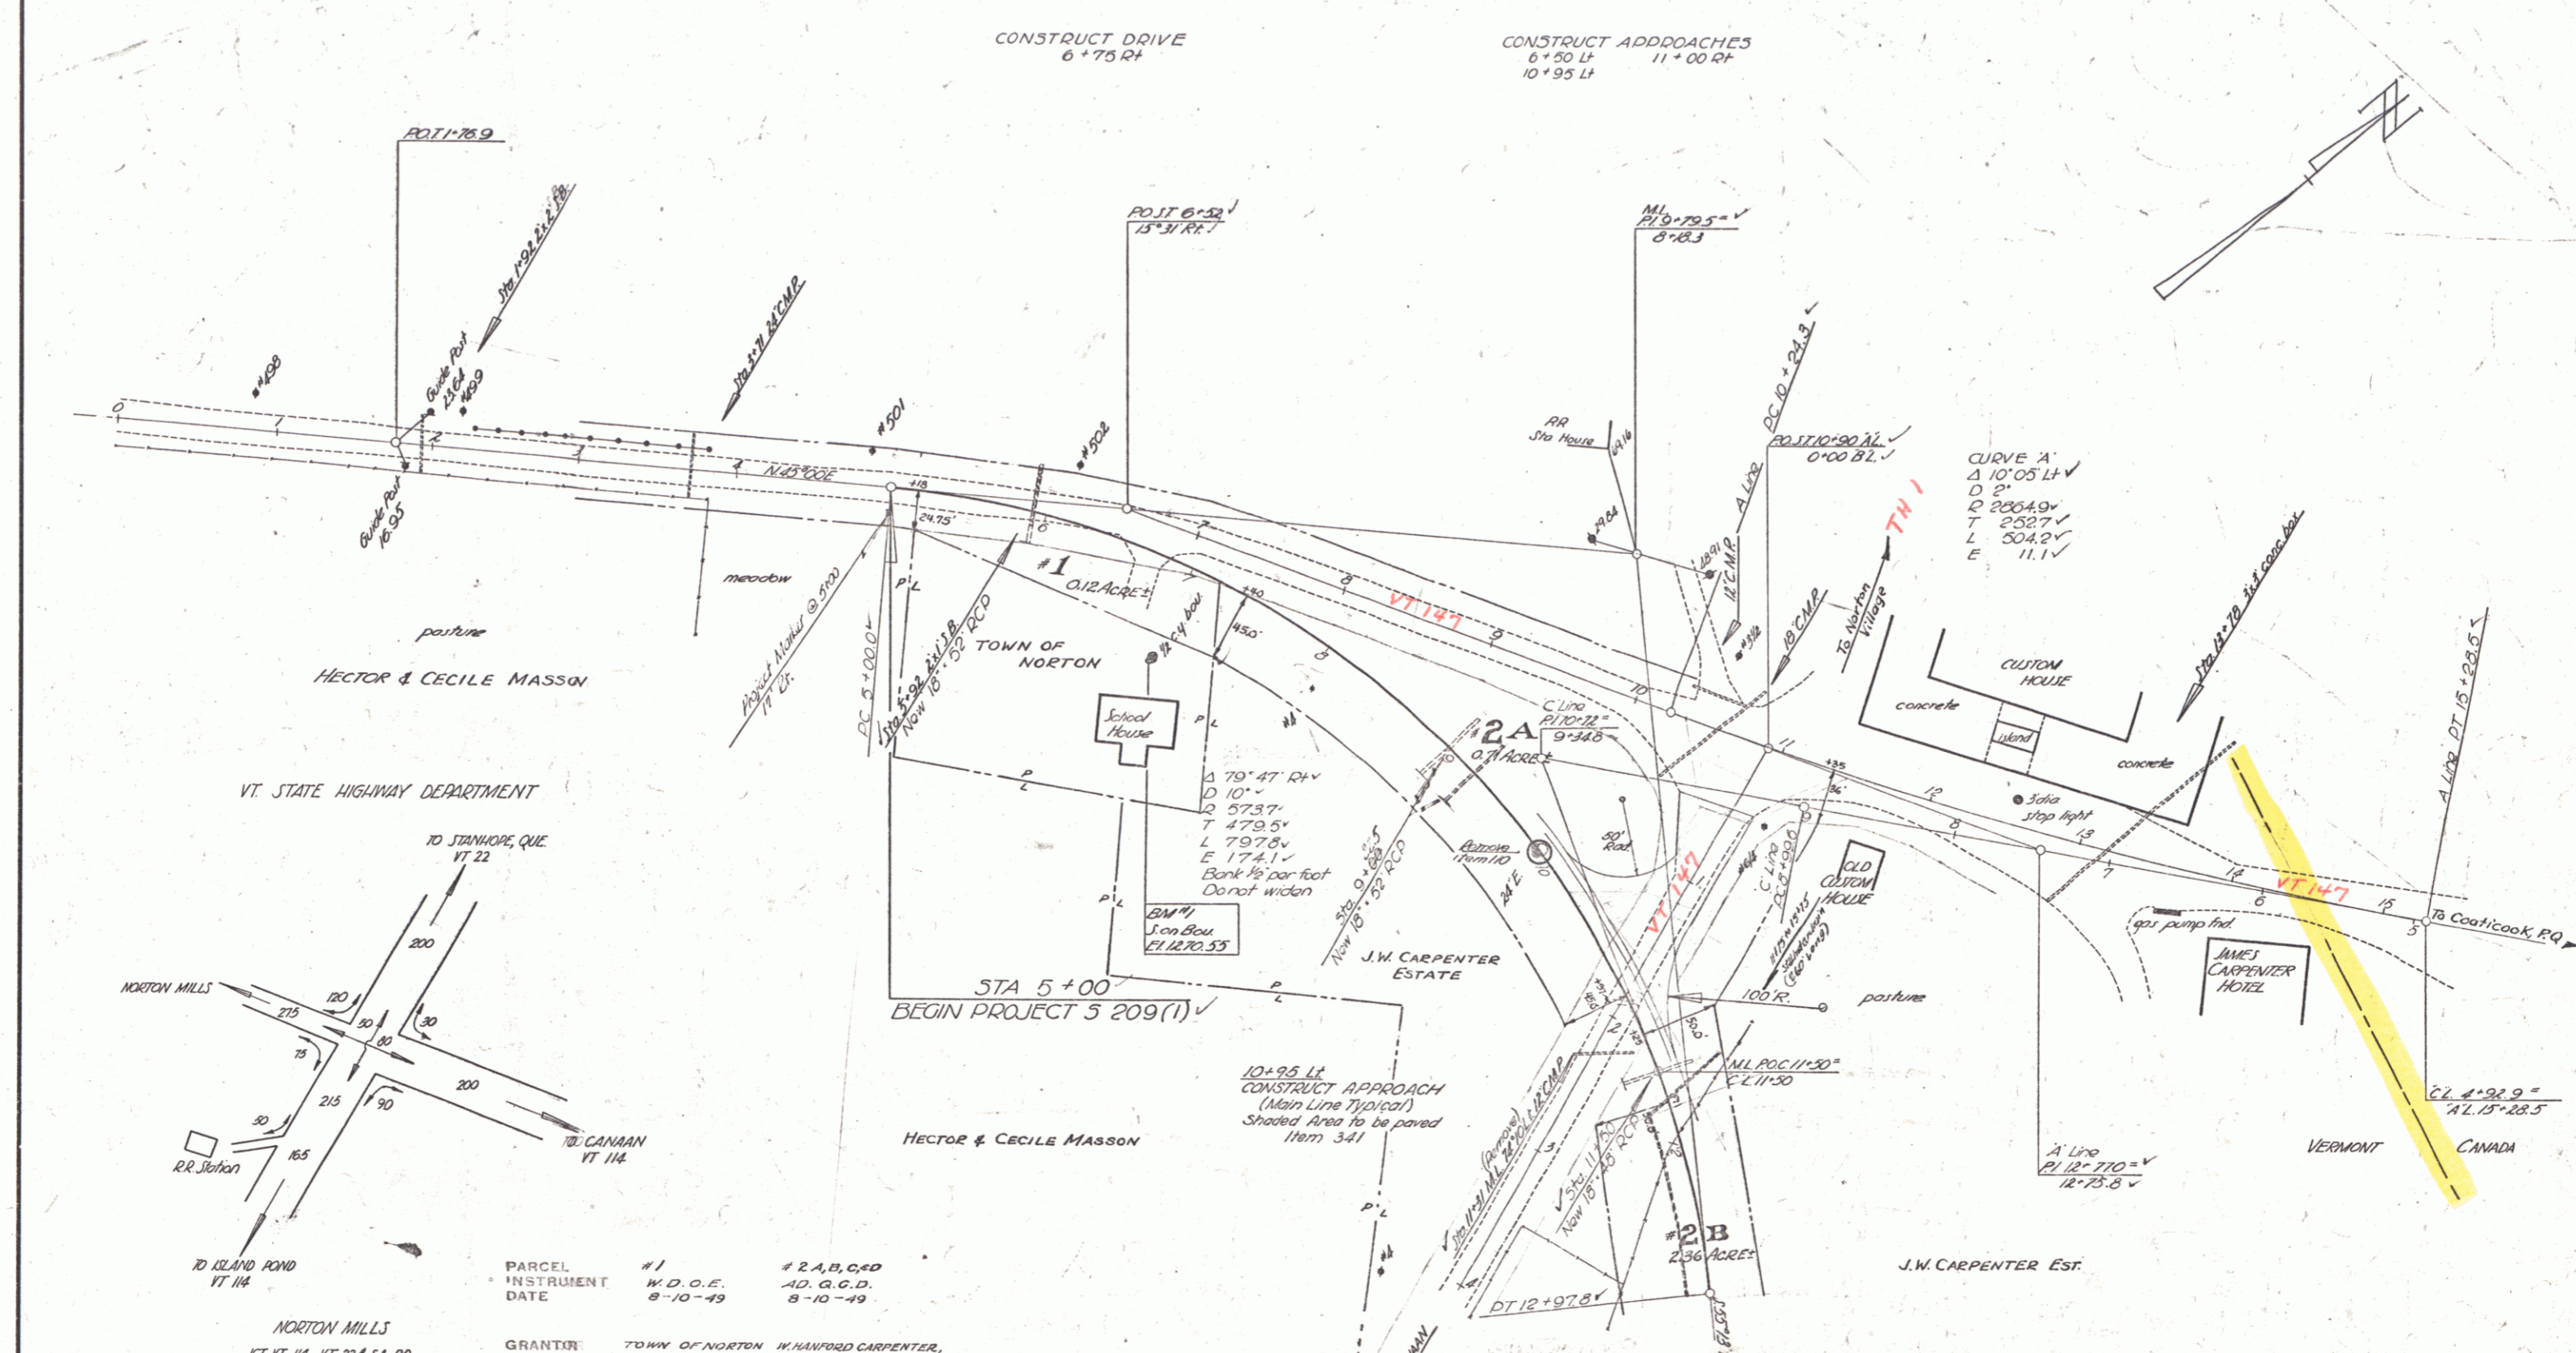

PARCEL #	INSTRUMENT NO.	DATE	GRANTOR	GRANTEE
#1	W.D.O.E.	8-10-49	TOWN OF NORTON	ST. OF VT.
#2, A, B, C, D	A.D. G.G.D.	8-10-49	W. HANFORD CARPENTER, ADM. OF J.W. CARPENTER EST.	ST. OF VT.
	NORTON		NORTON	
	101-02	8-22-49		

WOOD CURVE DATA	STA.	TA.	LA	EA
342	101.14	19	1	1
9420	101.14	19	1	1
9466	101.14	19	1	1
1015	101.14	19	1	1
10128	101.14	19	1	1
11750	101.14	19	1	1
11750	101.14	19	1	1

NORTON

Surveyed by Lavin
 Designed by R. Darling
 Traced by M.L. Stevens Jr.
 Checked by
 Series 5 No. 209(1) Filed
 Sheet (14) of 56 Sheets