
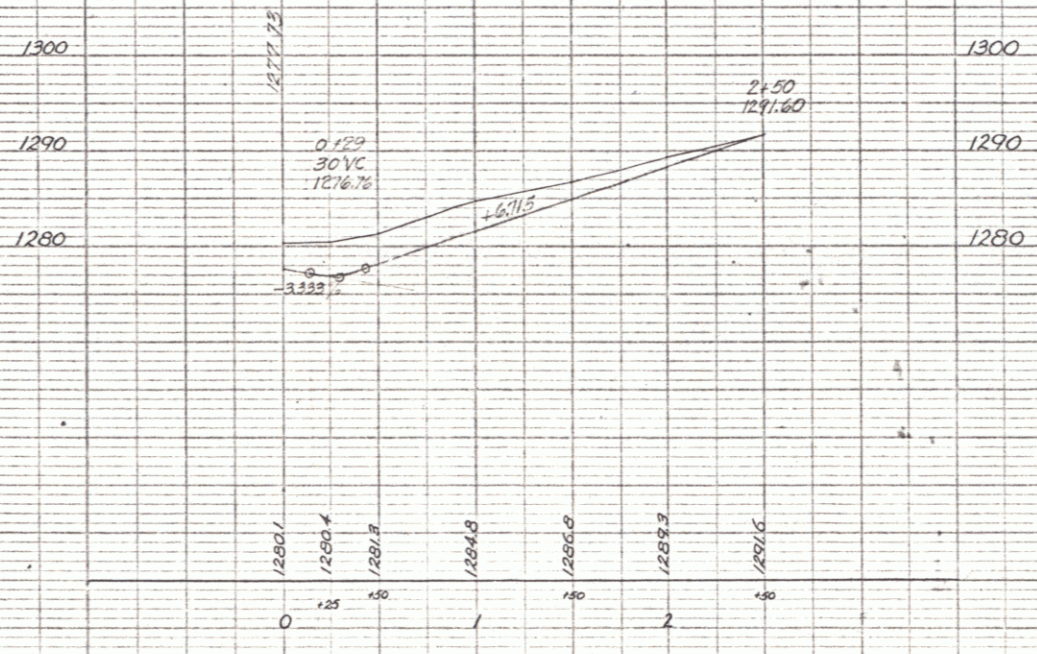


PLAN
 DRAWING NO. 10
 DATE 6/28/41
 DRAWN BY D. W. HARRIS
 CHECKED BY J. W. HARRIS

PROFILE
 DRAWING NO. 10
 DATE 6/28/41
 DRAWN BY D. W. HARRIS
 CHECKED BY J. W. HARRIS

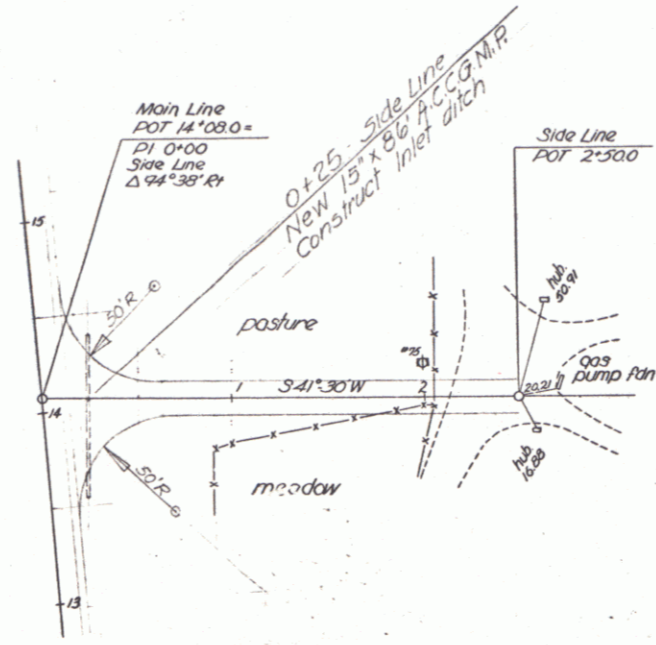

Norton
 Side Line At 14'08.0 R.L.
 Series S No. 209(1)
 SHEET 16A