


PLAN  
DATE  
SCALE  
BY  
CHECKED  
APPROVED

WOOD CURVE	1/2" = 100'
30' BS	1/2" = 100'
30' BS	1/2" = 100'
30' BS	1/2" = 100'

PARCEL INSTRUMENT DATE  
GRANTOR GRANTEE  
RECORDED BOOK PAGE DATE  
REMARKS

CONTRACTED LEVEL	24	24
30' BS	24	24
30' BS	24	24

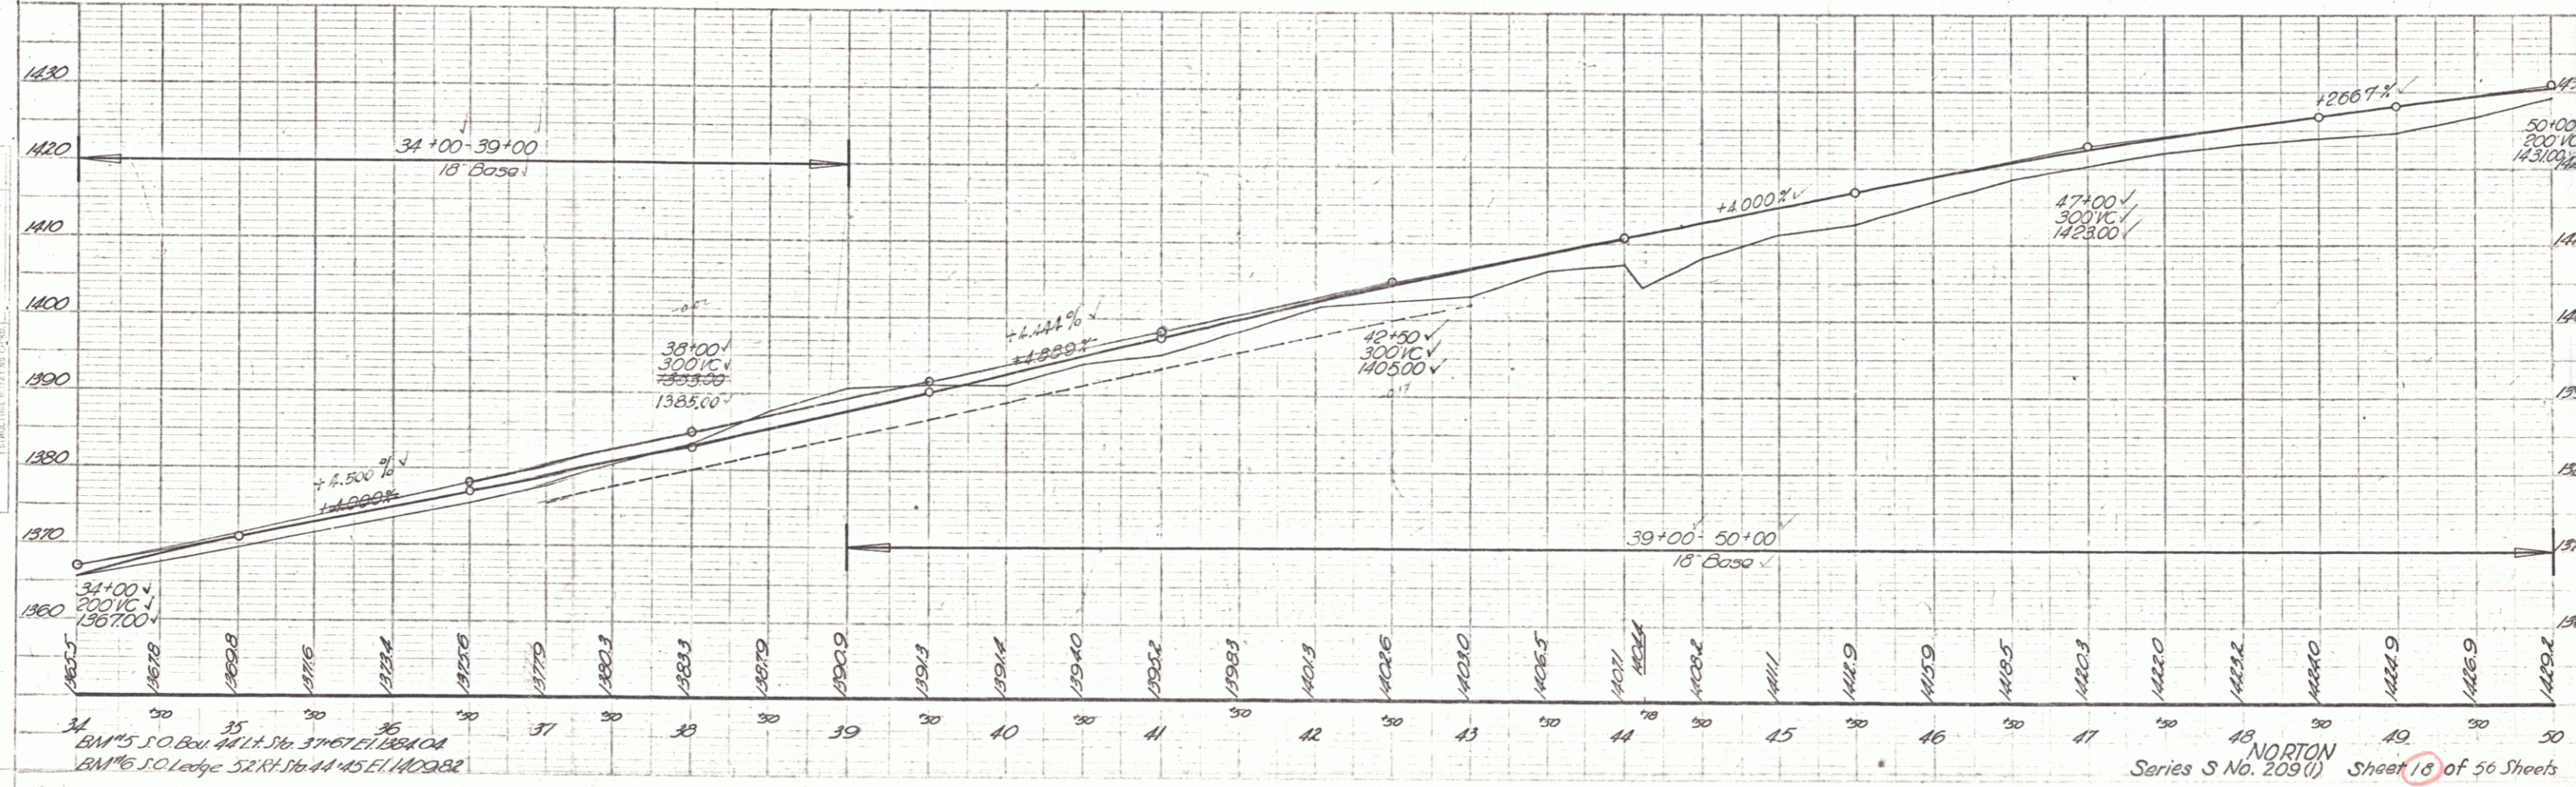

PROFILE  
DATE  
SCALE  
BY  
CHECKED  
APPROVED

BM 15 S.O. BOU 44 1/4 Sta 3167.11 1381.04  
BM 16 S.O. Ledgs 52 Rt 16 1/4 Sta 445 EL 1402.82