


PLAN
 DATE BOOK: 1/20/49
 PLATTED: 2/20/49
 CHECKED: ALLI, J.
 NO. 100000

PROFILE
 DATE BOOK: 1/20/49
 PLATTED: 2/20/49
 CHECKED: ALLI, J.
 NO. 100000

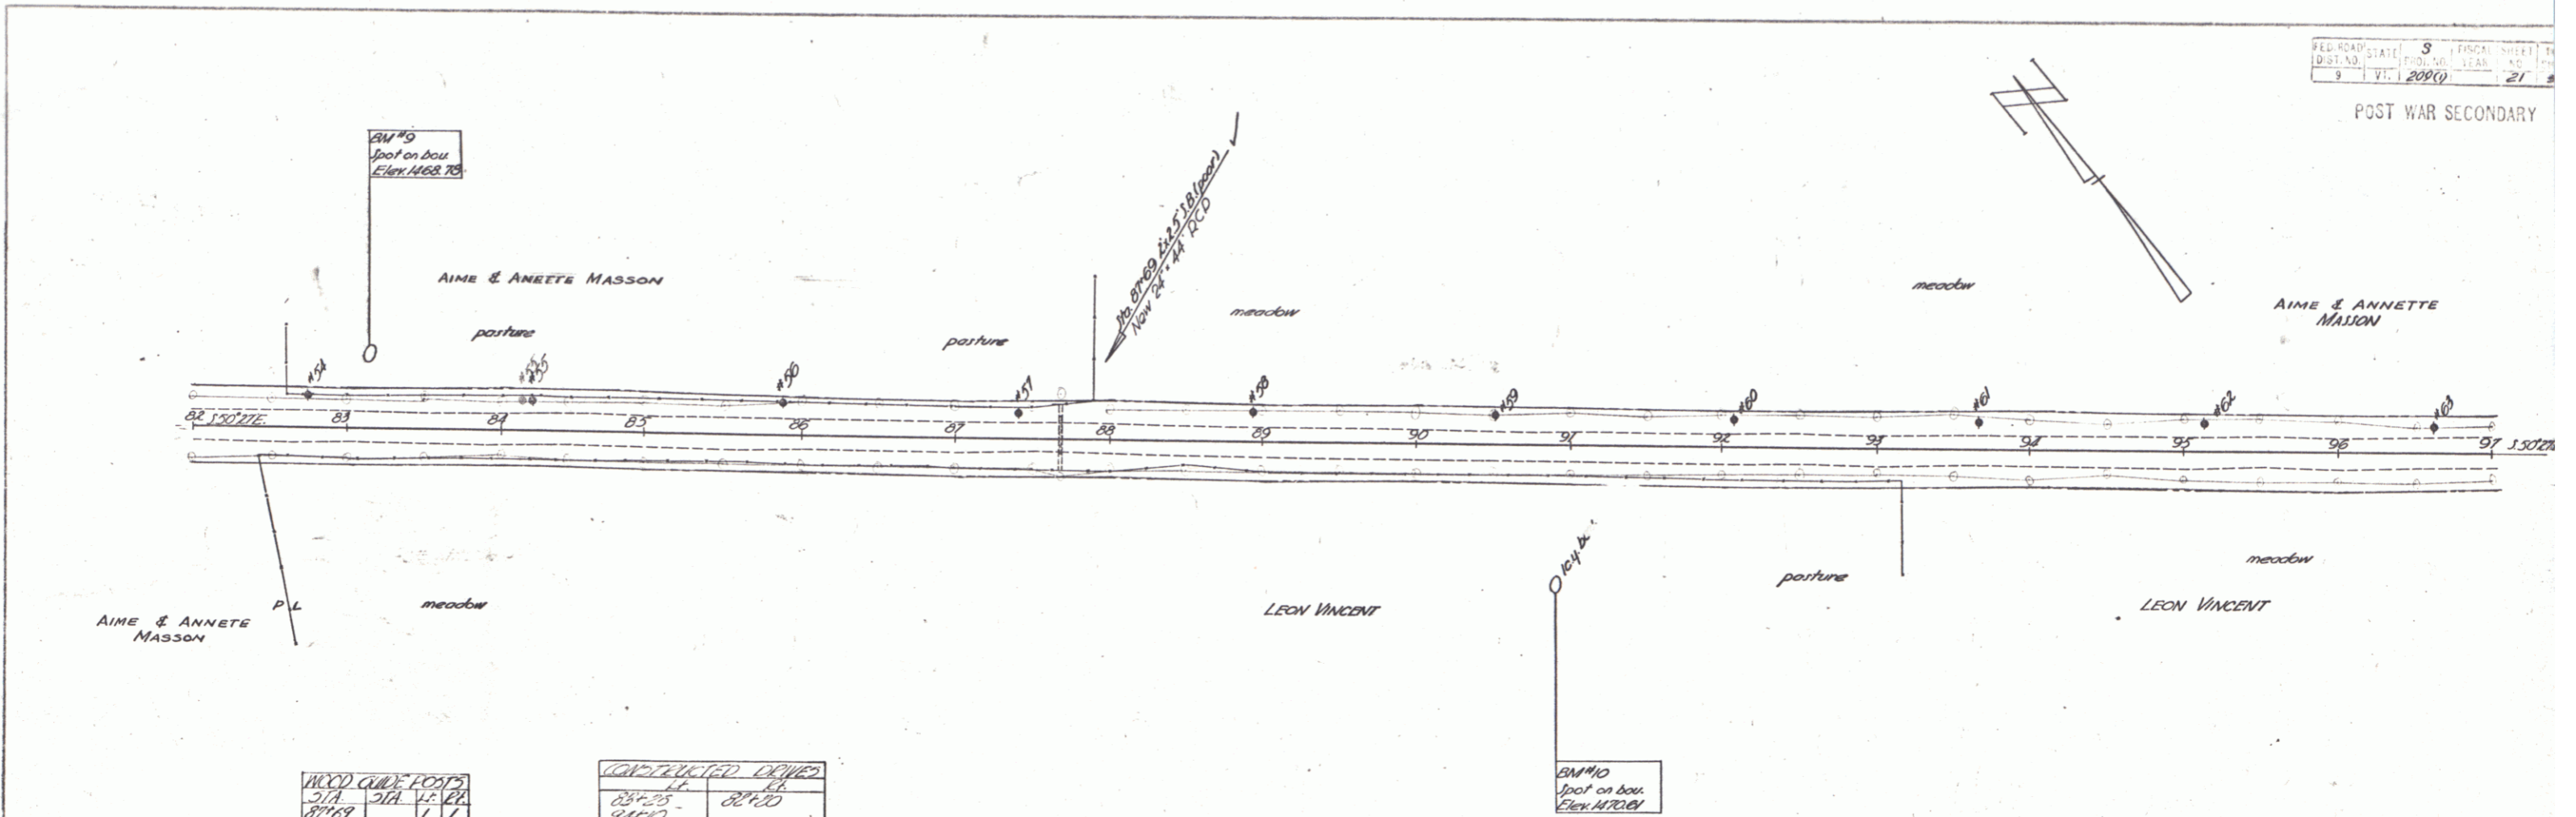


ALCOD CURVE POSTS

STA	1/2 P.C.	P.C.
82+75	83+12.5	83+50

CON-TOUCHED CURVES

STA	1/2 P.C.	P.C.
88+25	88+50	88+75

BM#10
 Spot on box
 Elev. 1472.61

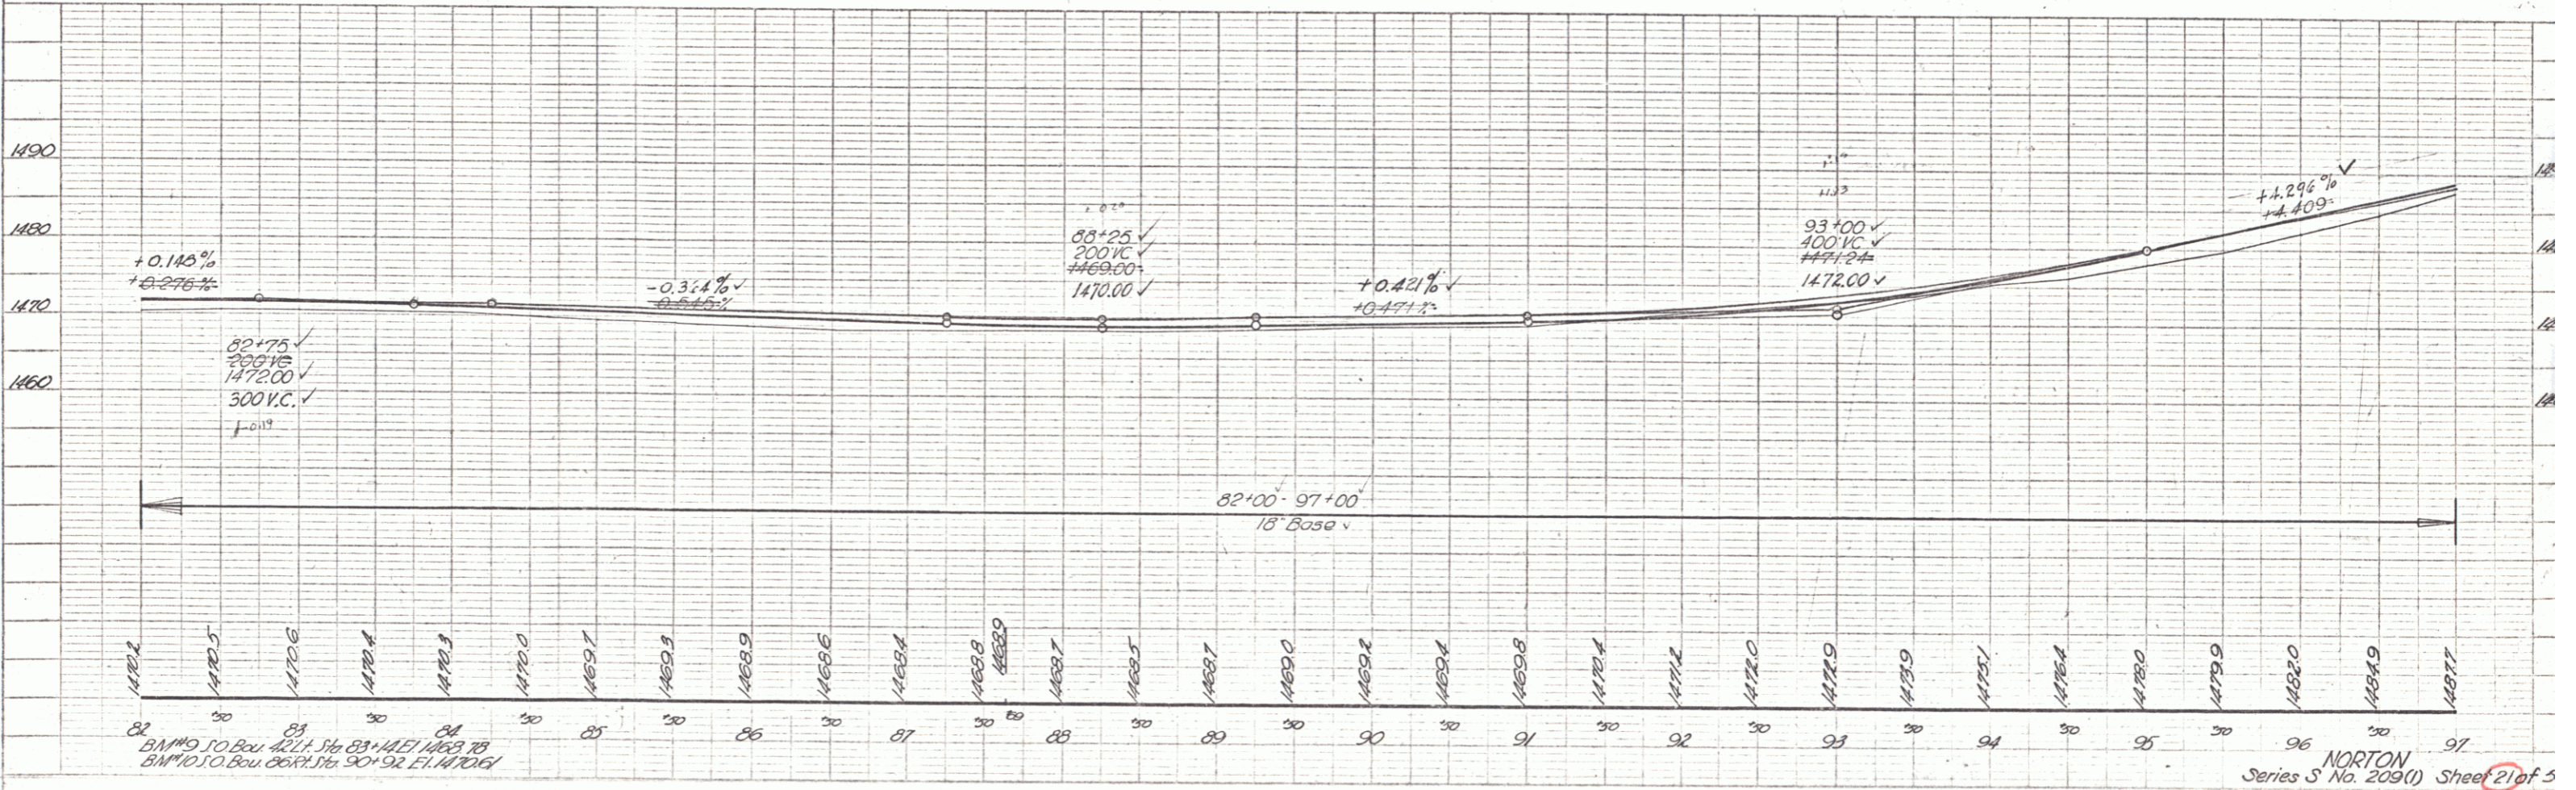

1/20/49