
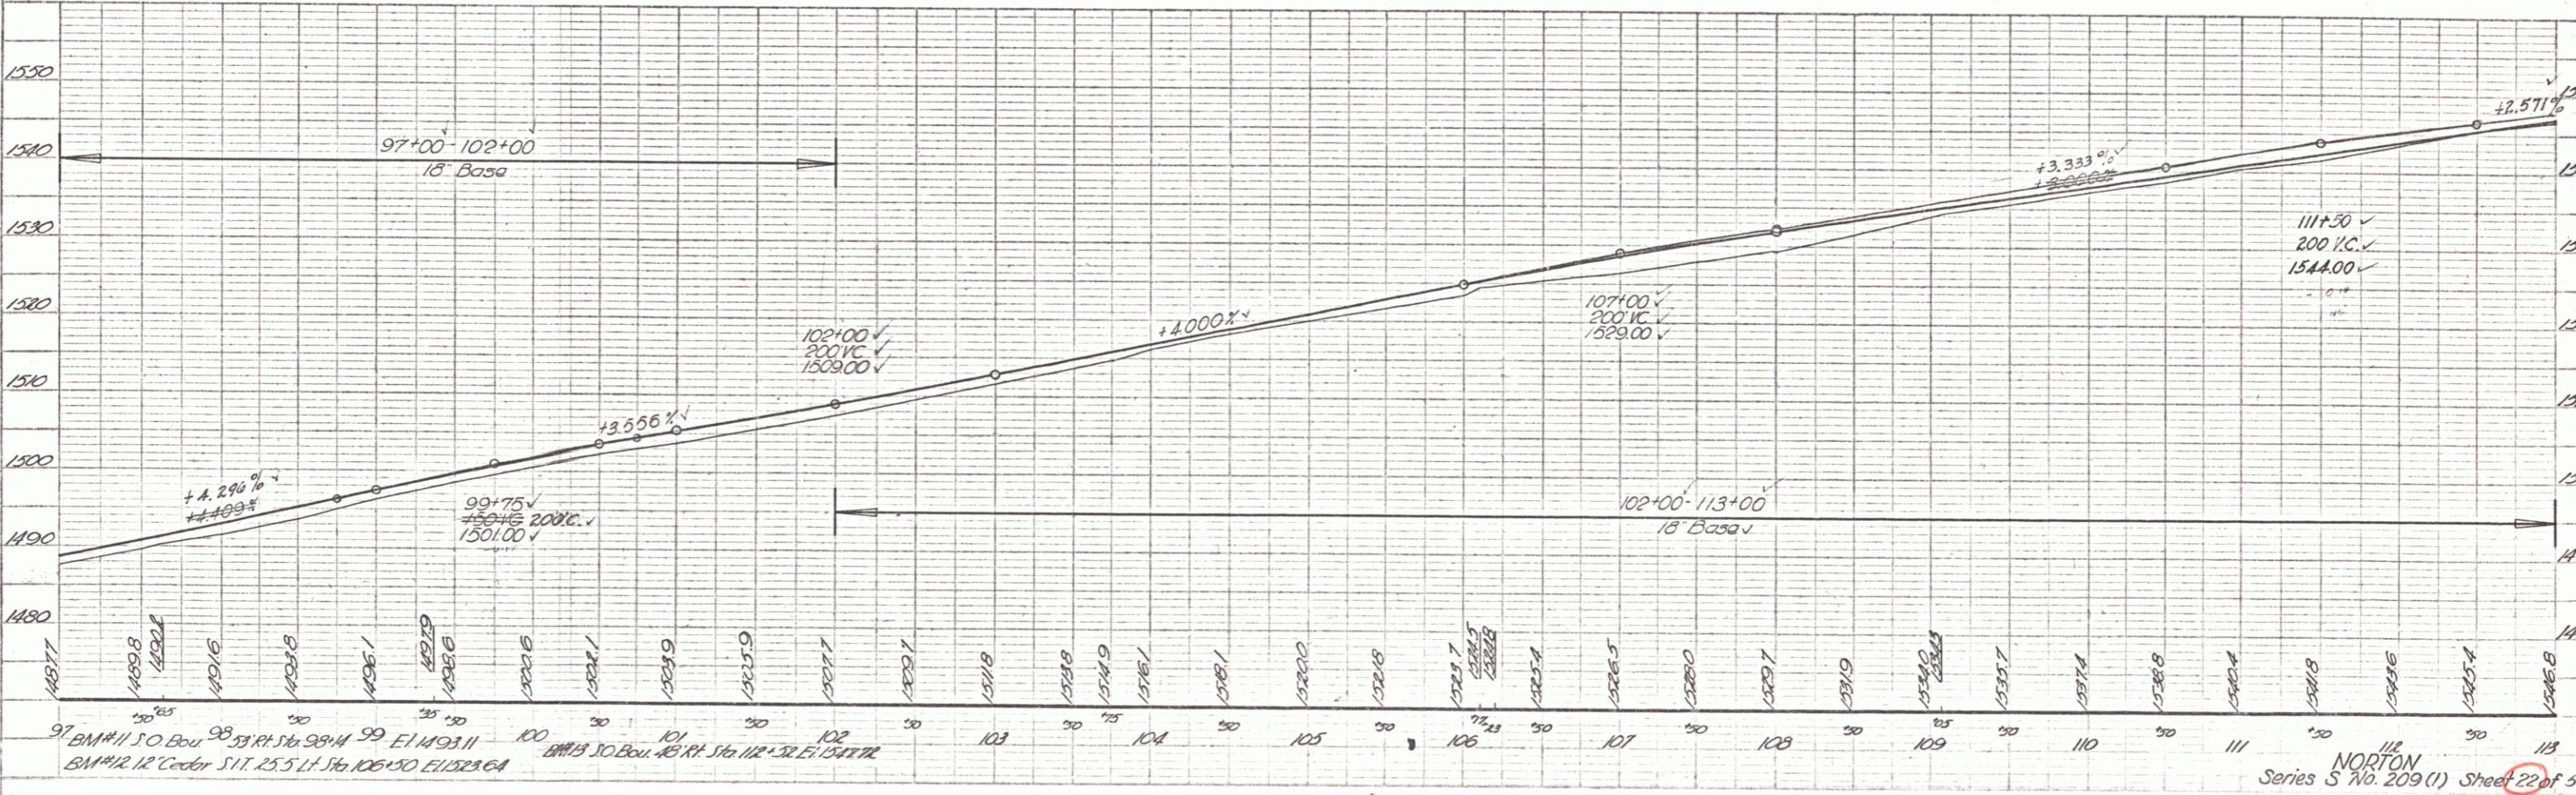


PLAN
 DRAWN BY
 CHECKED BY
 DATE
 8-46
 9-49

PROFILE
 DRAWN BY
 CHECKED BY
 DATE
 8-46
 9-49

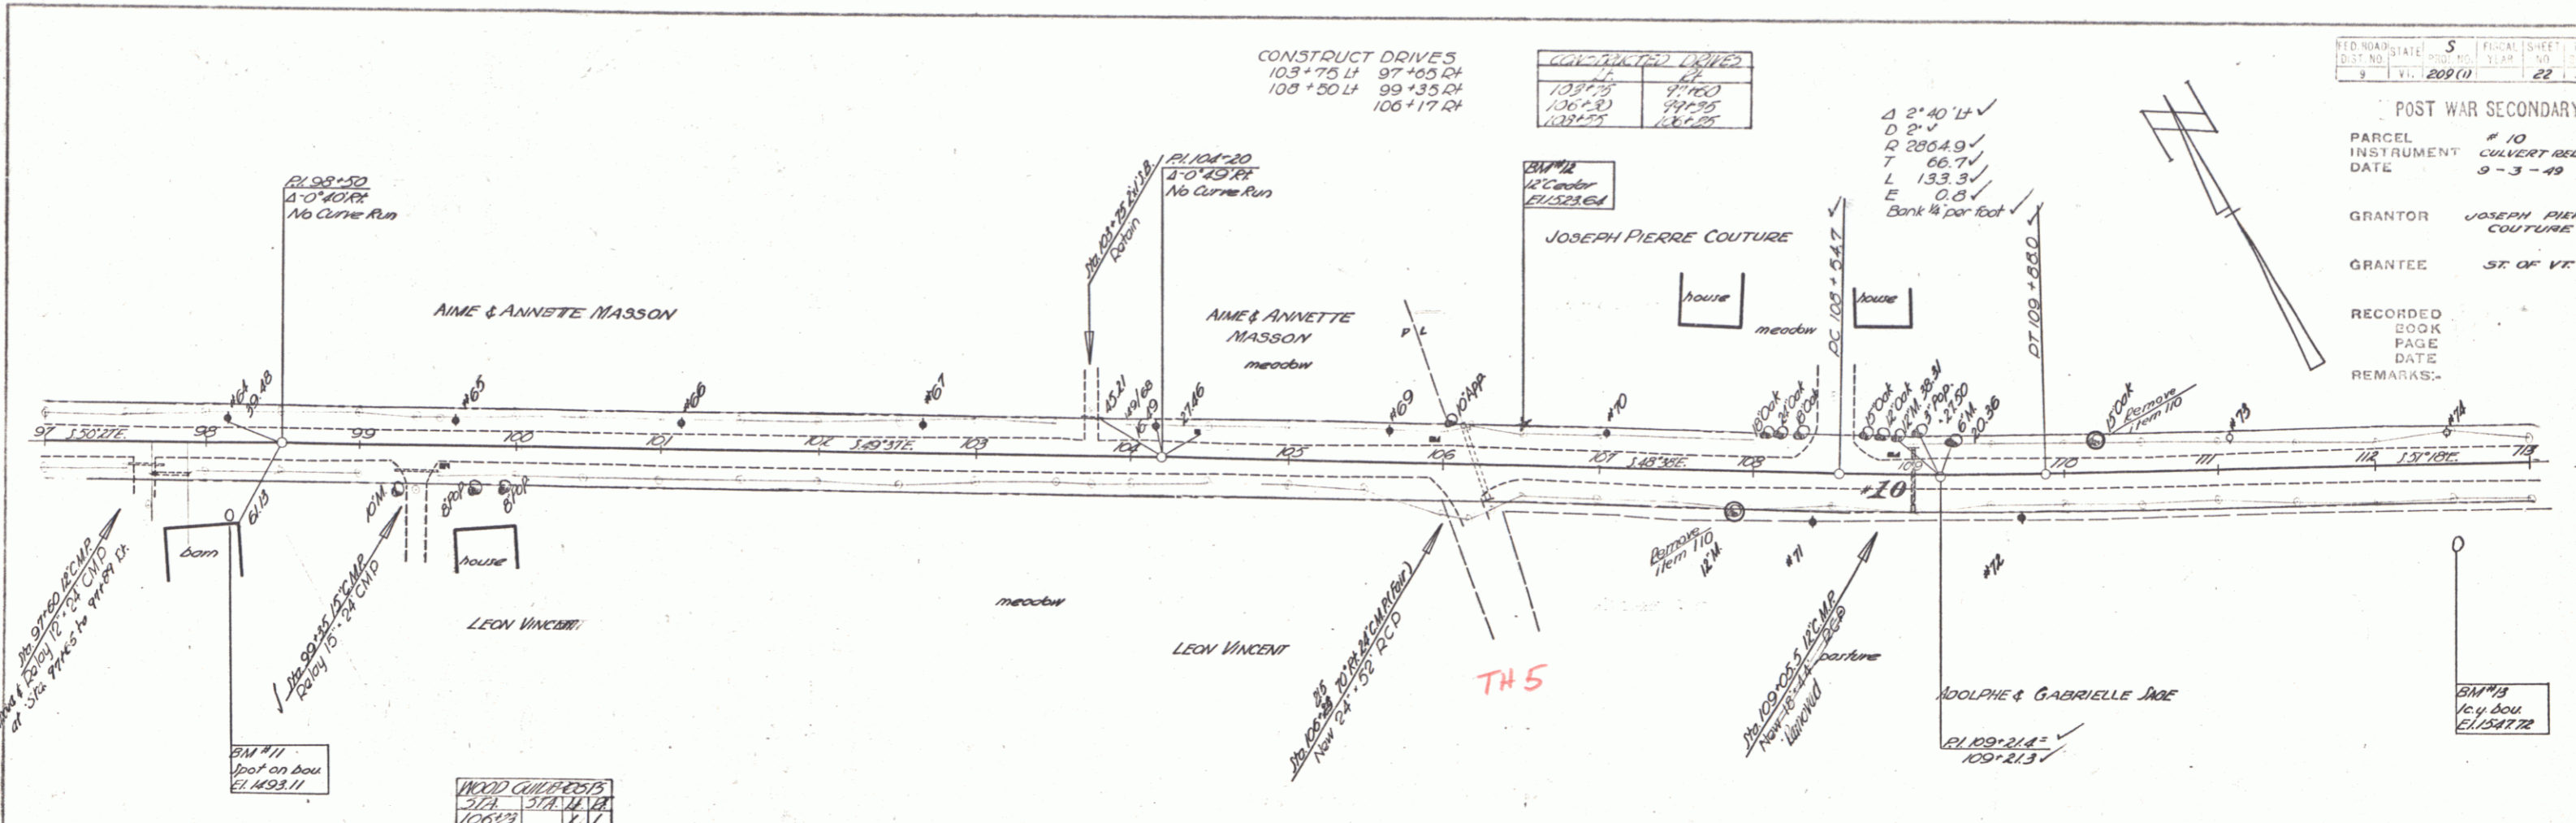

CONSTRUCT DRIVES
 103+75 LH 97+00.04
 105+20 LH 99+33.24
 106+17 RH

CONVERTED DRIVES
 103+75
 106+20
 108+25

POST WAR SECONDARY
 PARCEL # 10
 INSTRUMENT CUMMERT RES
 DATE 9-3-49

GRANTOR JOSEPH PIERRE COUTURE
 GRANTEE ST OF VT

RECORDED
 BOOK
 PAGE
 DATE
 REMARKS

NORTON
 Series S No. 209(1) Sheet 22 of 50