
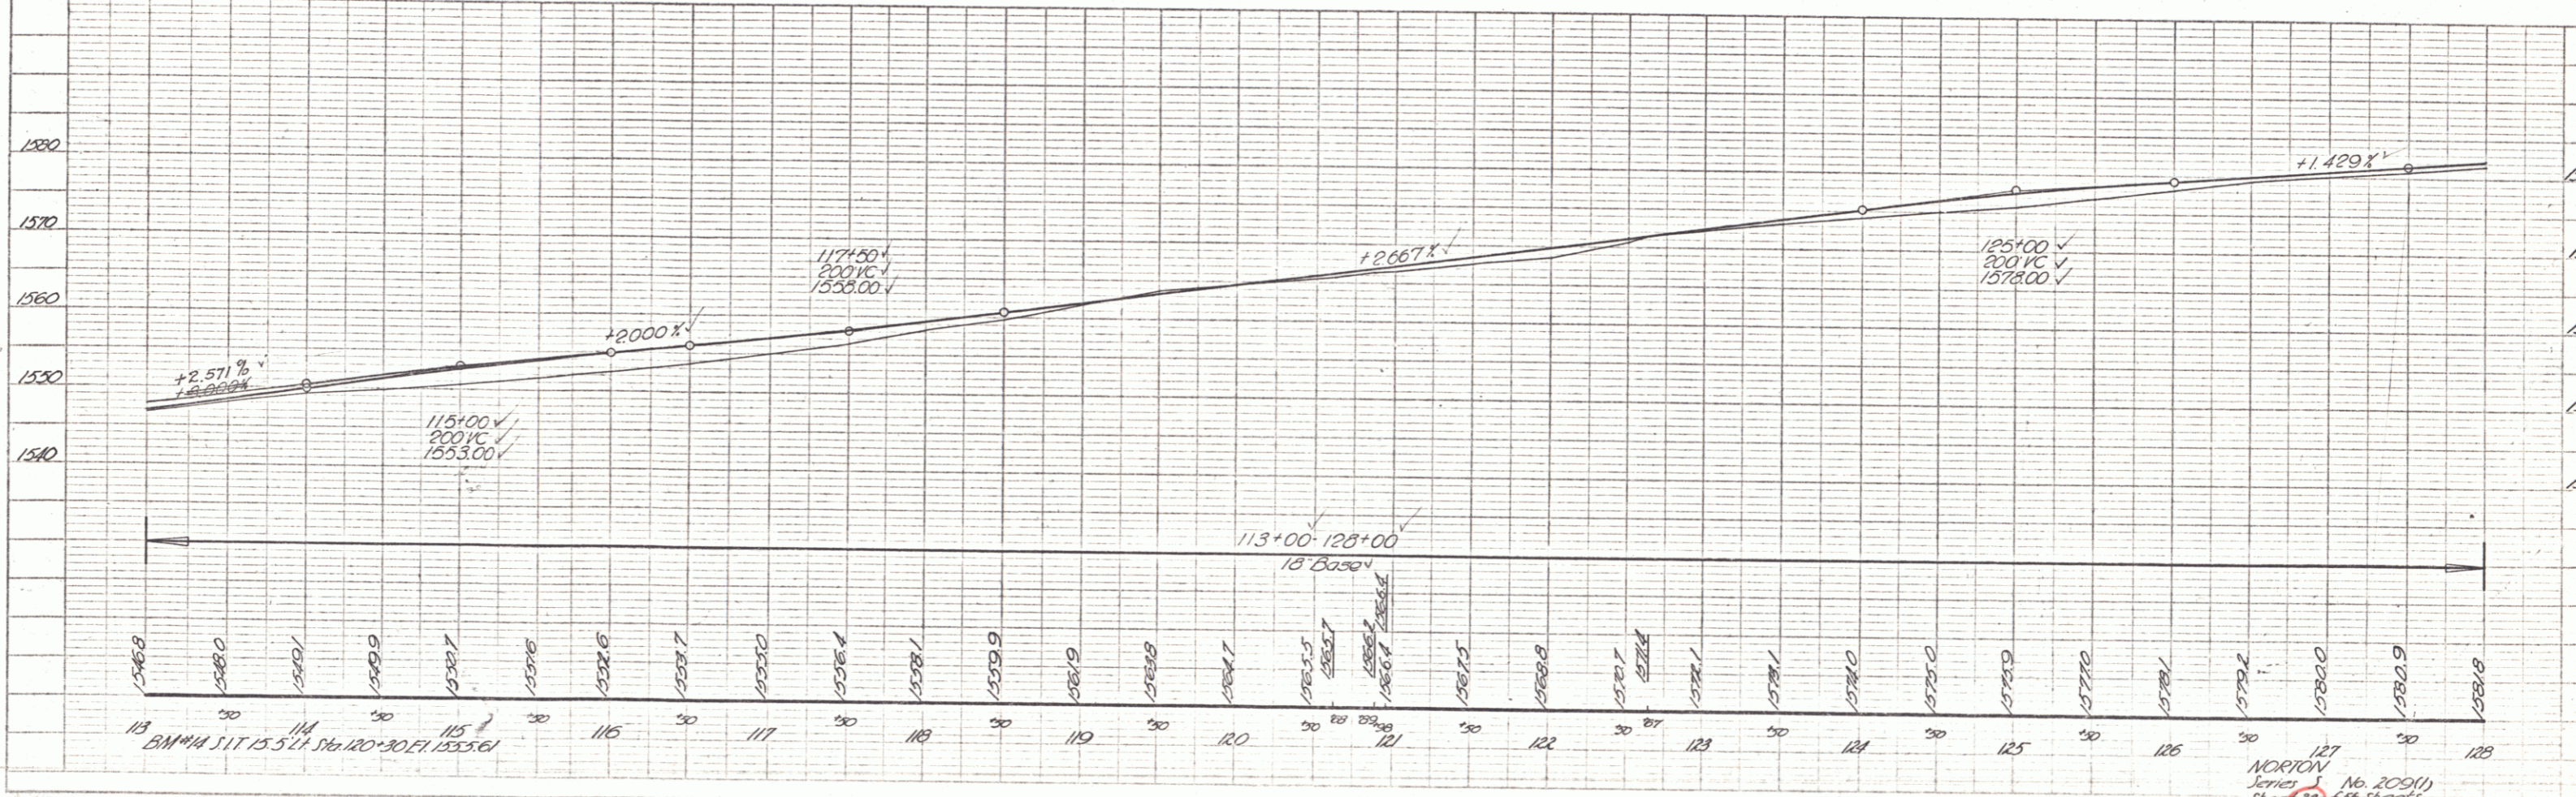


PLAN  
 DATE 8-26  
 DRAWN BY N.T.J.  
 CHECKED BY N.T.J.

PLAN  
 DATE 8-26  
 DRAWN BY N.T.J.  
 CHECKED BY N.T.J.

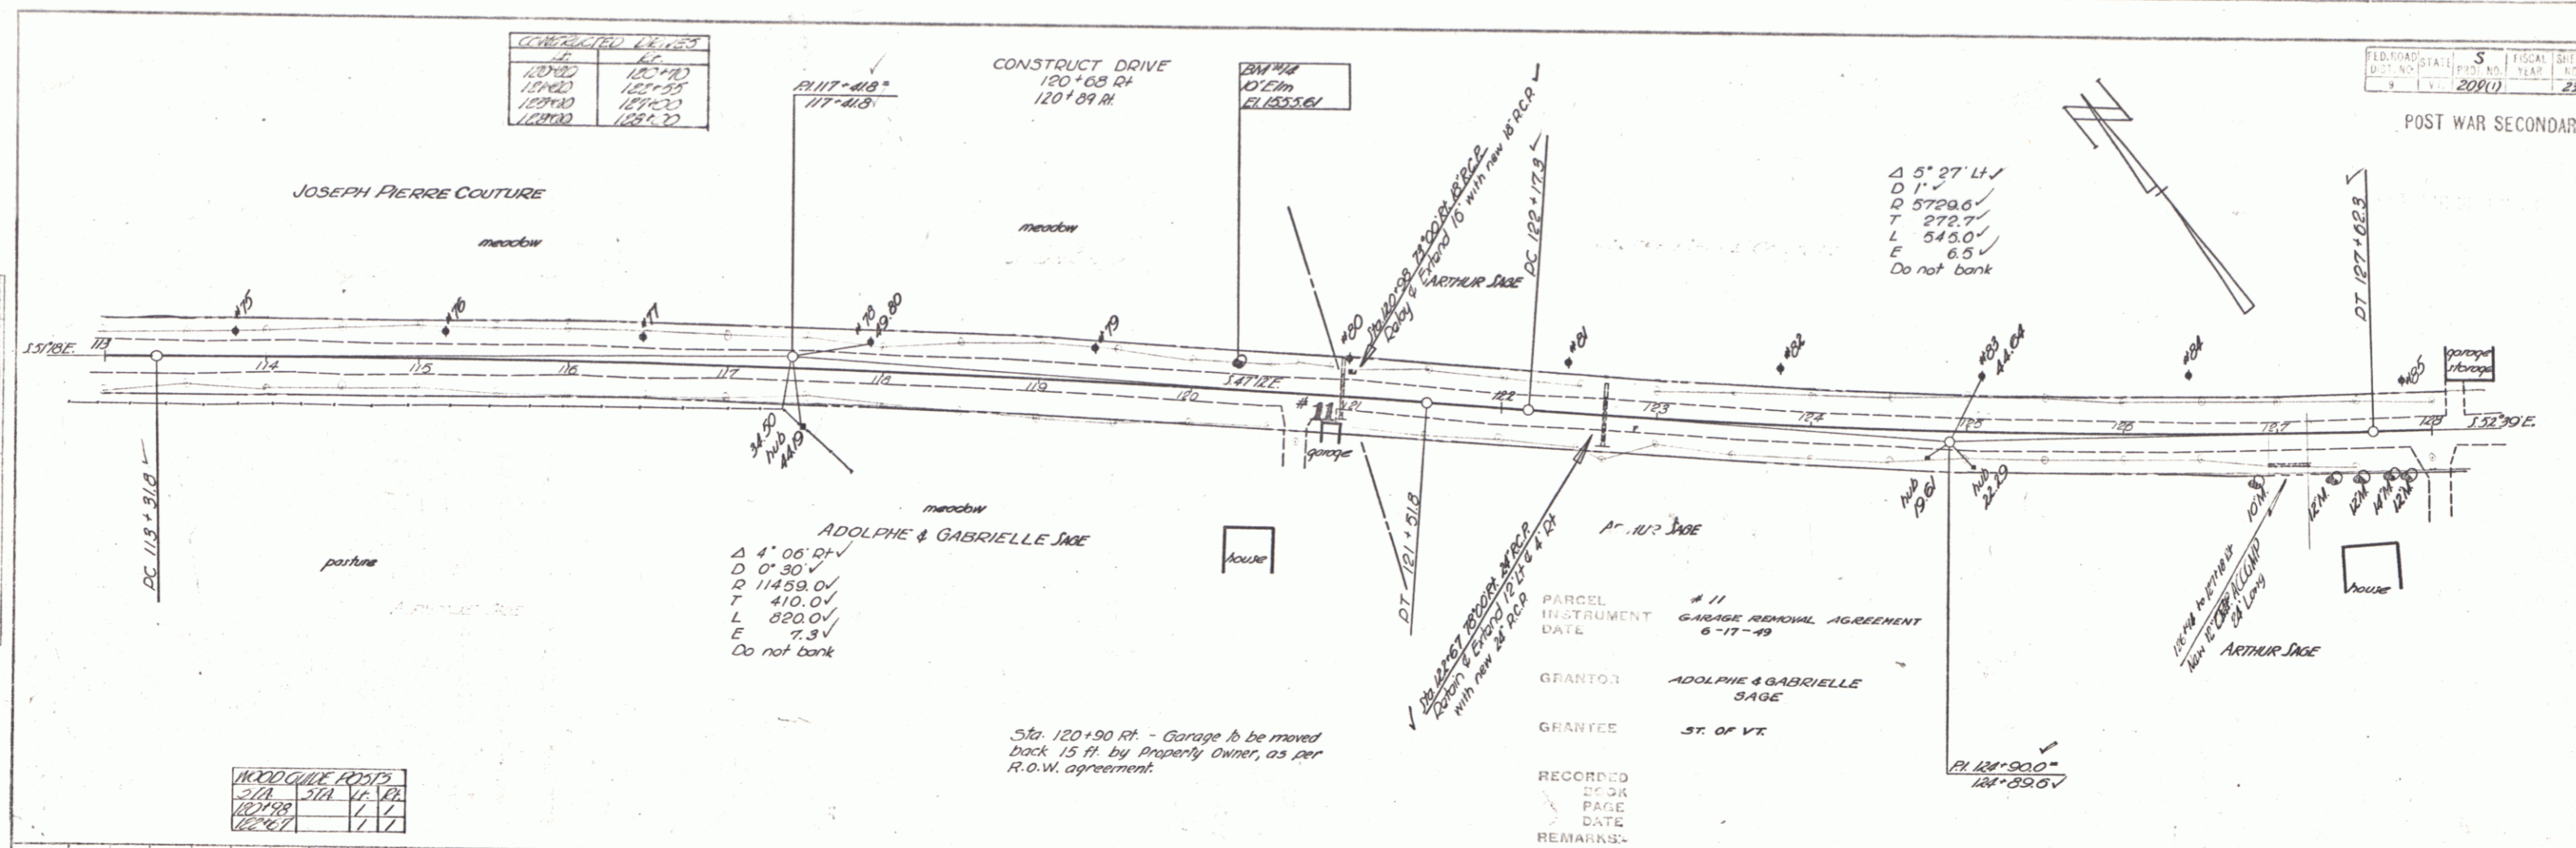

127  
 NORTON  
 Series No. 209(1)  
 Sheet 23 of 36 Sheets