
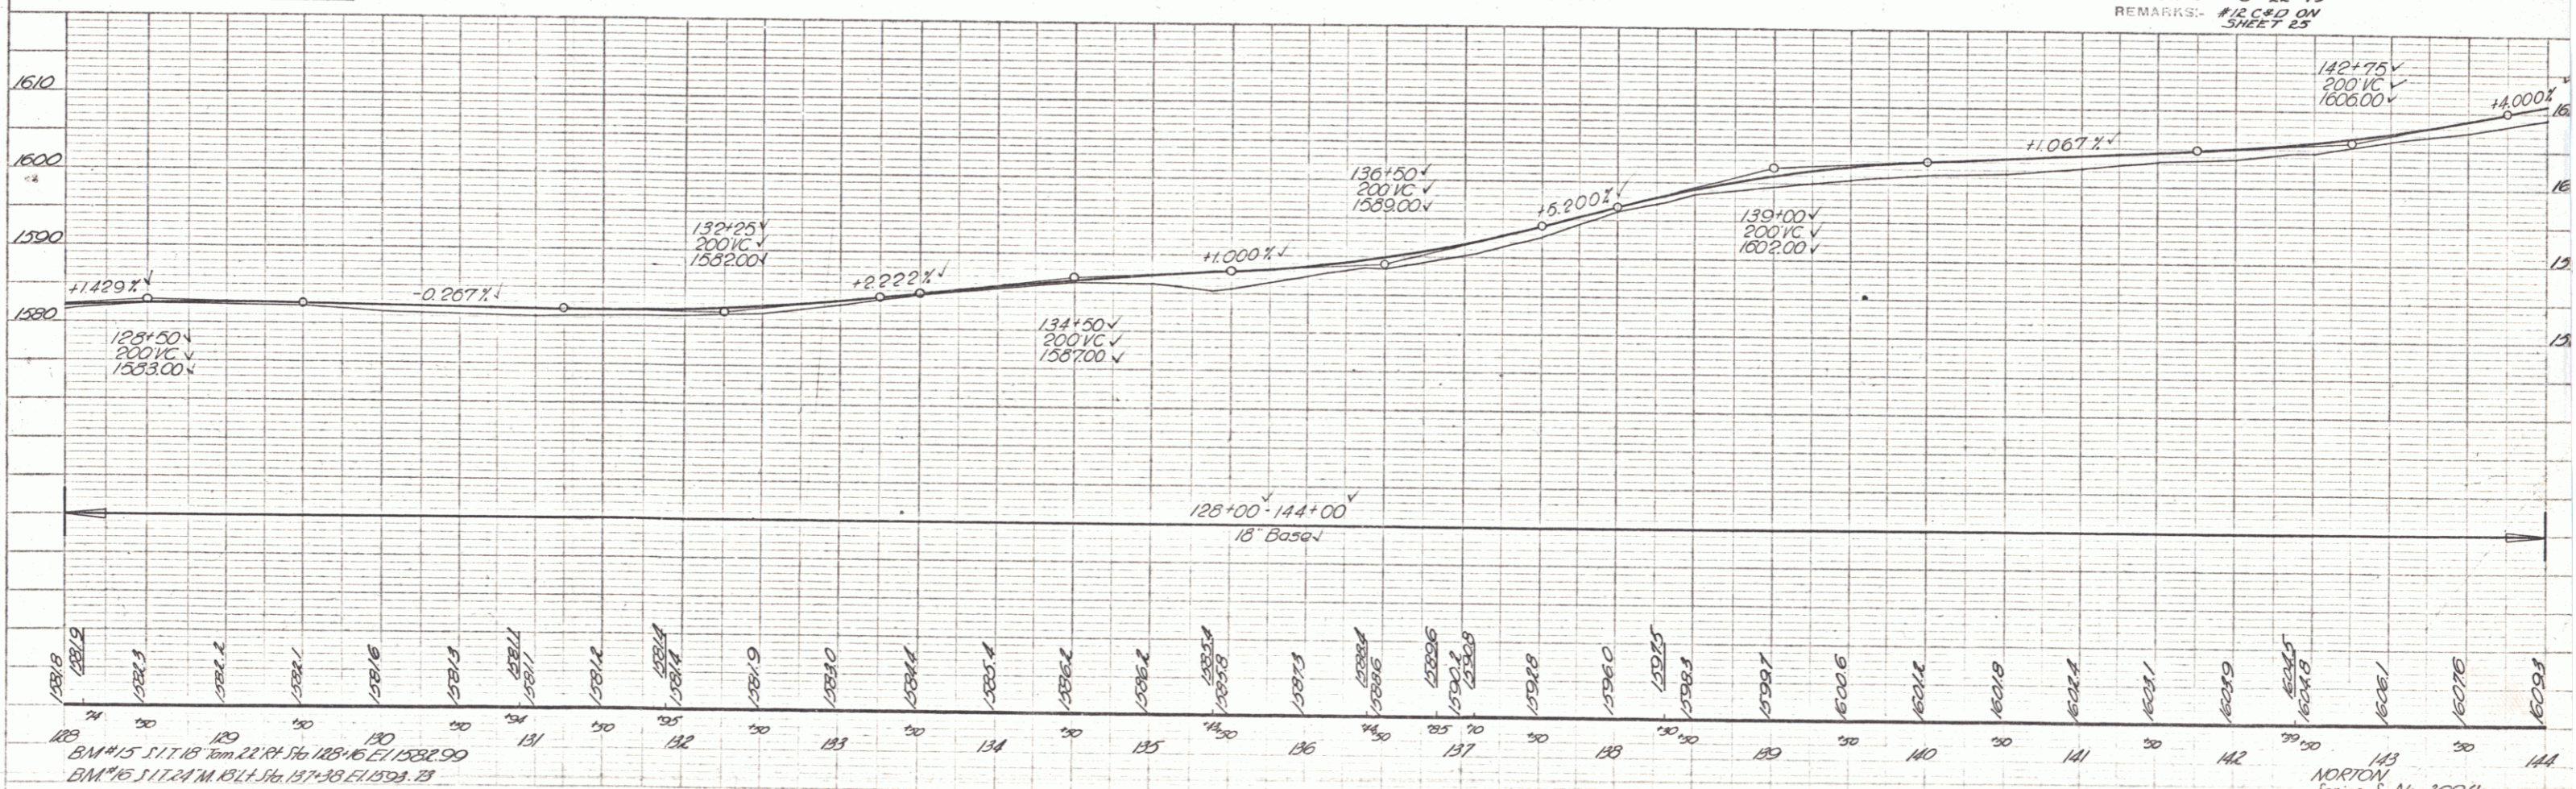


PLAN
 DATE
 DRAWN BY
 CHECKED BY
 TITLE

FILE
 DATE
 DRAWN BY
 CHECKED BY
 TITLE

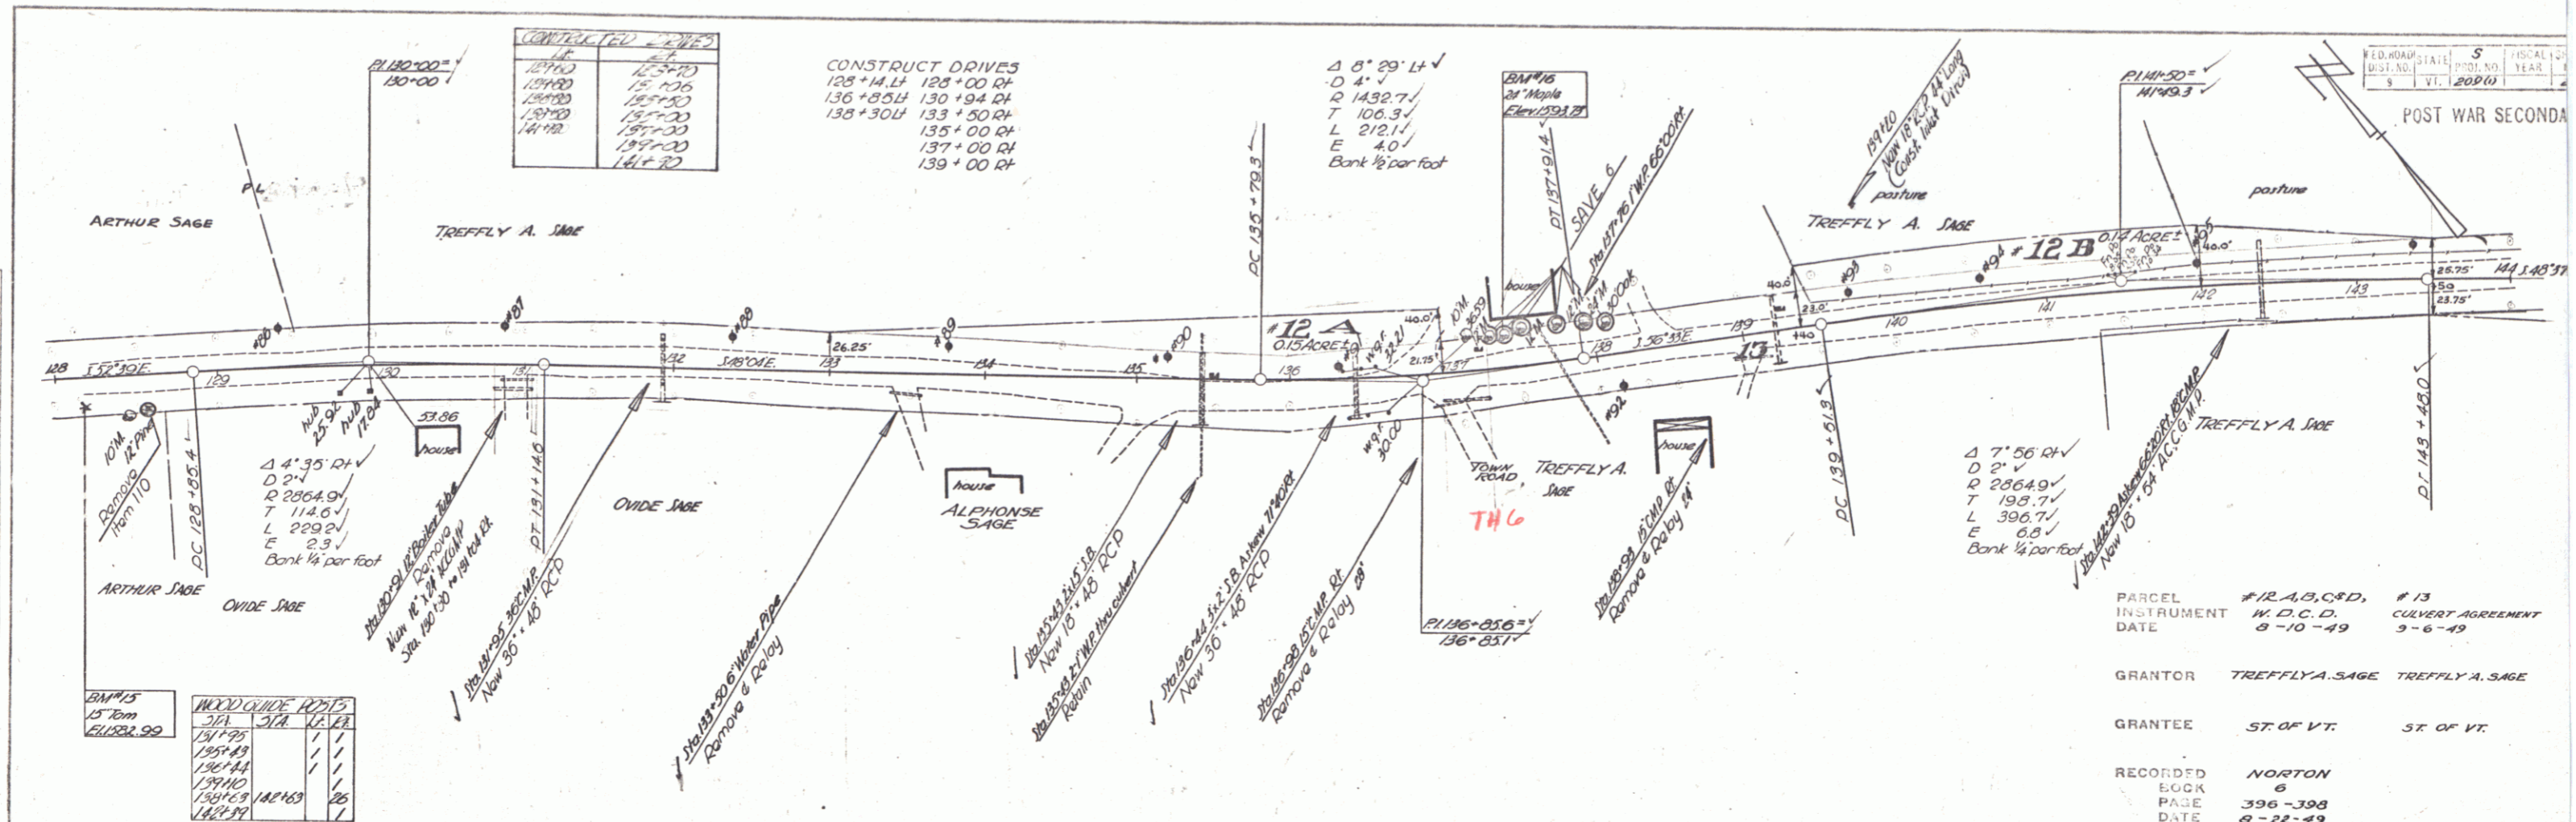

FED. ROAD STATE 5 FISCAL YEAR
 DIST. NO. 3 VI. 2020

PARCEL #12 A, B, C, D, #13
 INSTRUMENT W. D. C. D.
 DATE 9-10-49 9-6-49
 GRANTOR TREFFLY A. SAGE TREFFLY A. SAGE
 GRANTEE ST. OF VT. ST. OF VT.
 RECORDED NORTON
 BOOK 6
 PAGE 396-398
 DATE 8-22-49
 REMARKS: #12 C & D ON SHEET 25

NORTON
 Survey No. 209(1)
 Sheet 24 of 36 Sheets