


CONSTRUCT DRIVE  
149+00 RT

CONVEYED	14
14A	14
14B	14
14C	14
14D	14
14E	14
14F	14
14G	14
14H	14
14I	14
14J	14
14K	14
14L	14
14M	14
14N	14
14O	14
14P	14
14Q	14
14R	14
14S	14
14T	14
14U	14
14V	14
14W	14
14X	14
14Y	14
14Z	14

DIST. NO.	5	FISCAL YEAR	25
ST. NO.	9	YEAR	25

POST WAR SECONDARY

PLAN	14
DATE	9-48
BY	W. J. H. H.
SCALE	1" = 100'
PROJECT	CONSTRUCT DRIVE
SECTION	14
DATE	9-48
BY	W. J. H. H.

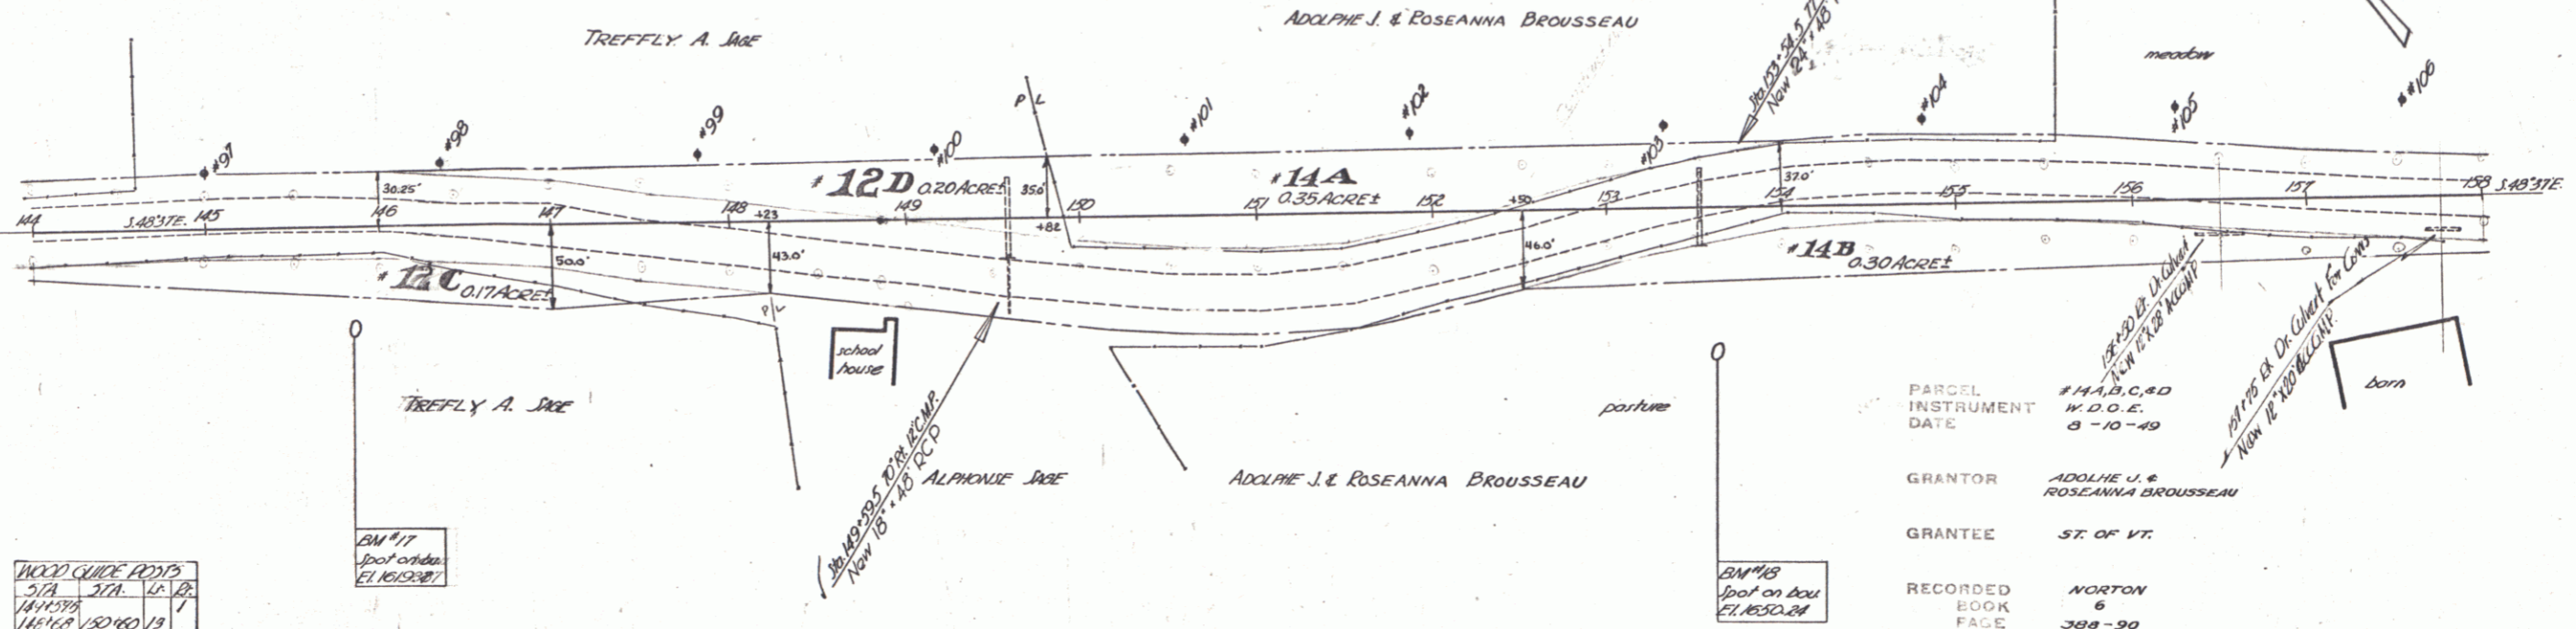

WOOD GUIDE POINTS	
51A	1
51B	1
51C	1
51D	1
51E	1
51F	1
51G	1
51H	1
51I	1
51J	1
51K	1
51L	1
51M	1
51N	1
51O	1
51P	1
51Q	1
51R	1
51S	1
51T	1
51U	1
51V	1
51W	1
51X	1
51Y	1
51Z	1

PARCEL INSTRUMENT DATE #14, B.C.R.D. W.D.O.E. 8-10-49  
GRANTOR ADOLPHE J. & ROSEANNA BROUSSEAU  
GRANTEE ST. OF VT.  
RECORDED NORTON  
BOOK 6  
PAGE 308-30  
DATE 9-25-49  
REMARKS: #14 CONDON SHEET 26

PLAN	14
DATE	9-48
BY	W. J. H. H.
SCALE	1" = 100'
PROJECT	CONSTRUCT DRIVE
SECTION	14
DATE	9-48
BY	W. J. H. H.

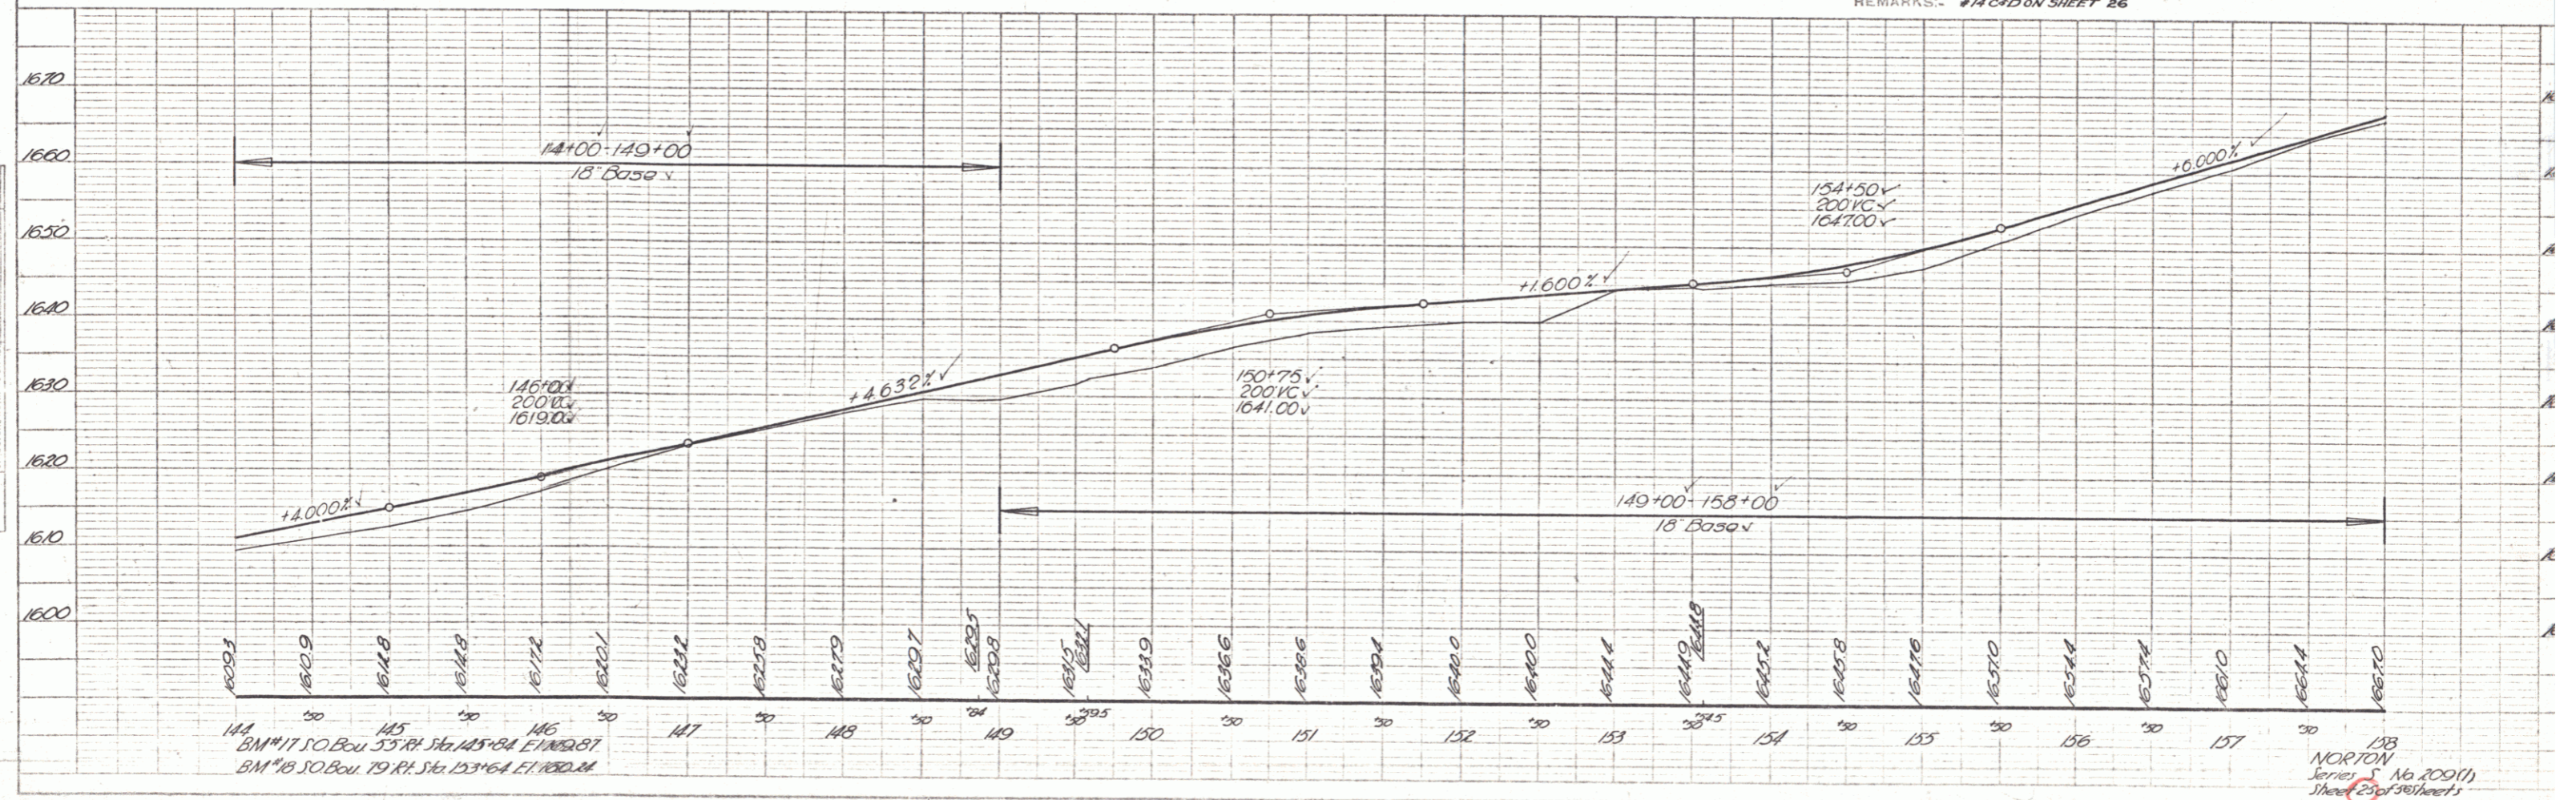


PLATE 1-PLAN-PROFILE OF R.R. & C. STATIONED  
RECORDED & INDEXED, NEW YORK