
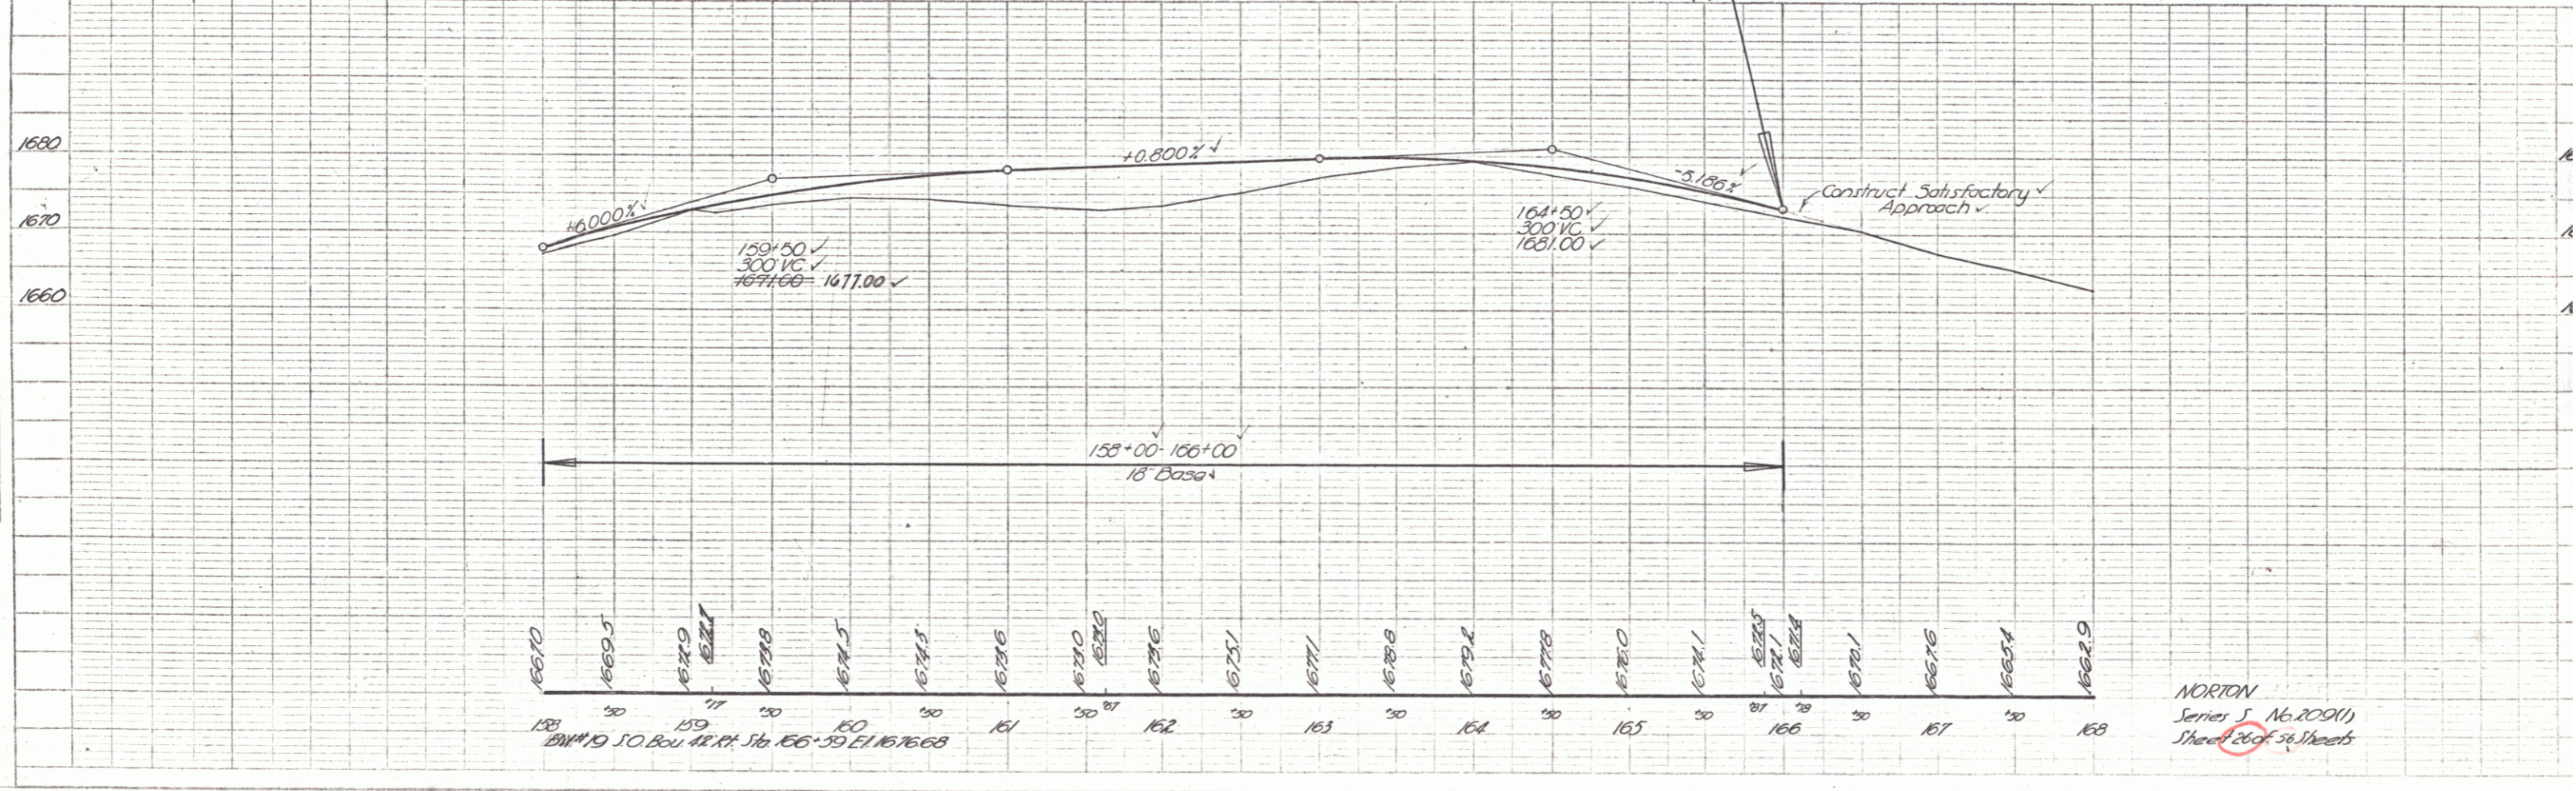


PLAN
 DATE BOOK
 8-28
 8-28
 9-48
 M.L.S. 2

PROF.
 DATE BOOK
 8-28
 8-28
 9-48
 M.L.S. 2

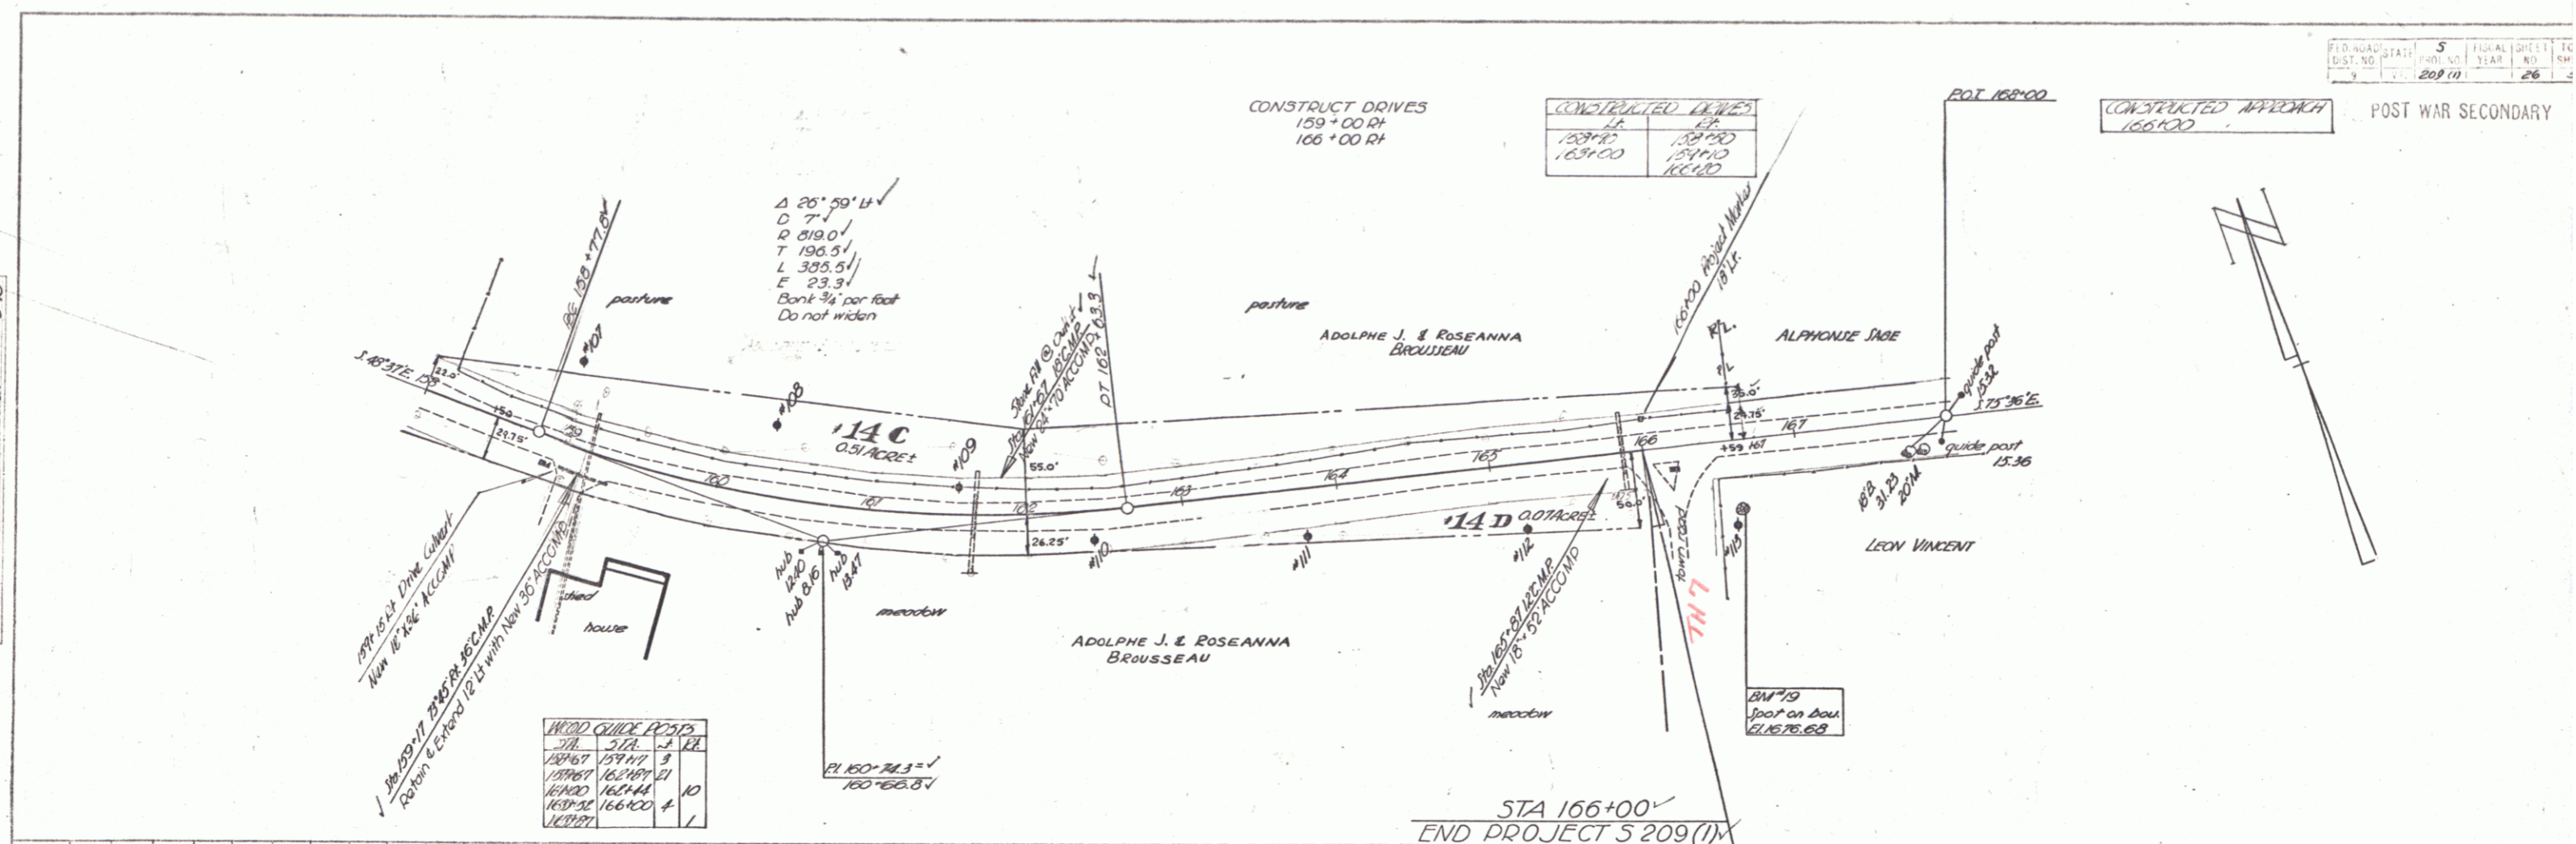

NORTON
 Series 5 16.209(1)
 Sheet 26 of 34 Sheets