
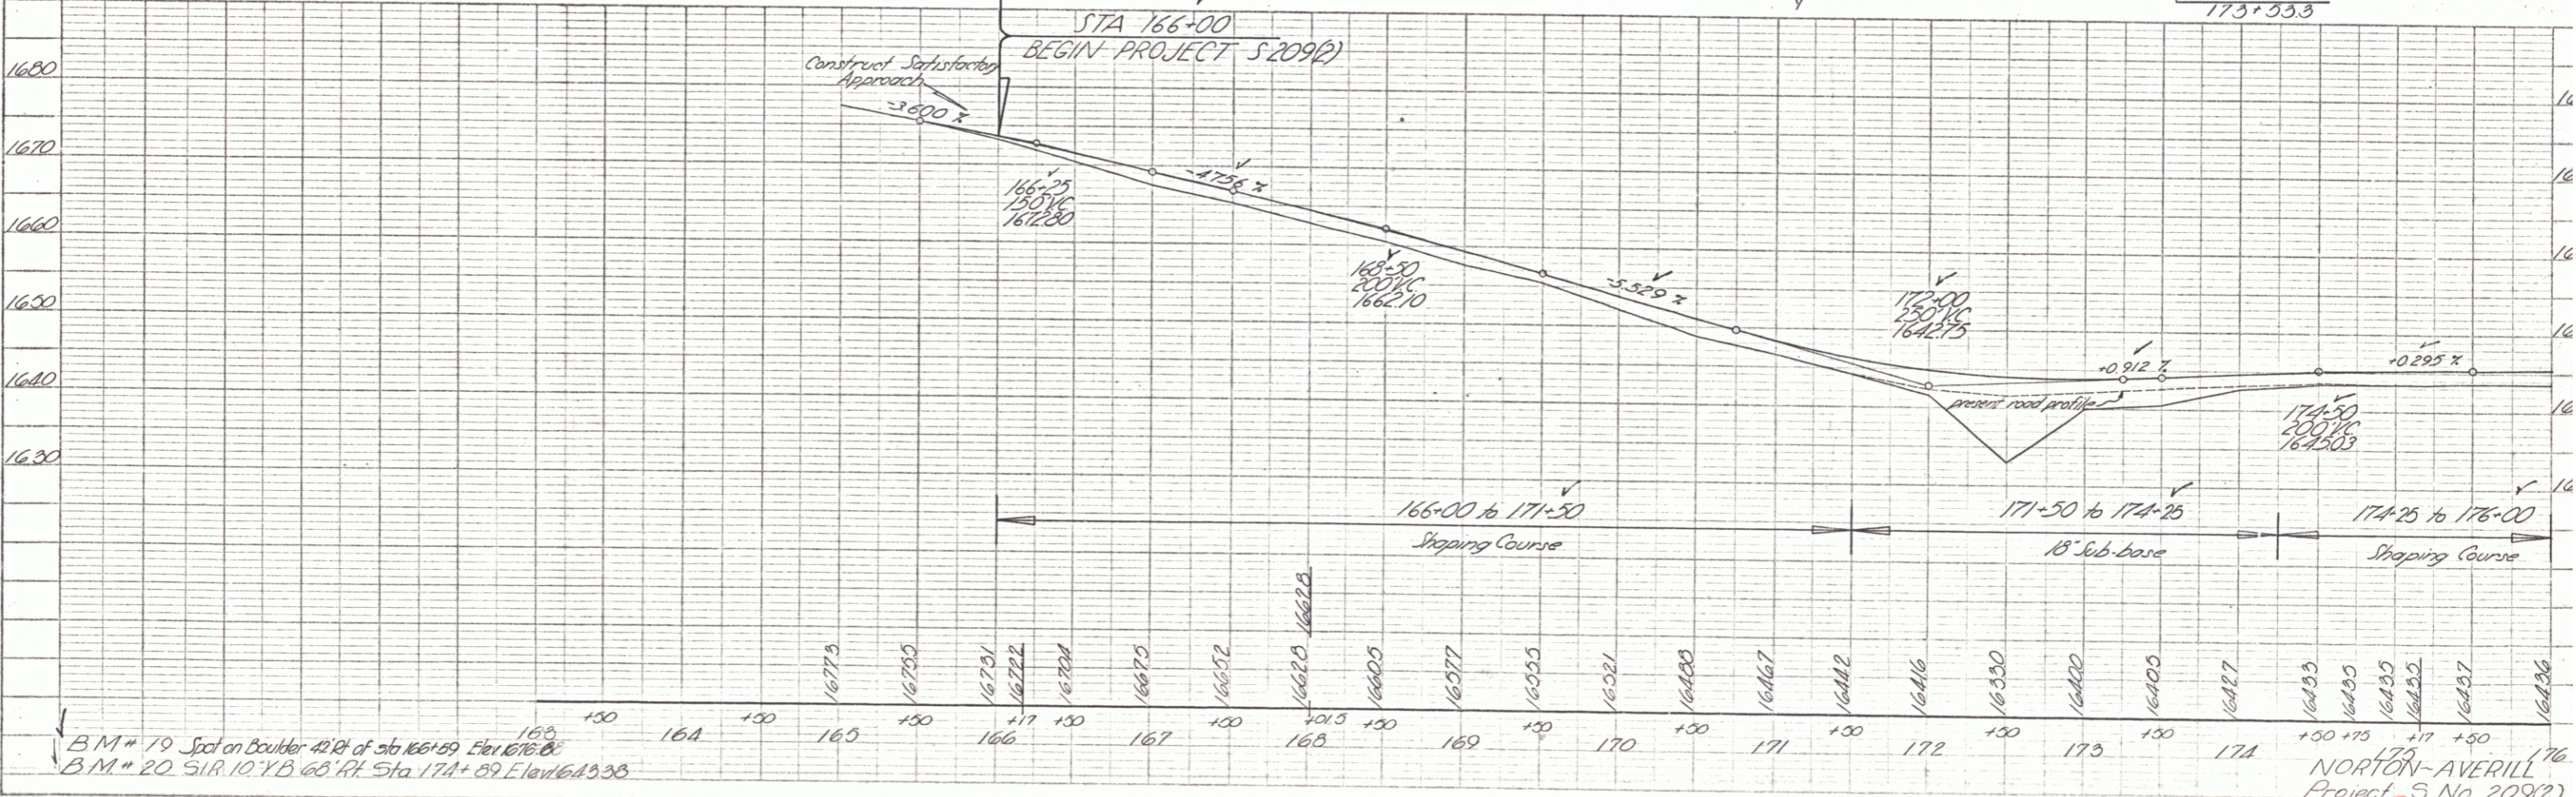


Instr	Date	Grantor	Grantee	Recorded	Book	Page	Date	Remarks
1	W.D.O.E. 11-5-52	Leon J. & Lumina M. Vincent	St. M.P.E.	Norton	6	518	11-14-52	
2	N.D.O.E. 11-5-52	A. J. & A. R. Brissette	St. M.P.E.	Norton	6	516	11-14-52	See Sheet 10

Station	LT	RT
167+45	/	/
167+05	/	/
167+30	/	/
172+47	/	/
172+55	/	/

PLAN
 DRAWN BY: A. Palmer
 CHECKED BY: A. Palmer
 DATE: 11/28/52

PROFILE
 DRAWN BY: A. Palmer
 CHECKED BY: A. Palmer
 DATE: 11/28/52

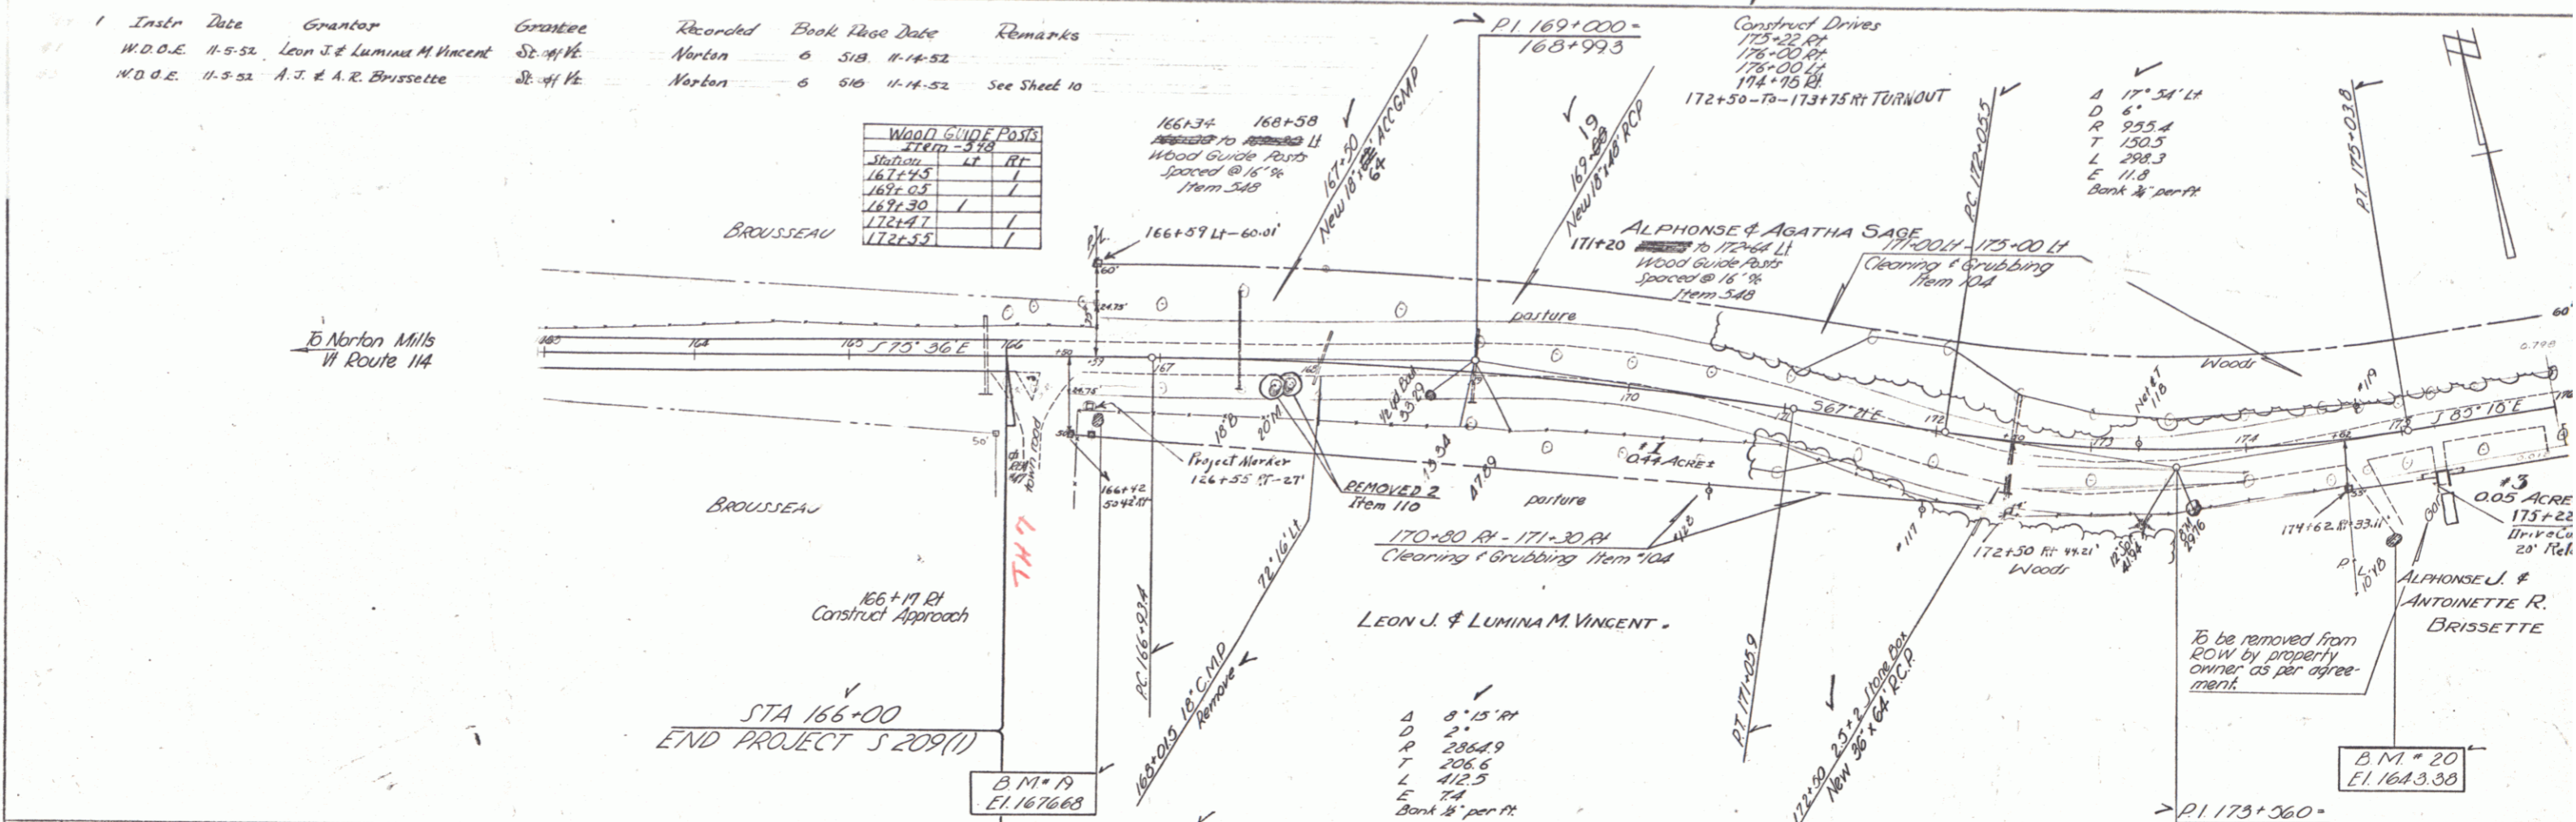

B.M. # 19 Spot on Boulder 42 ft of Sta 166+59 Elev 1676.68
 B.M. # 20 51R 10 YB 68 ft Sta 174+89 Elev 1643.38

NORTON-AVERILL
 Project S No 209(2)
 Sheet 9 of 49

PLATE 1 - PLAN - PROFILE & P.C. & S.C. STANDARDS
 ADAPTED FROM THE NEW YORK STATE ENGINEERING MANUAL
 1948 EDITION