



PLAN
 DRAWN BY: A. F. BOWEN
 DATE: 1/13/52
 CHECKED BY: R. J. PALMER
 DATE: 7/1/52

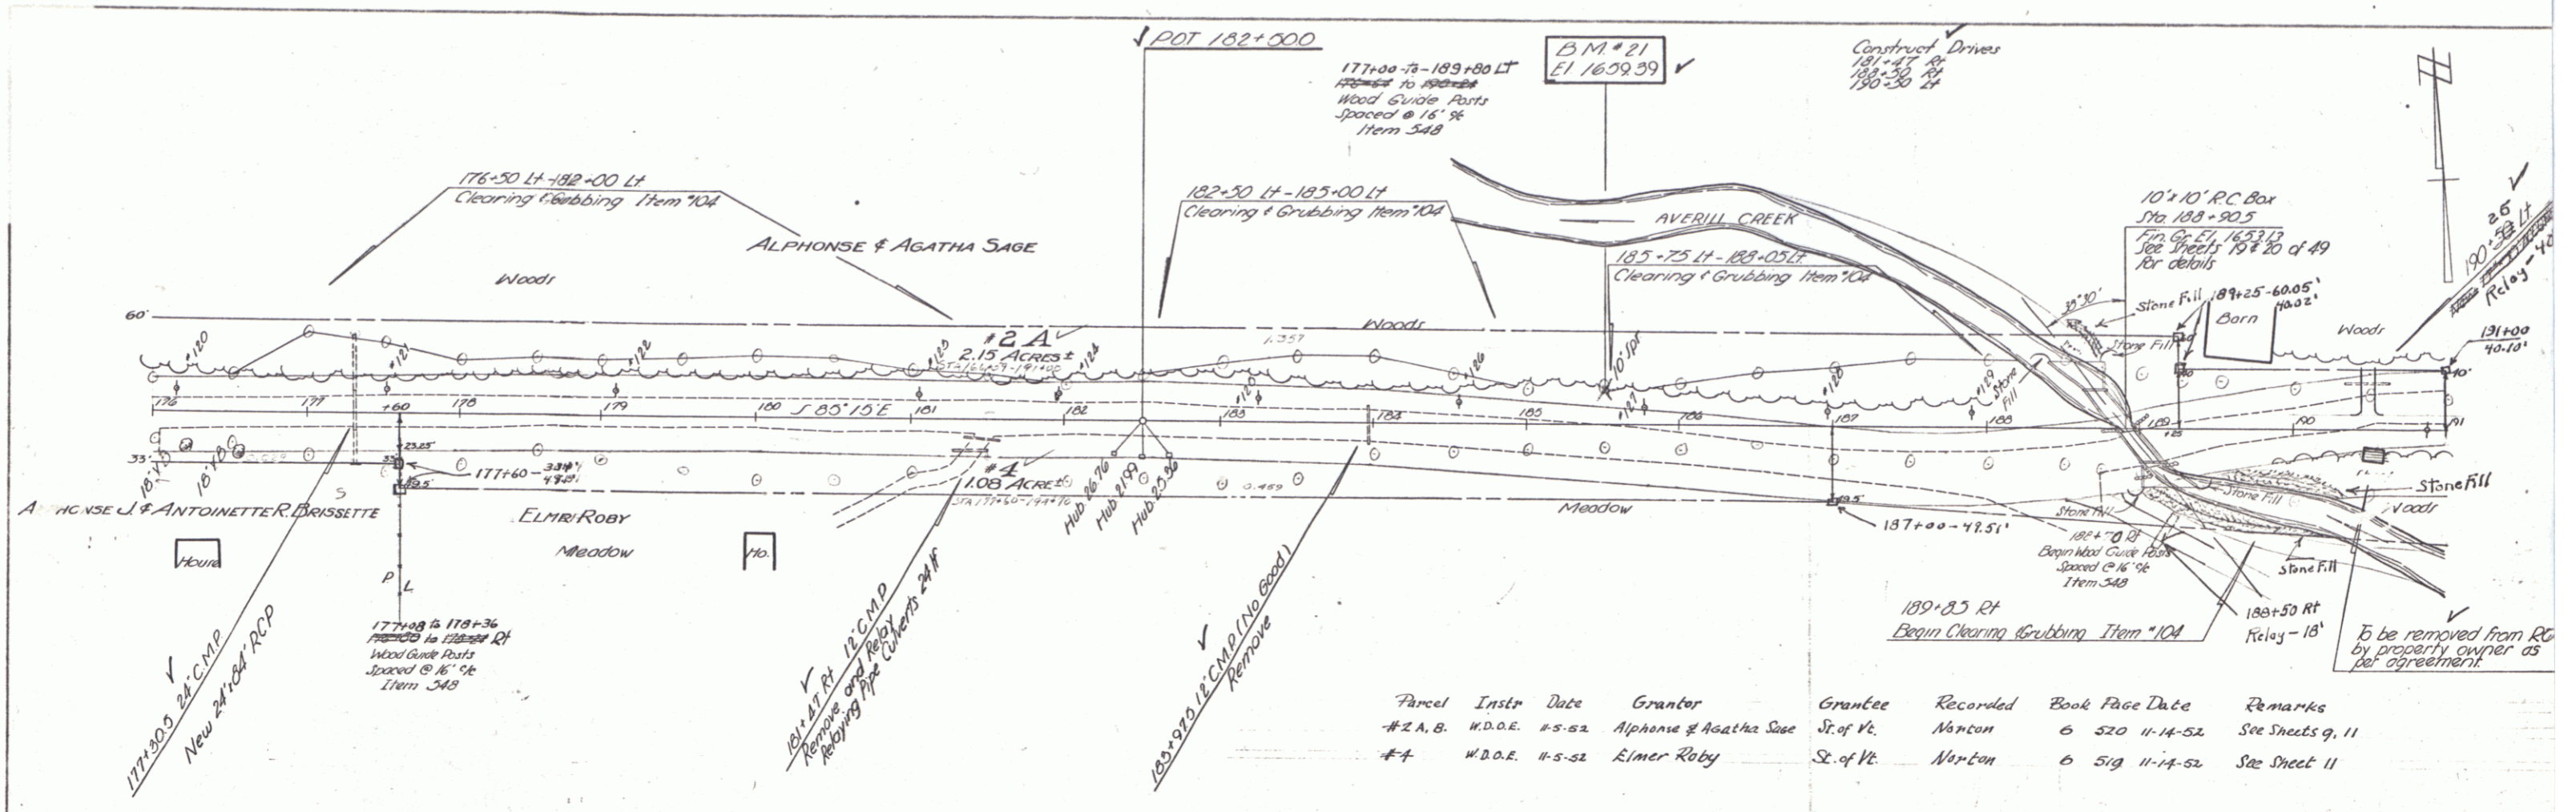

PROFILE
 DRAWN BY: A. F. BOWEN
 DATE: 1/13/52
 CHECKED BY: R. J. PALMER
 DATE: 7/1/52

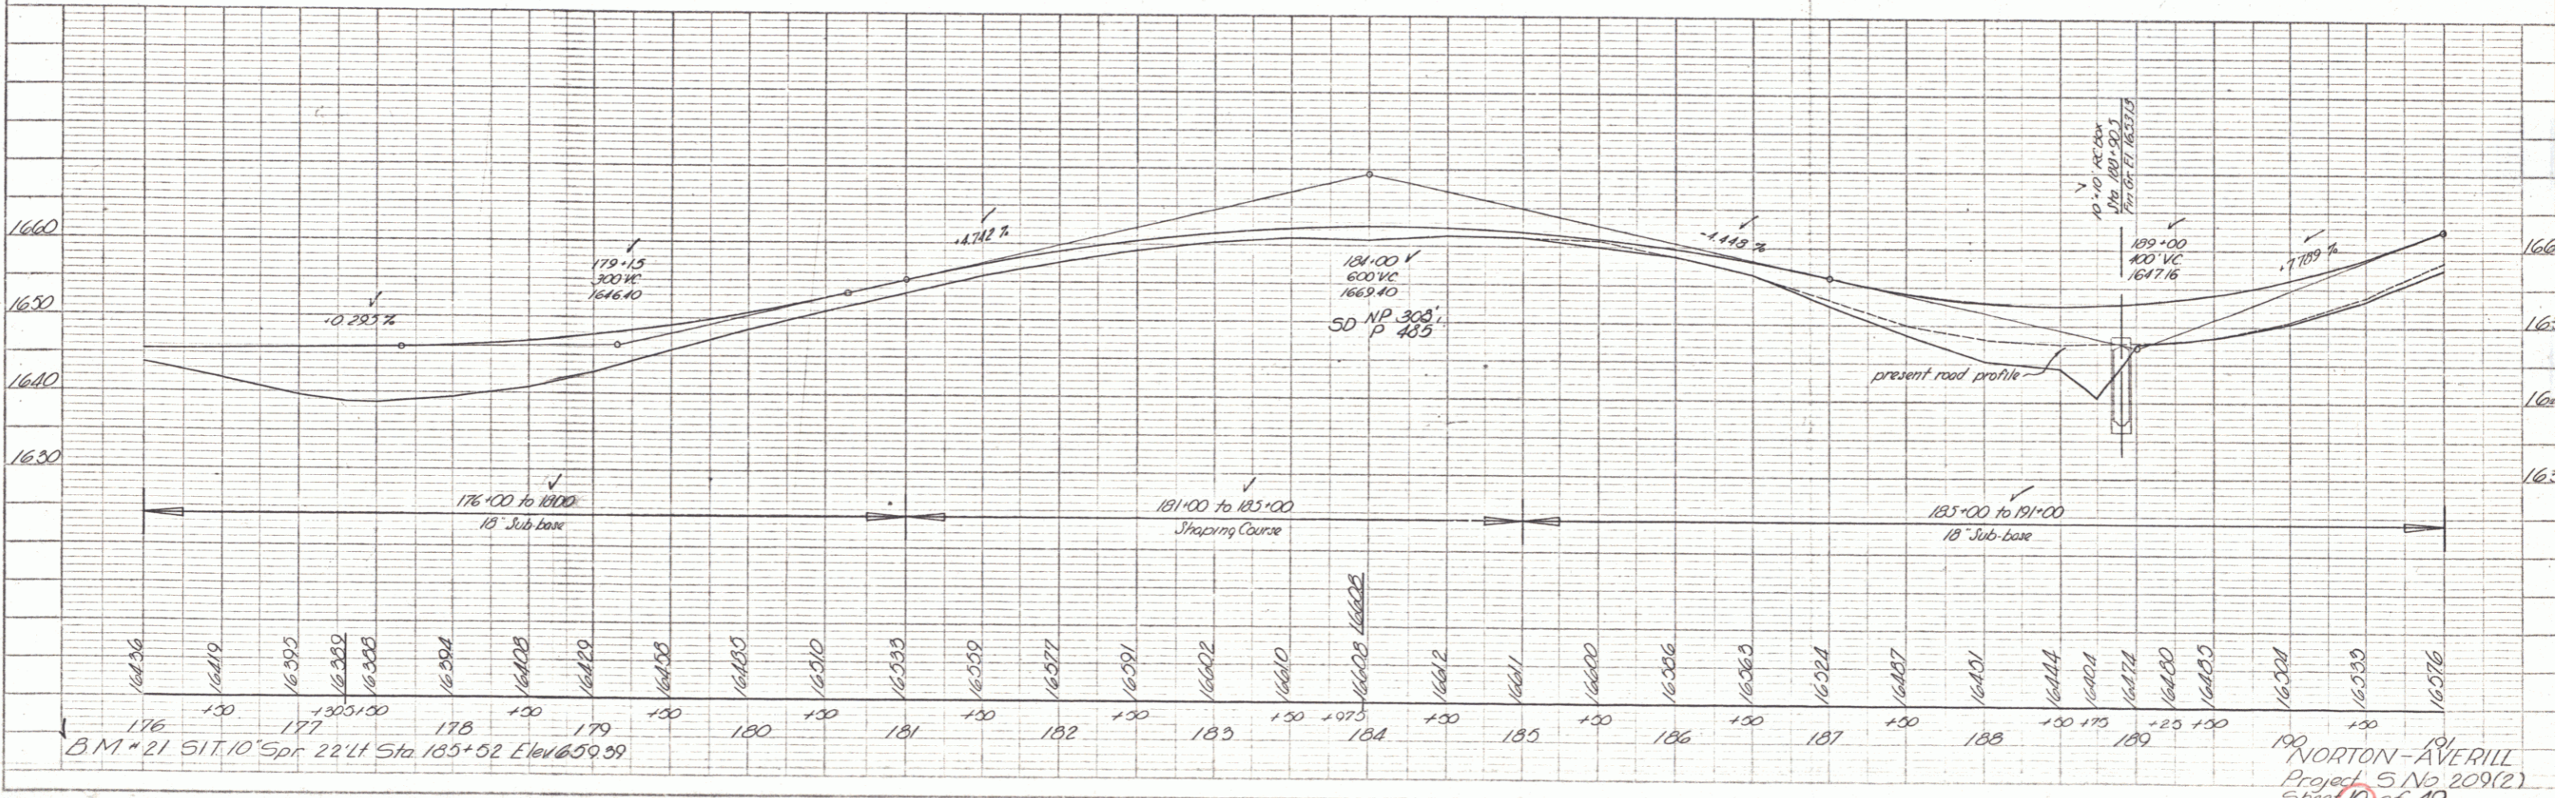

NORTON - AVERILL
 Project 5 No 209(2)
 Sheet 10 of 49