


PLAN	DATE	BY	CHECKED
1/28	1/28	A. Fellner	A. Fellner
1/28	1/28	A. Fellner	A. Fellner


PROFILE	DATE	BY	CHECKED
1/28	1/28	A. Fellner	A. Fellner
1/28	1/28	A. Fellner	A. Fellner

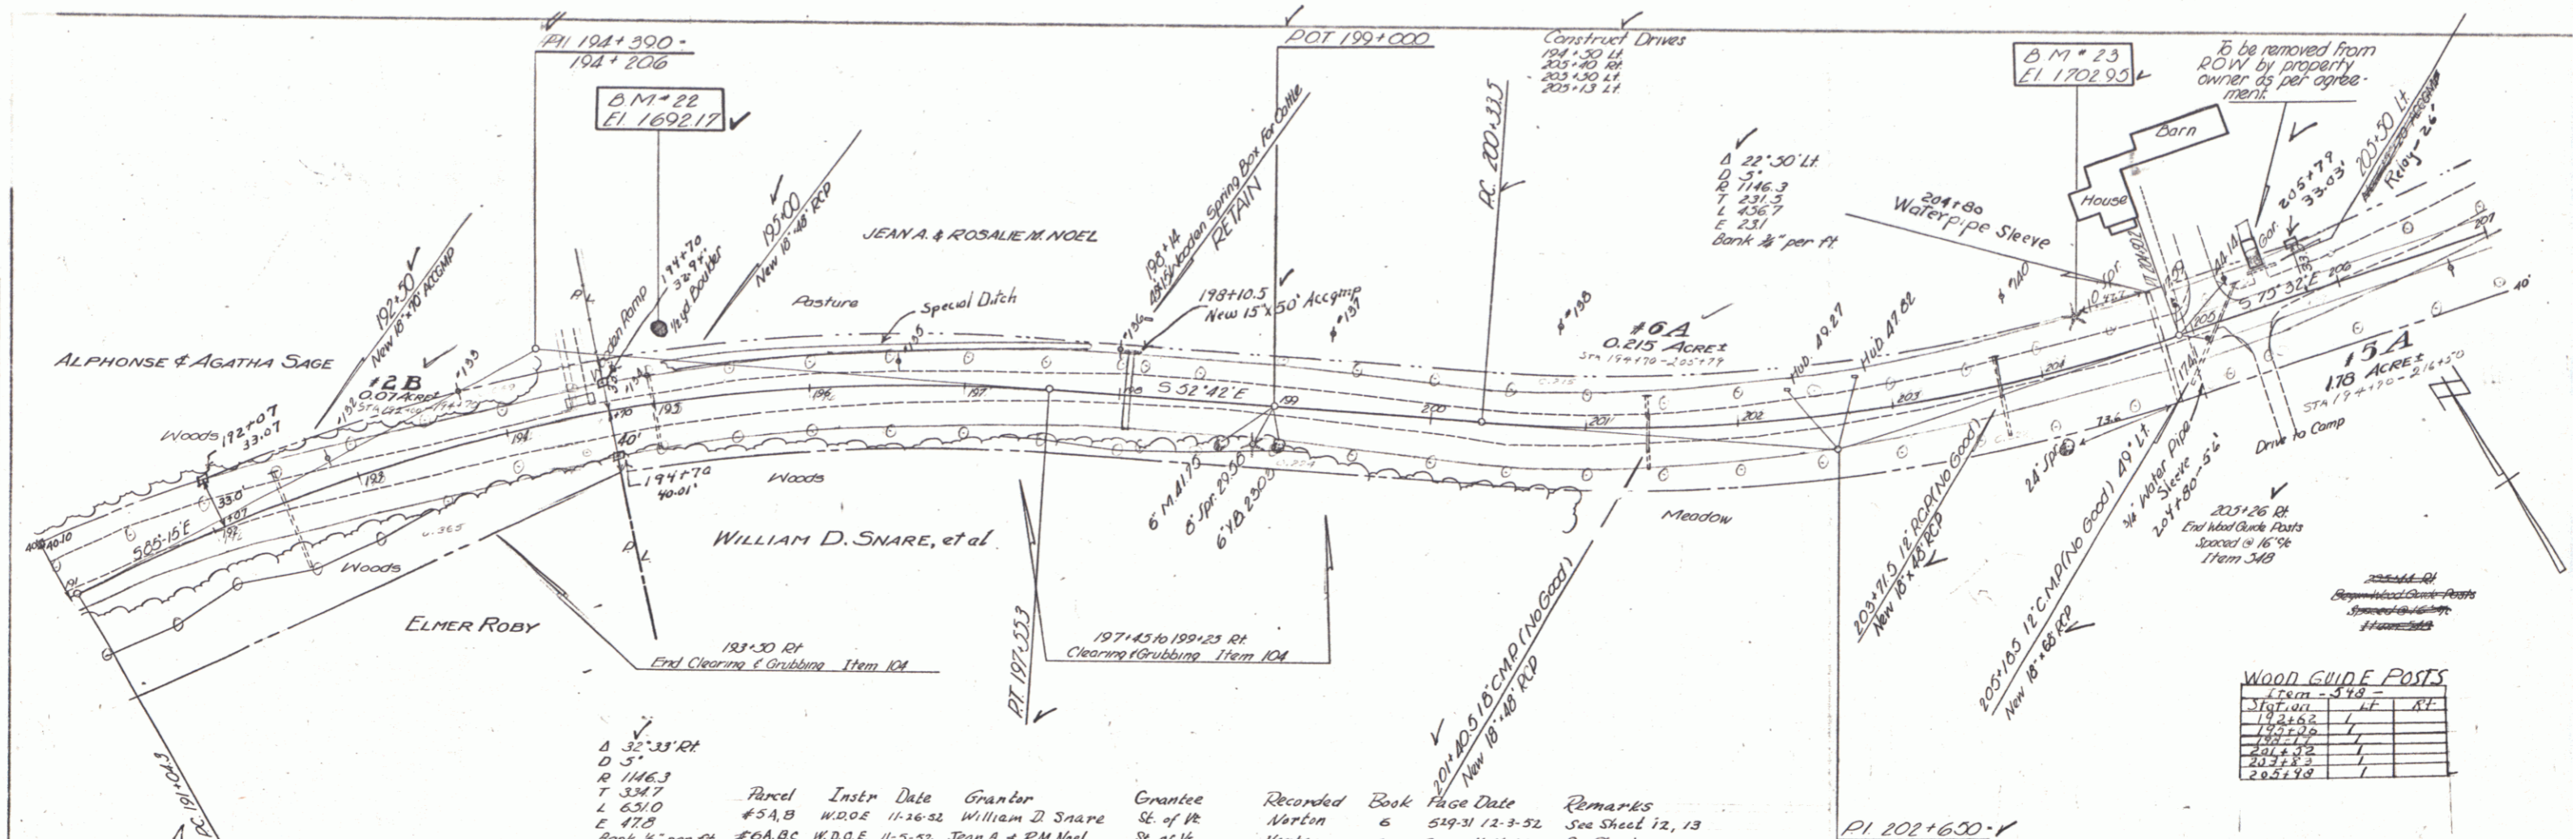

Parcel	Instr	Date	Grantor	Grantee	Recorded	Book	Page	Date	Remarks
#5A,B	W.D.O.E.	11-26-52	William D. Snare	SE of 1/4	Norton	6	519-31	12-3-52	See Sheet 12, 13
#6A,B,C	W.D.O.E.	11-5-52	Jean A. & R.M. Noel	SE of 1/4	Norton	6	522	11-14-52	See Sheet 12
#6A1	Q.C.D.E.	12-29-52	ALPHONSE & AGATHA SAGE	SE of 1/4	Norton	6	524	11-14-52	

WOOD GUIDE POSTS

Loc	HT	RT
1321.02	1	RT
1371.00	1	RT
1371.00	1	RT
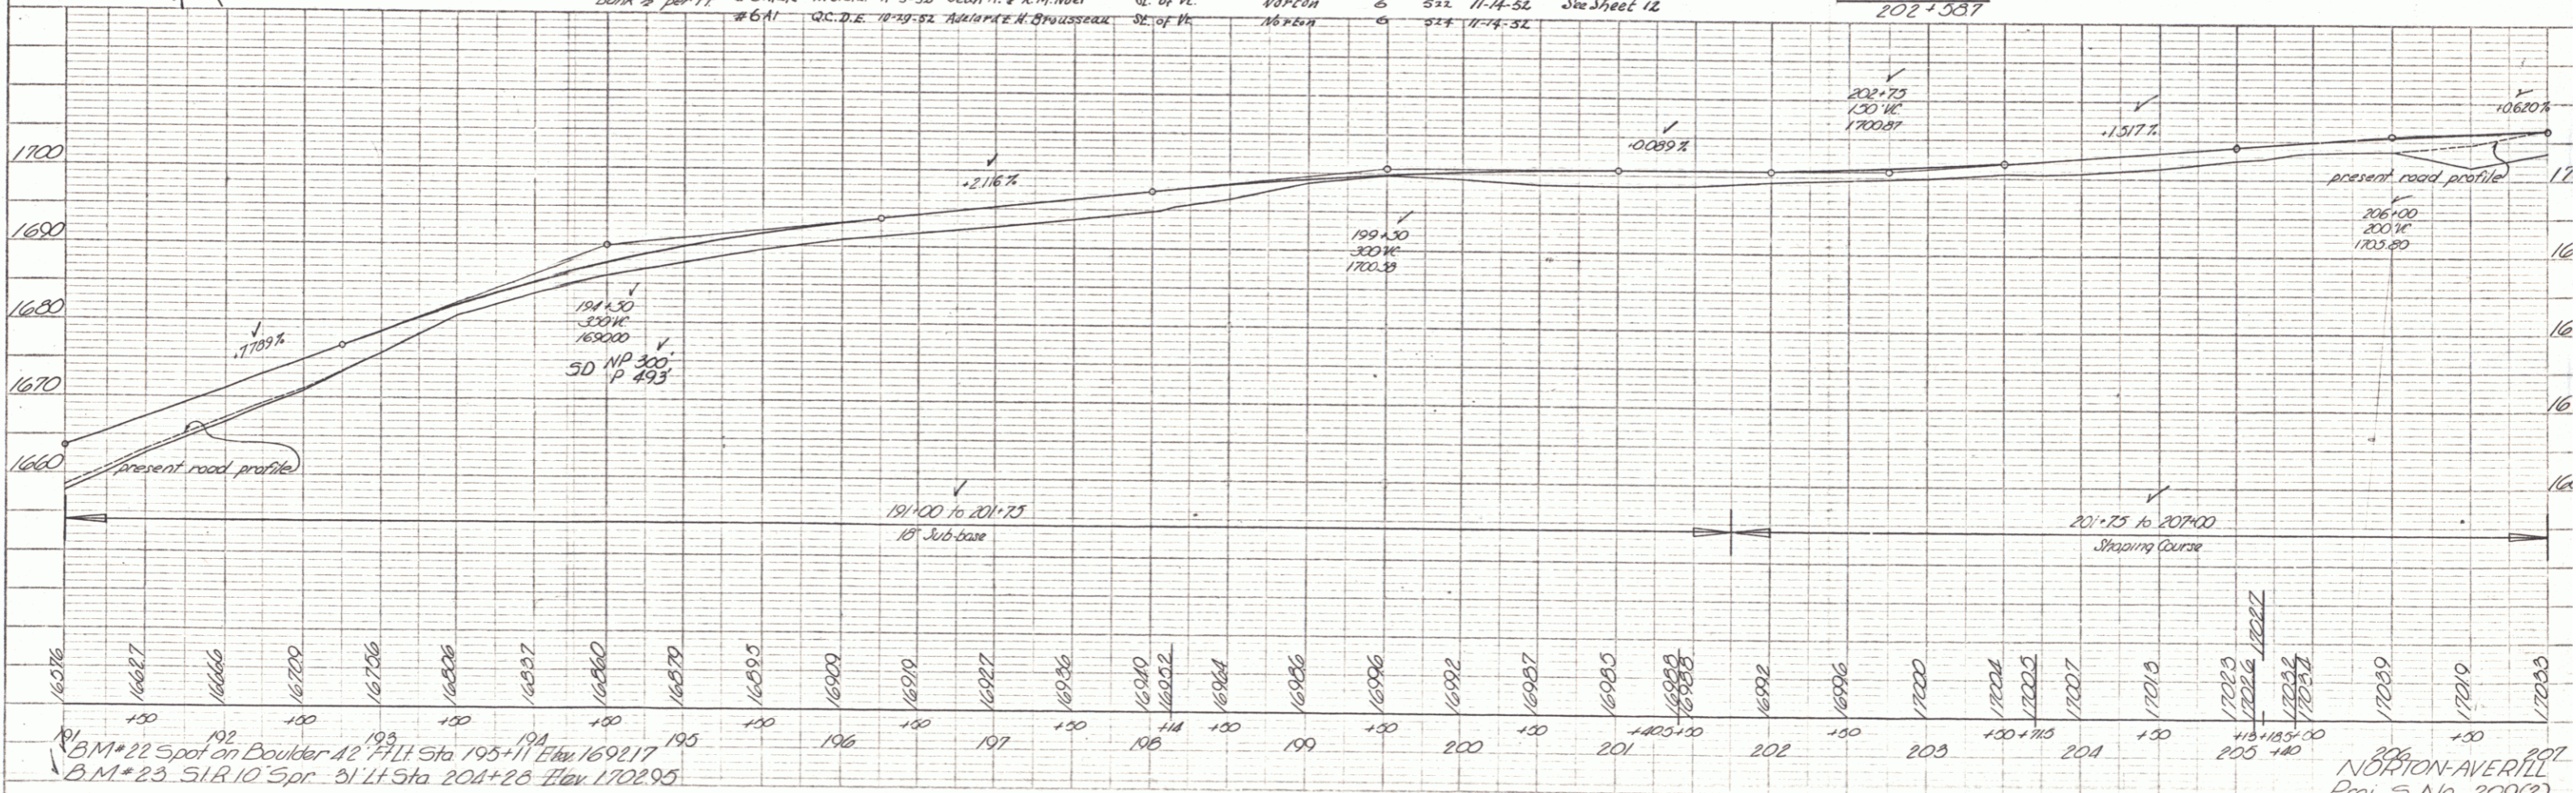

BM #22 Spot on Boulder at Hill Sta 195+11 Elev 1692.17
 BM #23 S.I.R. 10 Spr. 31 Lt Sta 204+26 Elev 1702.95

NORTON-AVERILL
 Proj. No. 209(2)
 Sheet 11 of 49