
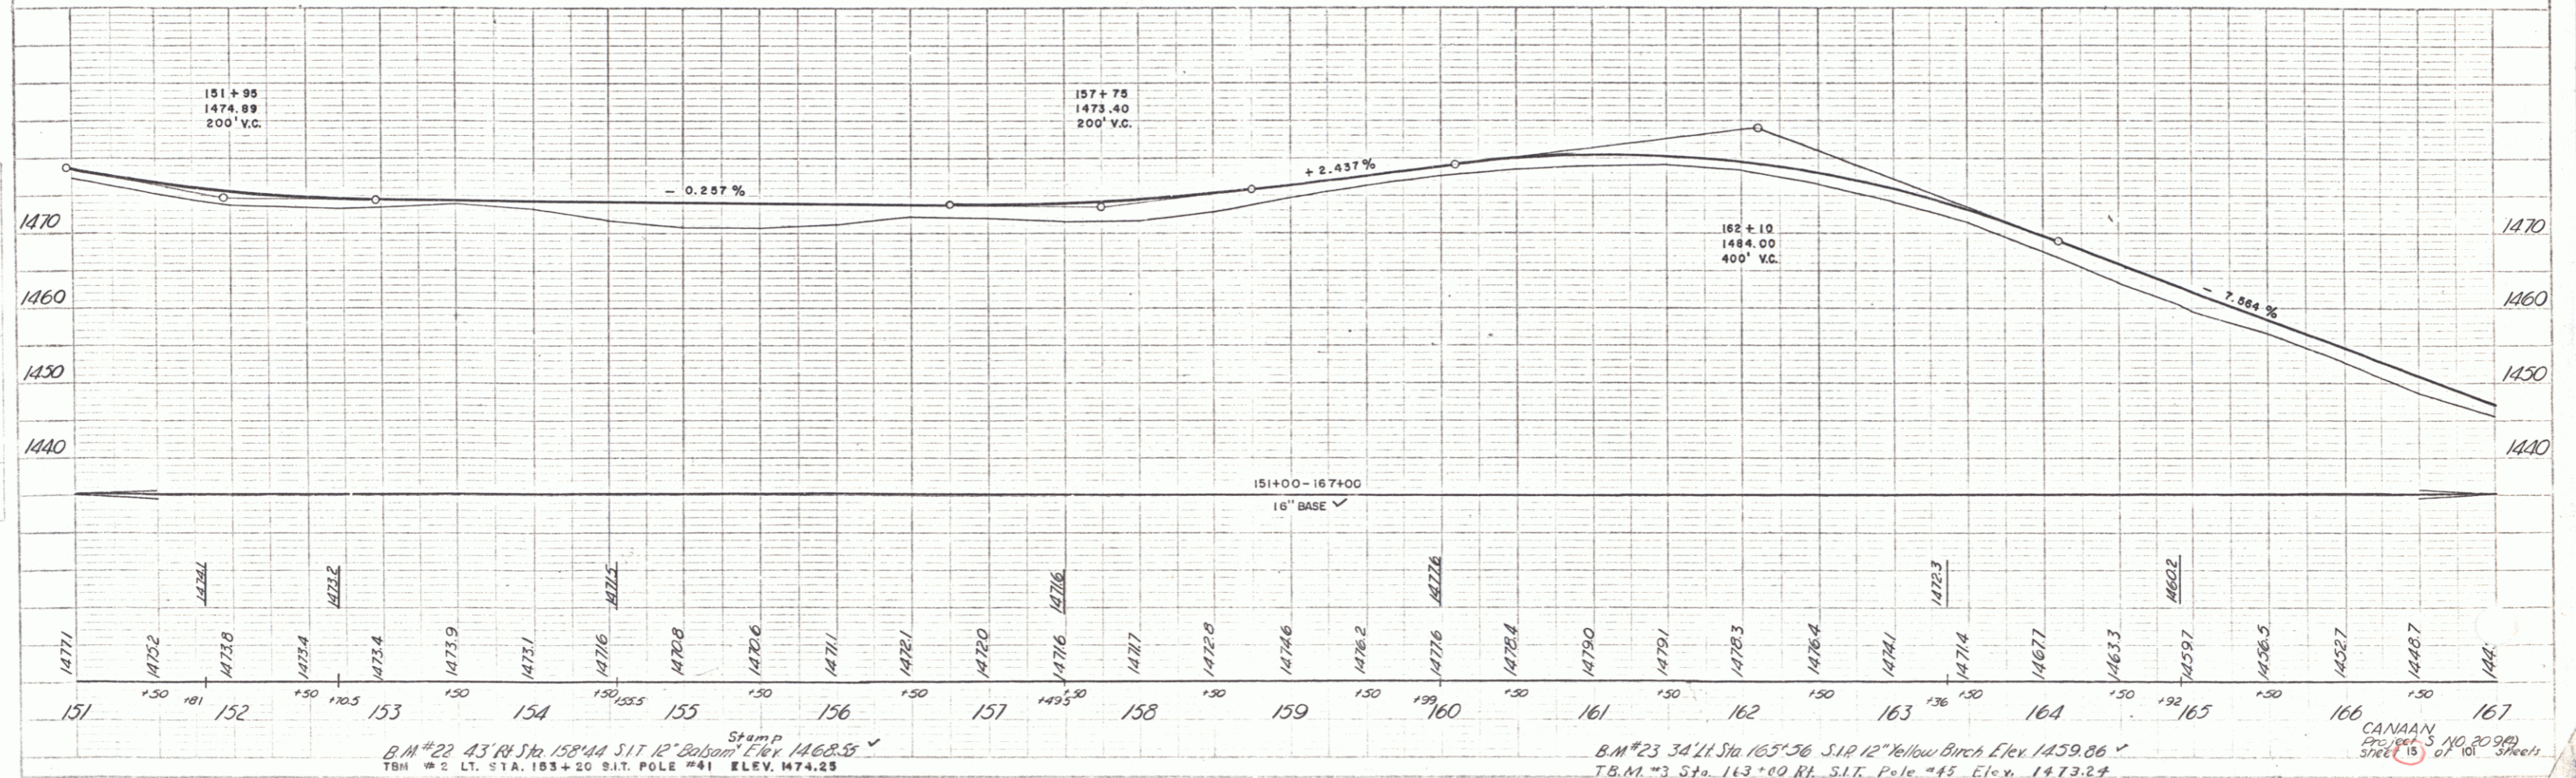


PLAN
 DATE: 5-30
 DRAWN BY: [Signature]
 CHECKED BY: [Signature]
 TITLE: [Blank]

PROFILE
 DATE: 5-31
 DRAWN BY: [Signature]
 CHECKED BY: [Signature]
 TITLE: [Blank]

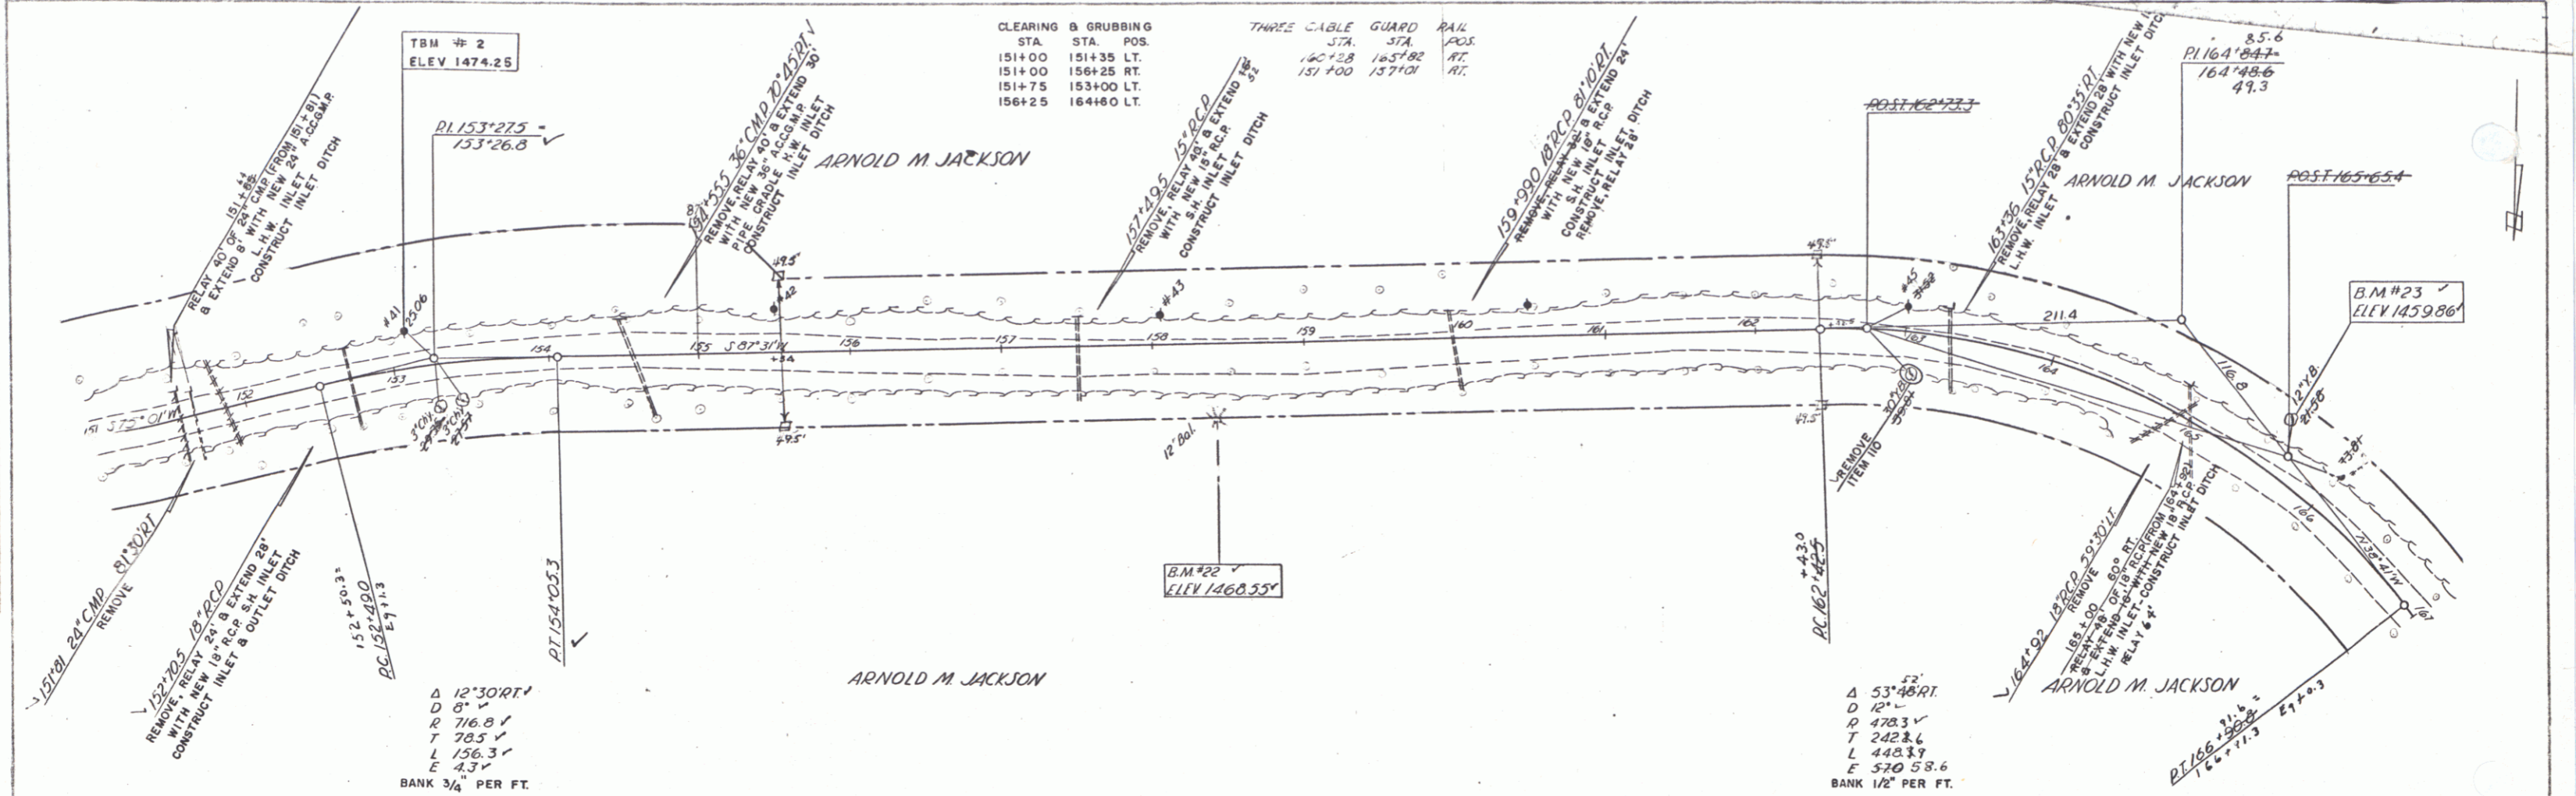

B.M. #22 43' R/S Sta. 158+44 S/T 12" Yellow Birch Elev. 1468.53
 TBM #2 LT. STA. 155+20 S/T. POLE #41 ELEV. 1474.25

B.M. #23 34' L/S Sta. 165+56 S/T 12" Yellow Birch Elev. 1459.86
 T.B.M. #3 Sta. 163+00 R/S. S/T. Pole #45 Elev. 1473.24

CANAAN
 SHEET 15 OF 101 SHEETS