
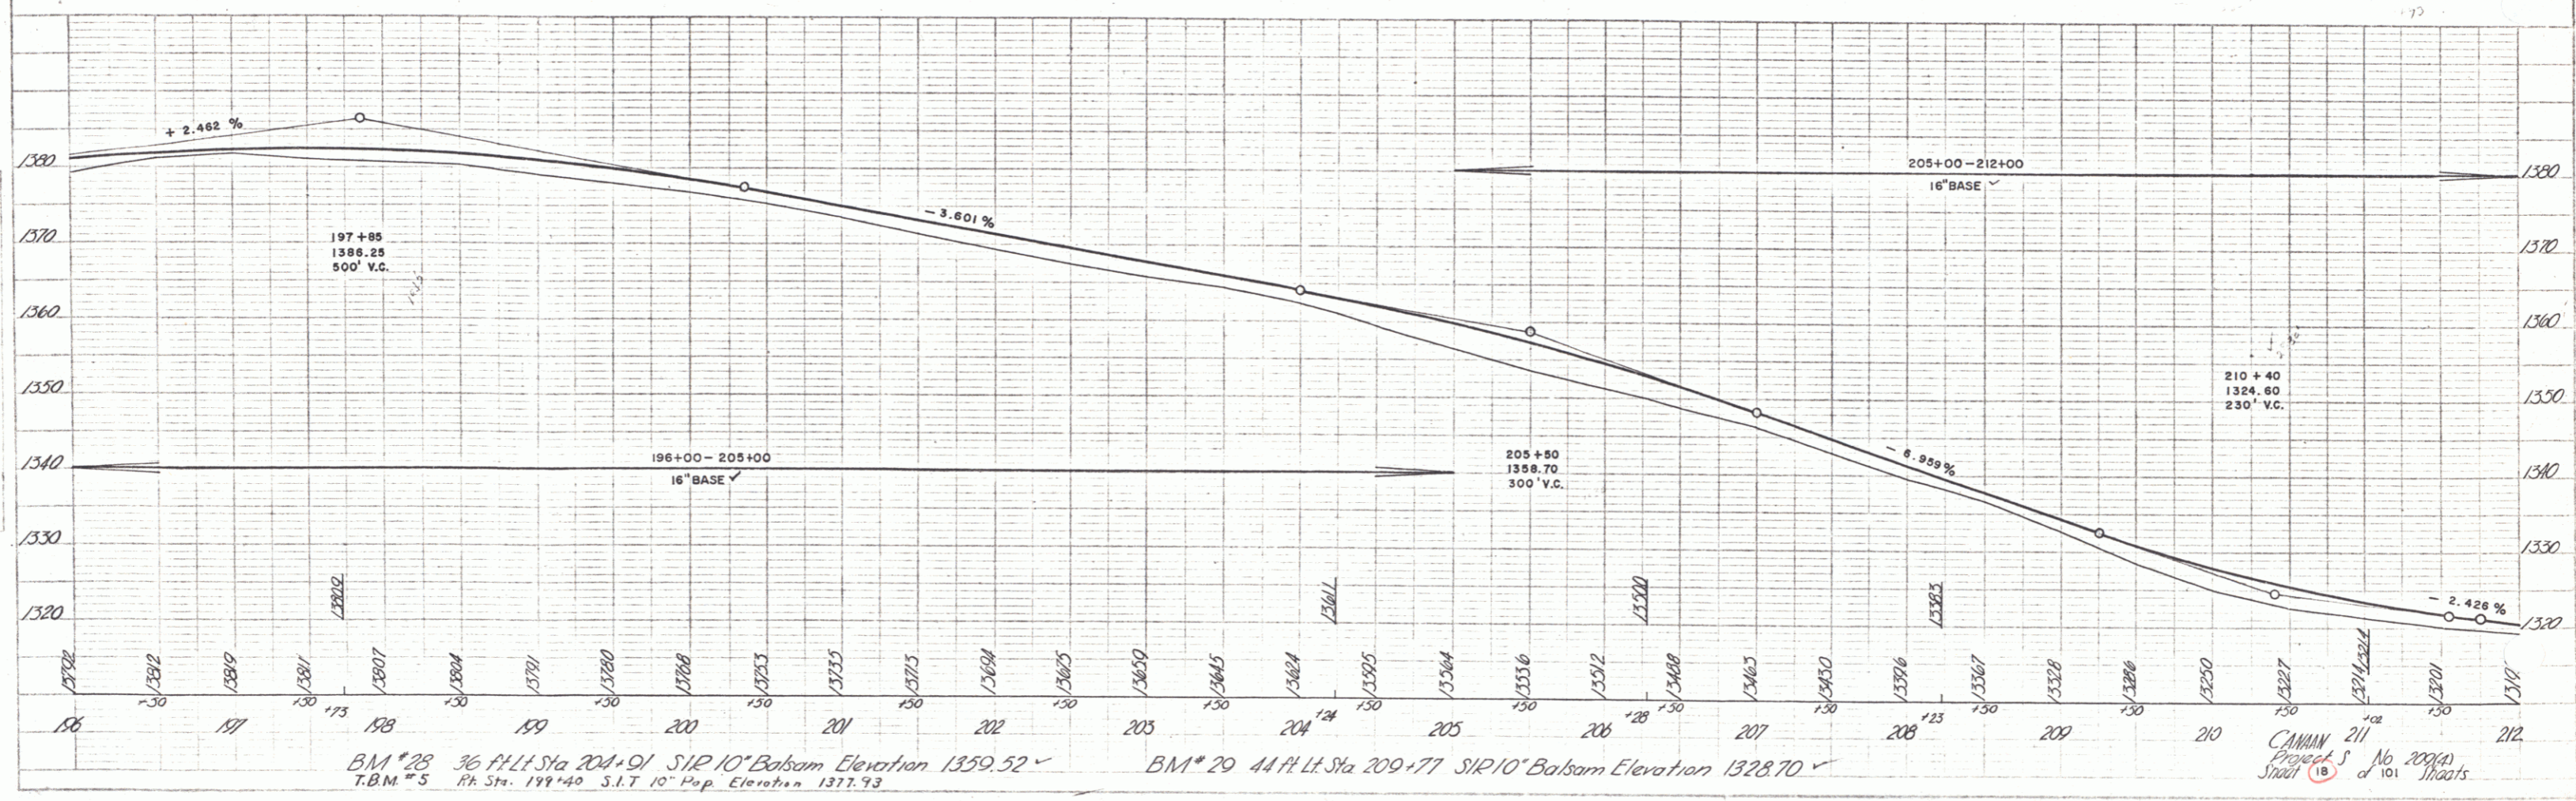


PLAN
 DATE: 10/1/55
 DRAWN BY: HURBY
 CHECKED BY: HURBY

PROFILES
 DATE: 9/20/55
 DRAWN BY: E. WHITE
 CHECKED BY: E. WHITE

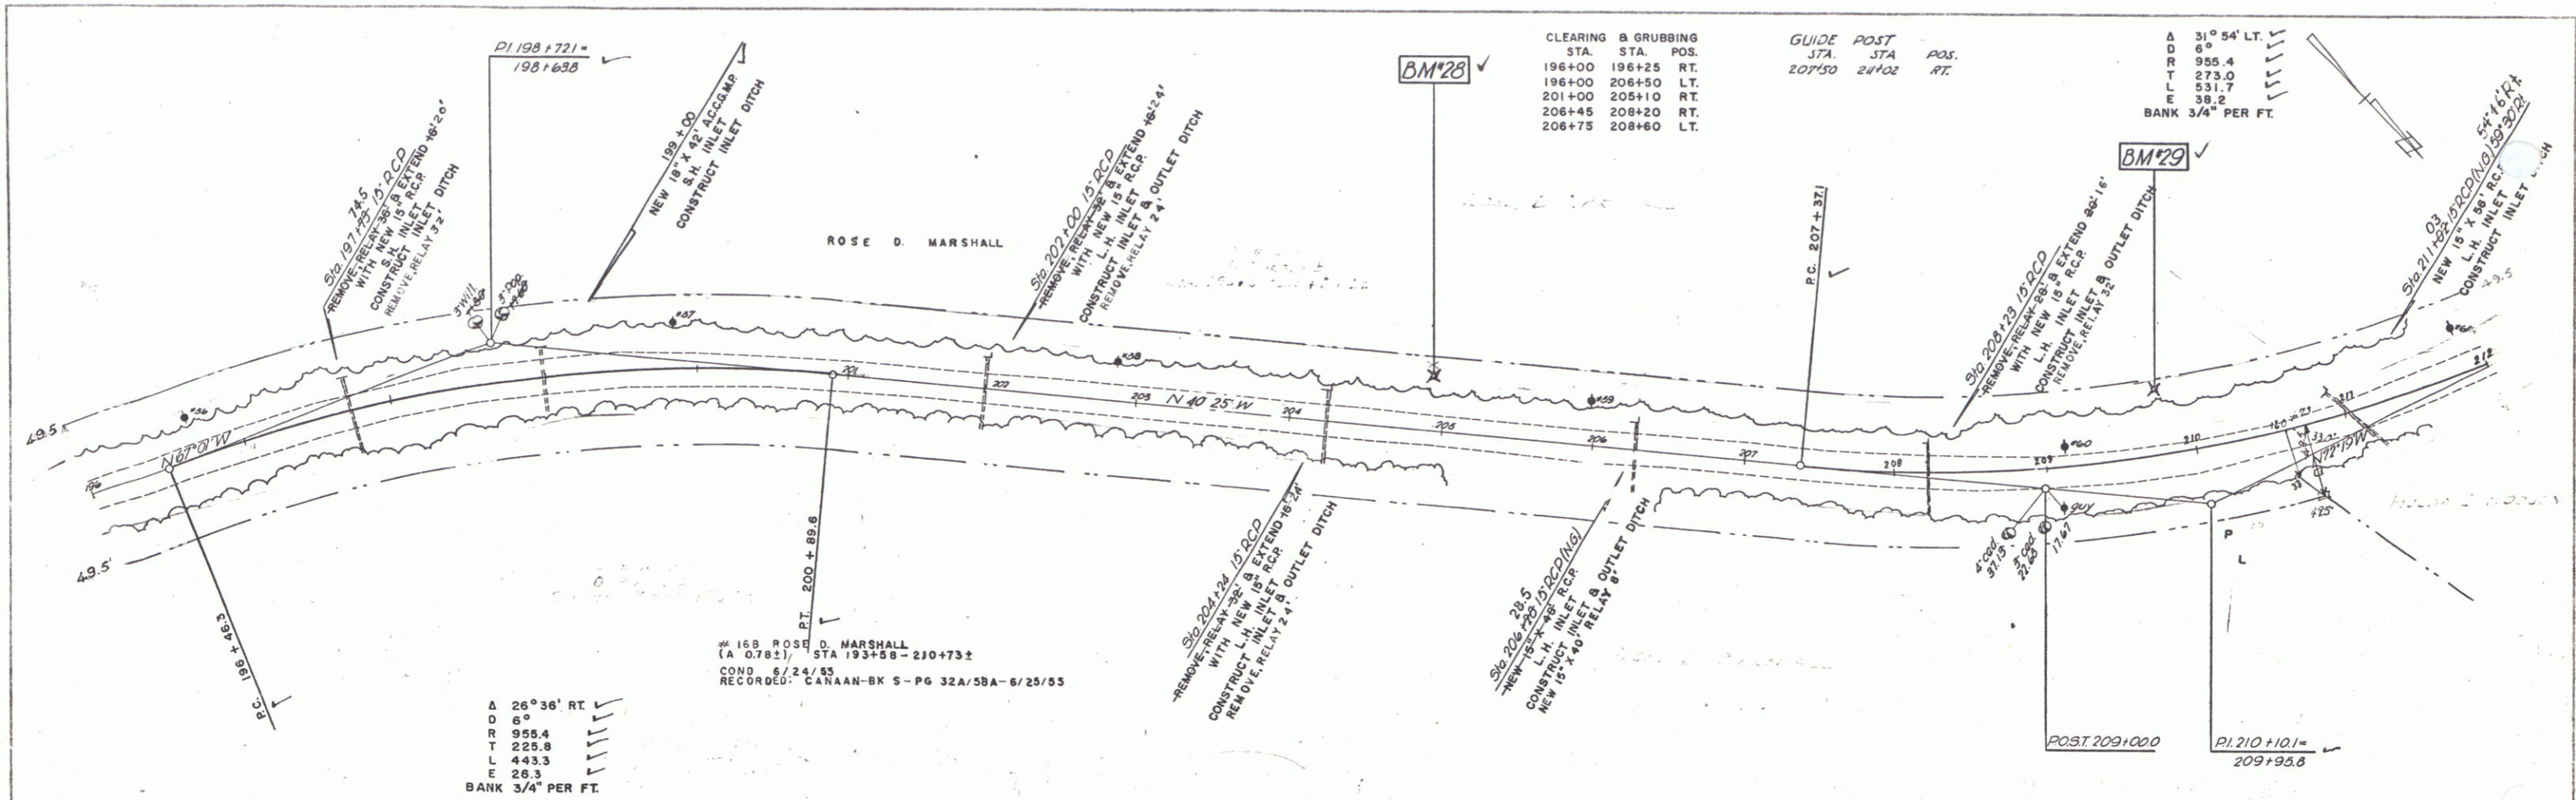

CLEARING & GRUBBING		
STA.	STA.	POS.
196+00	196+25	RT.
196+00	206+50	LT.
201+00	205+10	RT.
206+45	208+20	RT.
206+75	208+60	LT.

GUIDE POST		
STA.	STA.	POS.
20750	20750	RT.

A 26°36' RT
 D 6°
 R 955.4
 T 225.8
 L 443.3
 E 28.3
 BANK 3/4" PER FT.

168 ROSE D. MARSHALL
 (A 0.78%) STA 193+58 - 210+73.2
 COND 6/24/55
 RECORDED: CANAAN-BK S - PG 32A/58A-6/25/55

CANAN
 Project 3 No. 209(4)
 Sheet 10 of 101 Sheets