


RESUBMITTED
WEBSTER-MARTIN INC. 5-54

RESUBMITTED
WEBSTER-MARTIN INC. 5-54

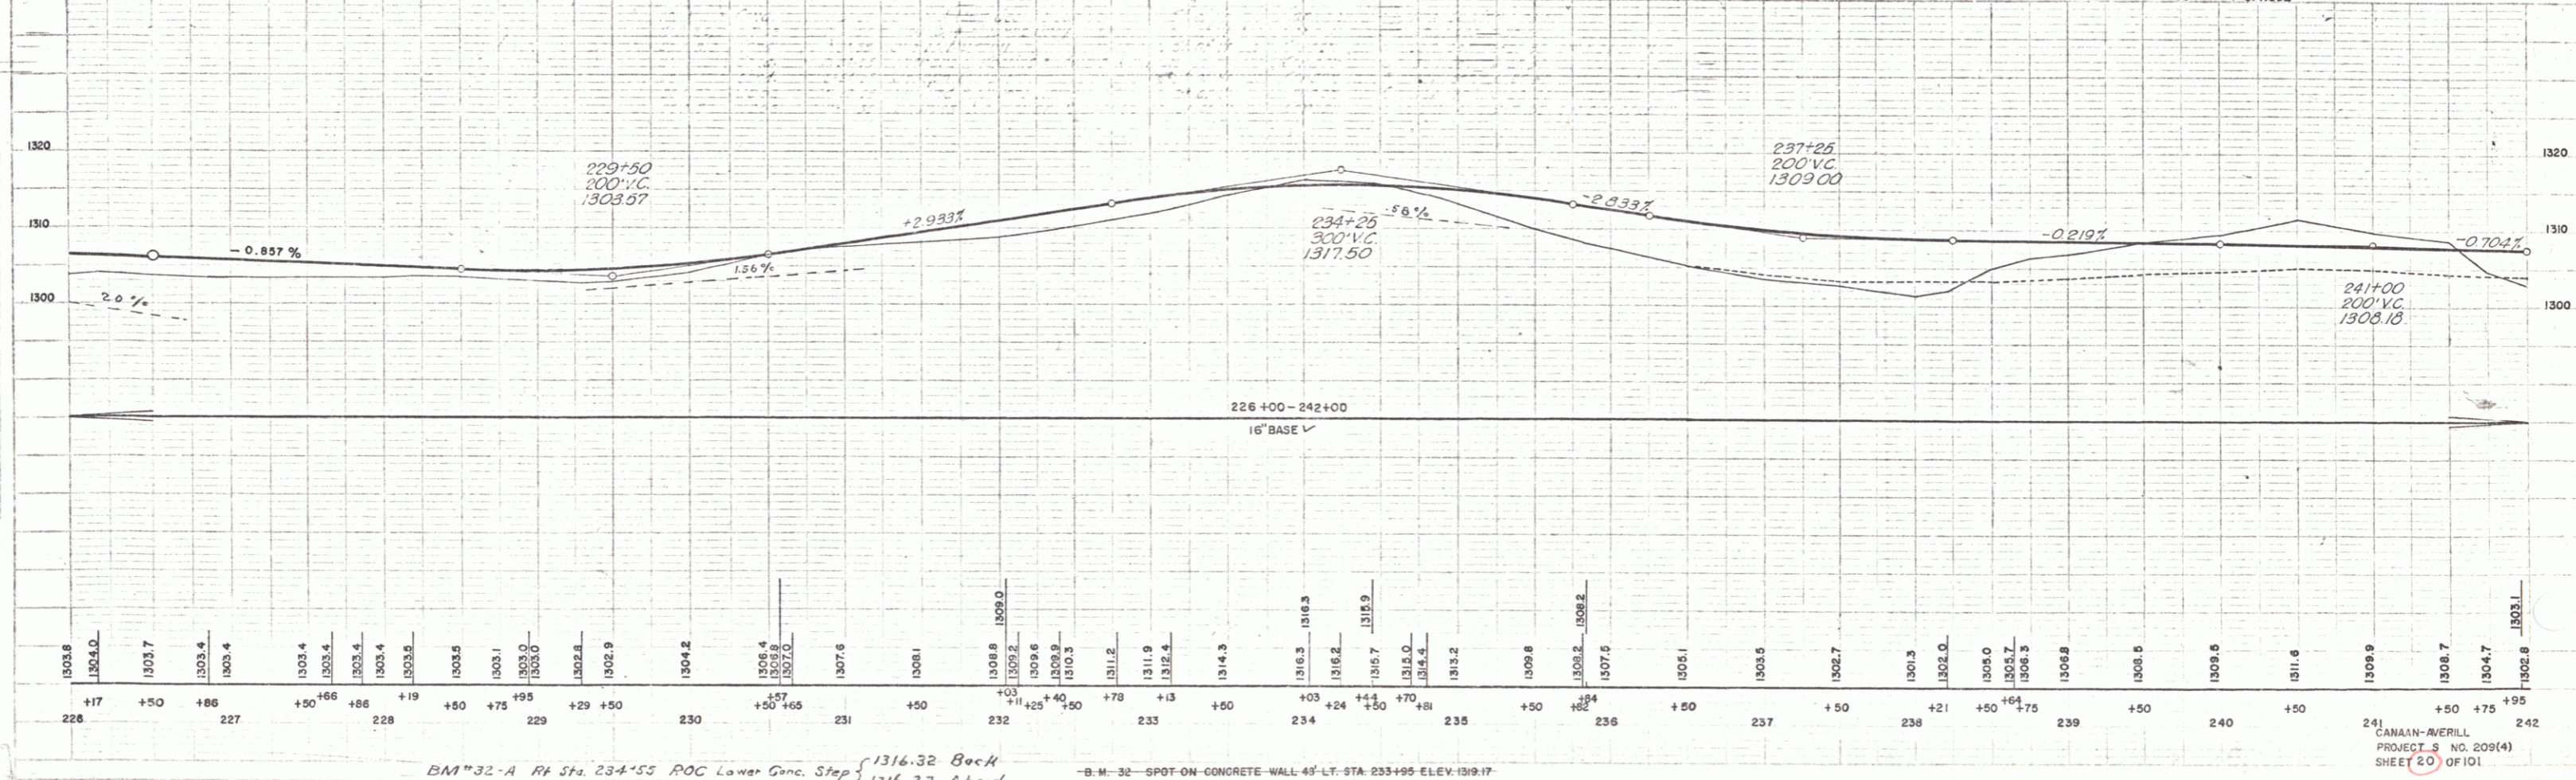

BM 32-A R/F Sta. 234+55 ROC Lower Gnc. Step { 1316.32 Back
1316.23 Ahead

B.M. 32 - SPOT ON CONCRETE WALL 45' LT. STA. 233+95 ELEV. 1309.17

TRANSPLANTING TREES, SHRUBS & VINES, ITEM 632
THE FOLLOWING TREES SHALL BE MOVED UNDER THE ABOVE ITEM AS DIRECTED BY THE ENGINEER

STA	OFFSET LT.	TREE
239+83	36	3" SPRUCE ✓
240+18	38	4" SPRUCE ✓
240+38	31	3" SPRUCE ✓
240+63	35	4" SPRUCE ✓
241+07	42	5" SPRUCE ✓
241+50	61	4" SPRUCE ✓
241+56	23	1 1/2" TWIN BIRCH ✓
242+41	49	4" SPRUCE ✓

Rev. Curve Data
 A 352.21 LT.
 D 8'
 R 716.8
 T 256.3
 L 49.9
 E 44.4

241 CANAAN-AVERILL
 PROJECT NO. 209(4)
 SHEET 20 OF 101