
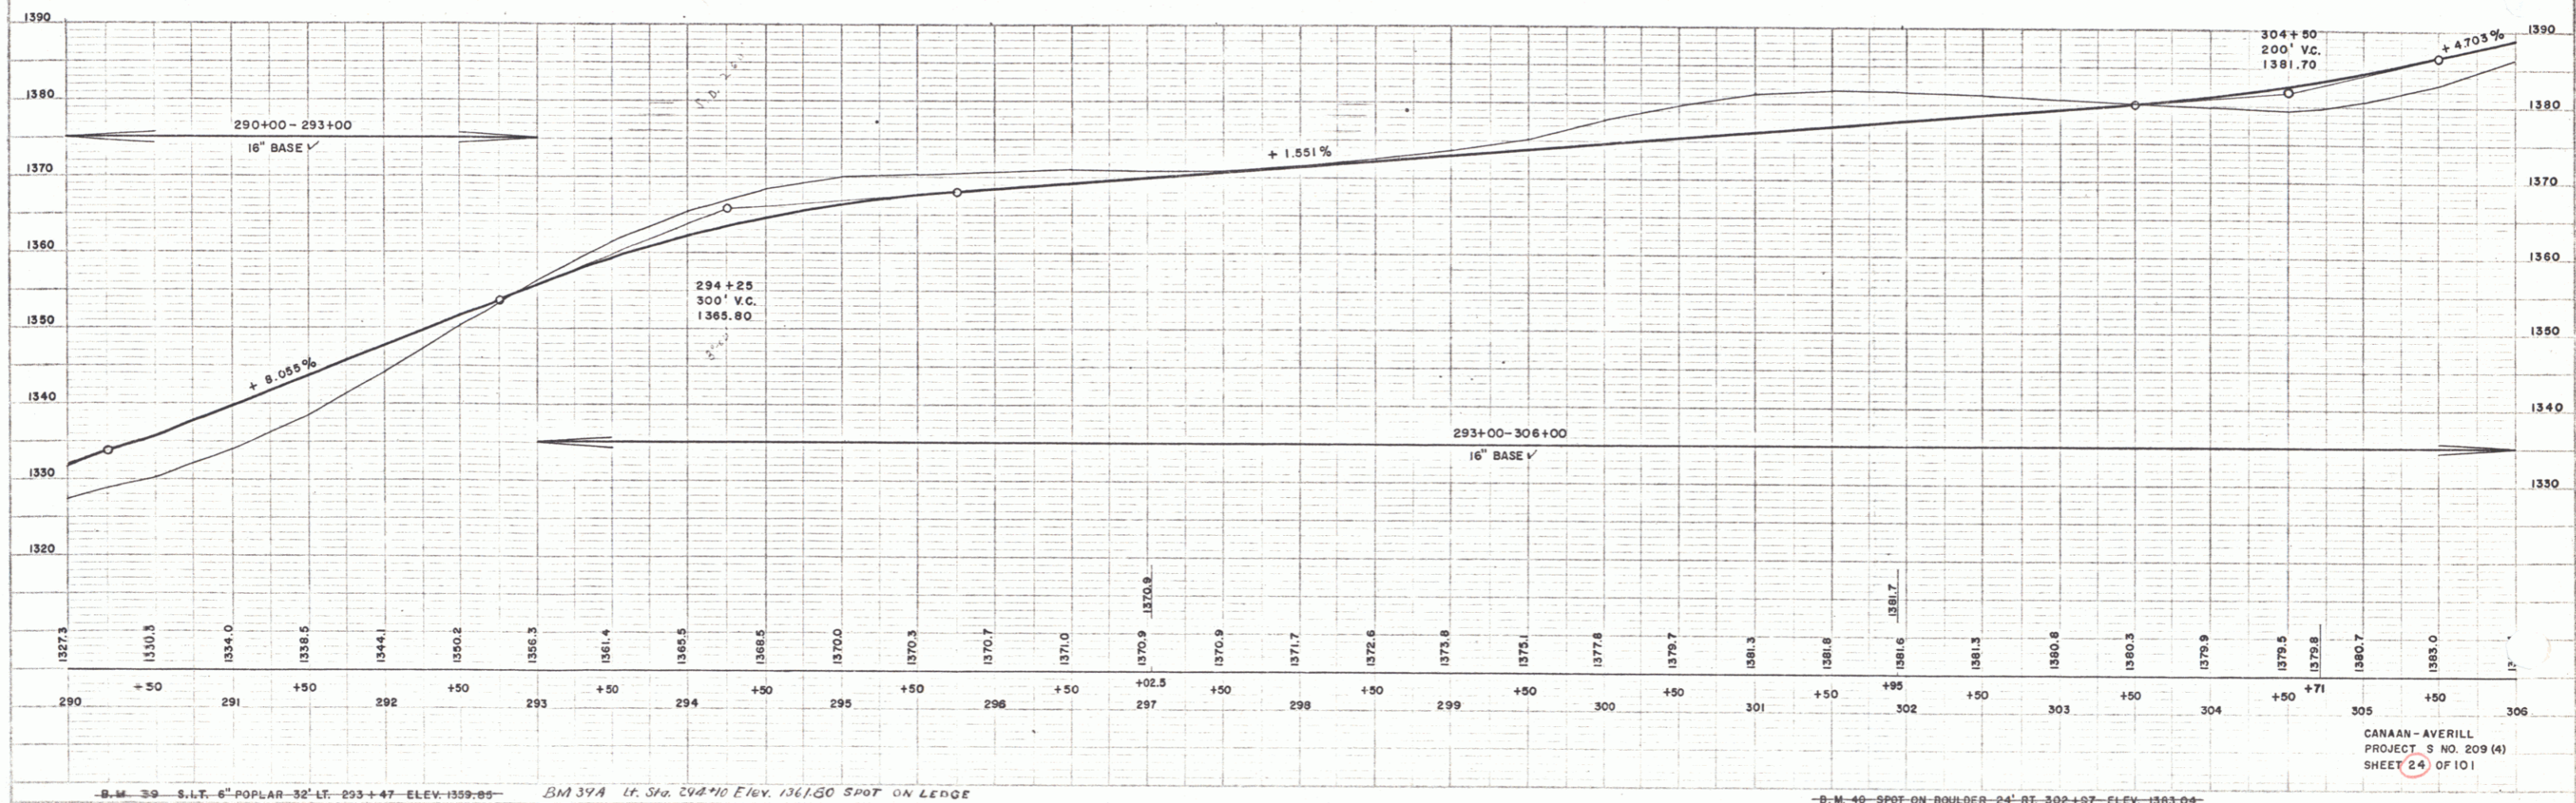


PLAN
 SHEET NO. 24
 PROJECT NO. 209 (4)
 DATE: 6/24/55
 ENGINEER: SPILLING WEBSTER-MARTIN INC.

PROFILE
 SHEET NO. 24
 PROJECT NO. 209 (4)
 DATE: 6/24/55
 ENGINEER: SPILLING WEBSTER-MARTIN INC.

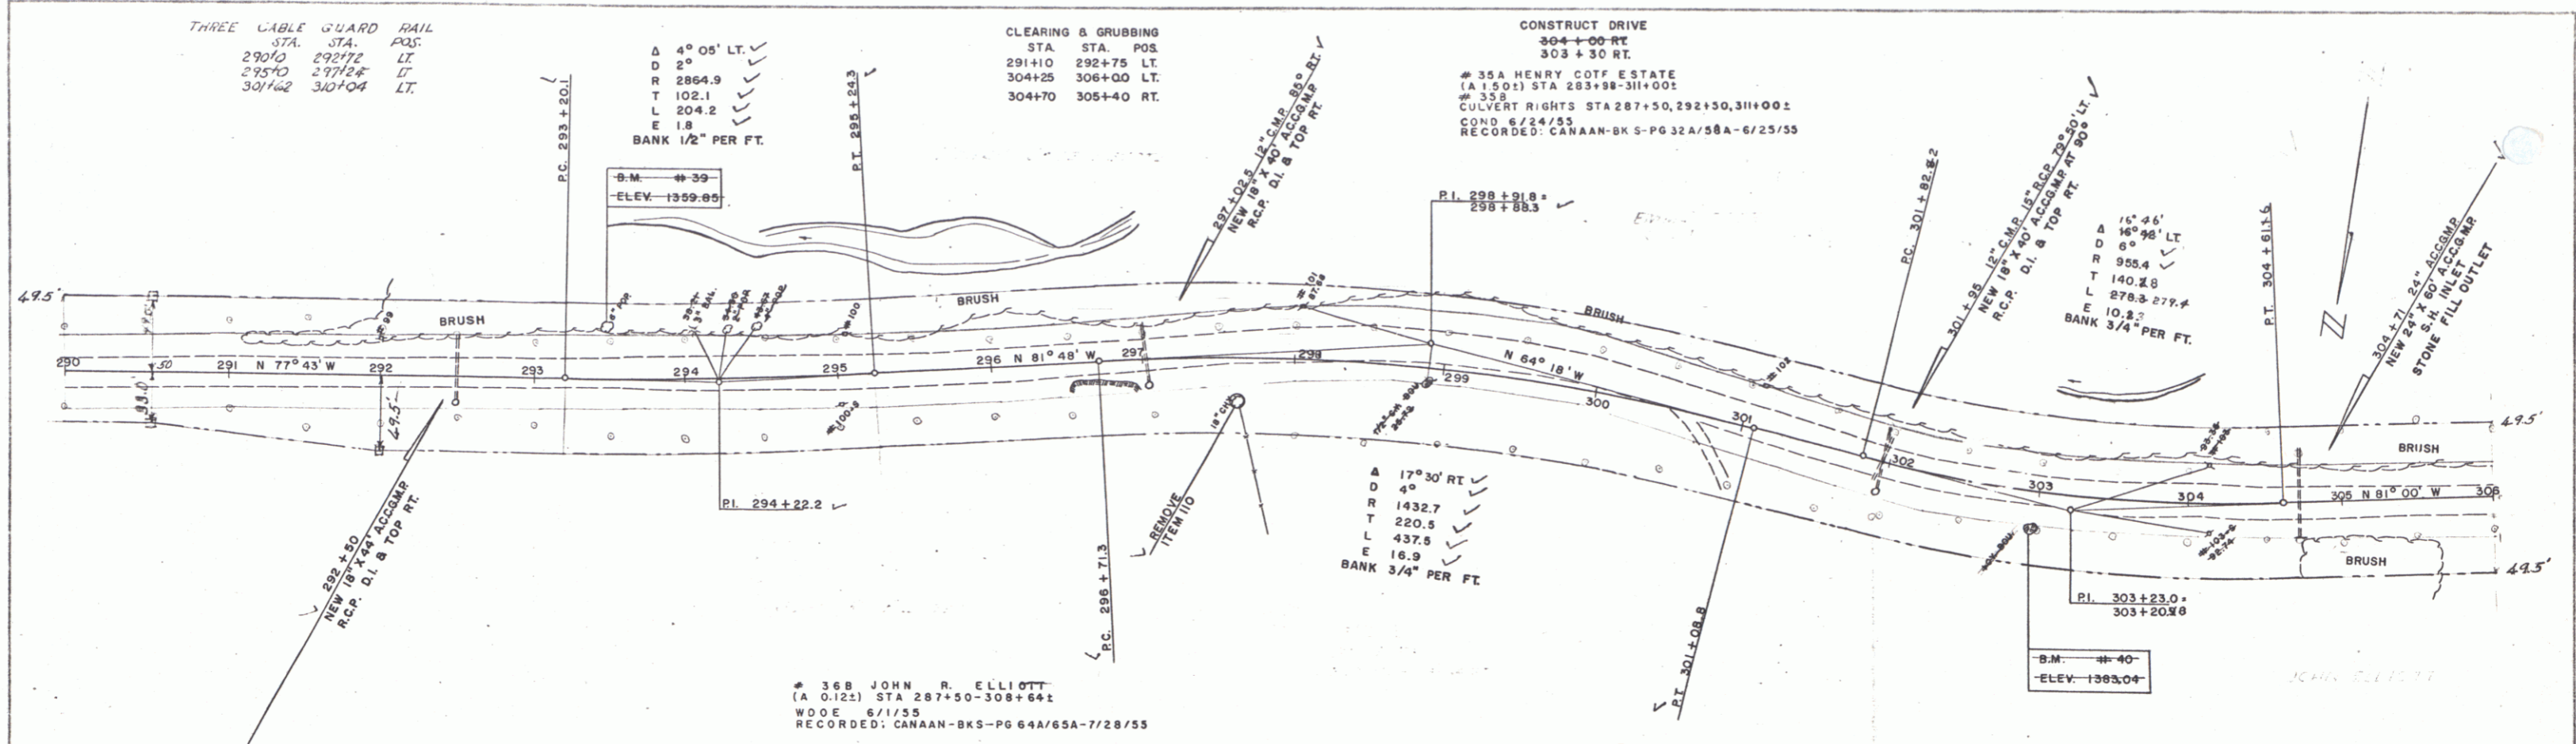

CANAAN-AVERILL
 PROJECT NO. 209 (4)
 SHEET 24 OF 101