



PLAN  
 DELANO WEBSTER-MARTIN INC. 8-54  
 SHEET 29 OF 101

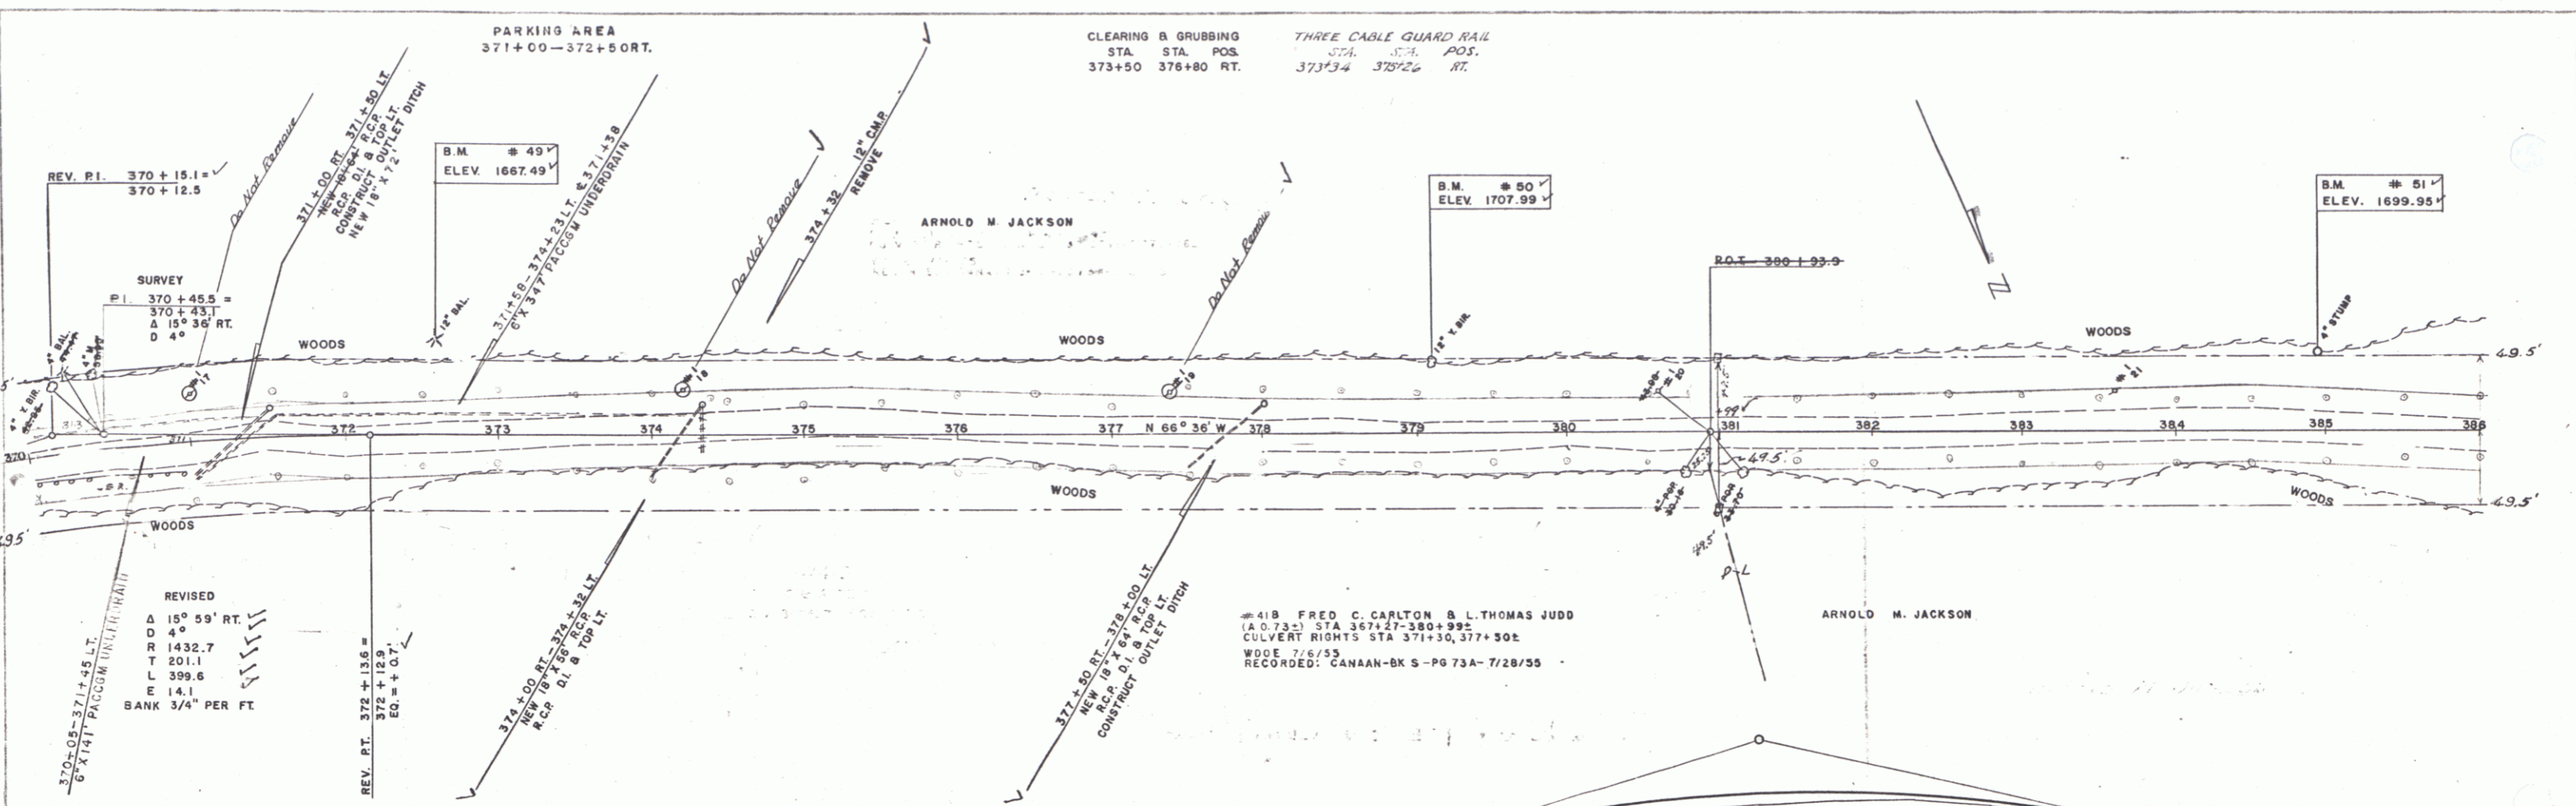

ELEVATION  
 DELANO WEBSTER-MARTIN INC. 8-54  
 SHEET 29 OF 101

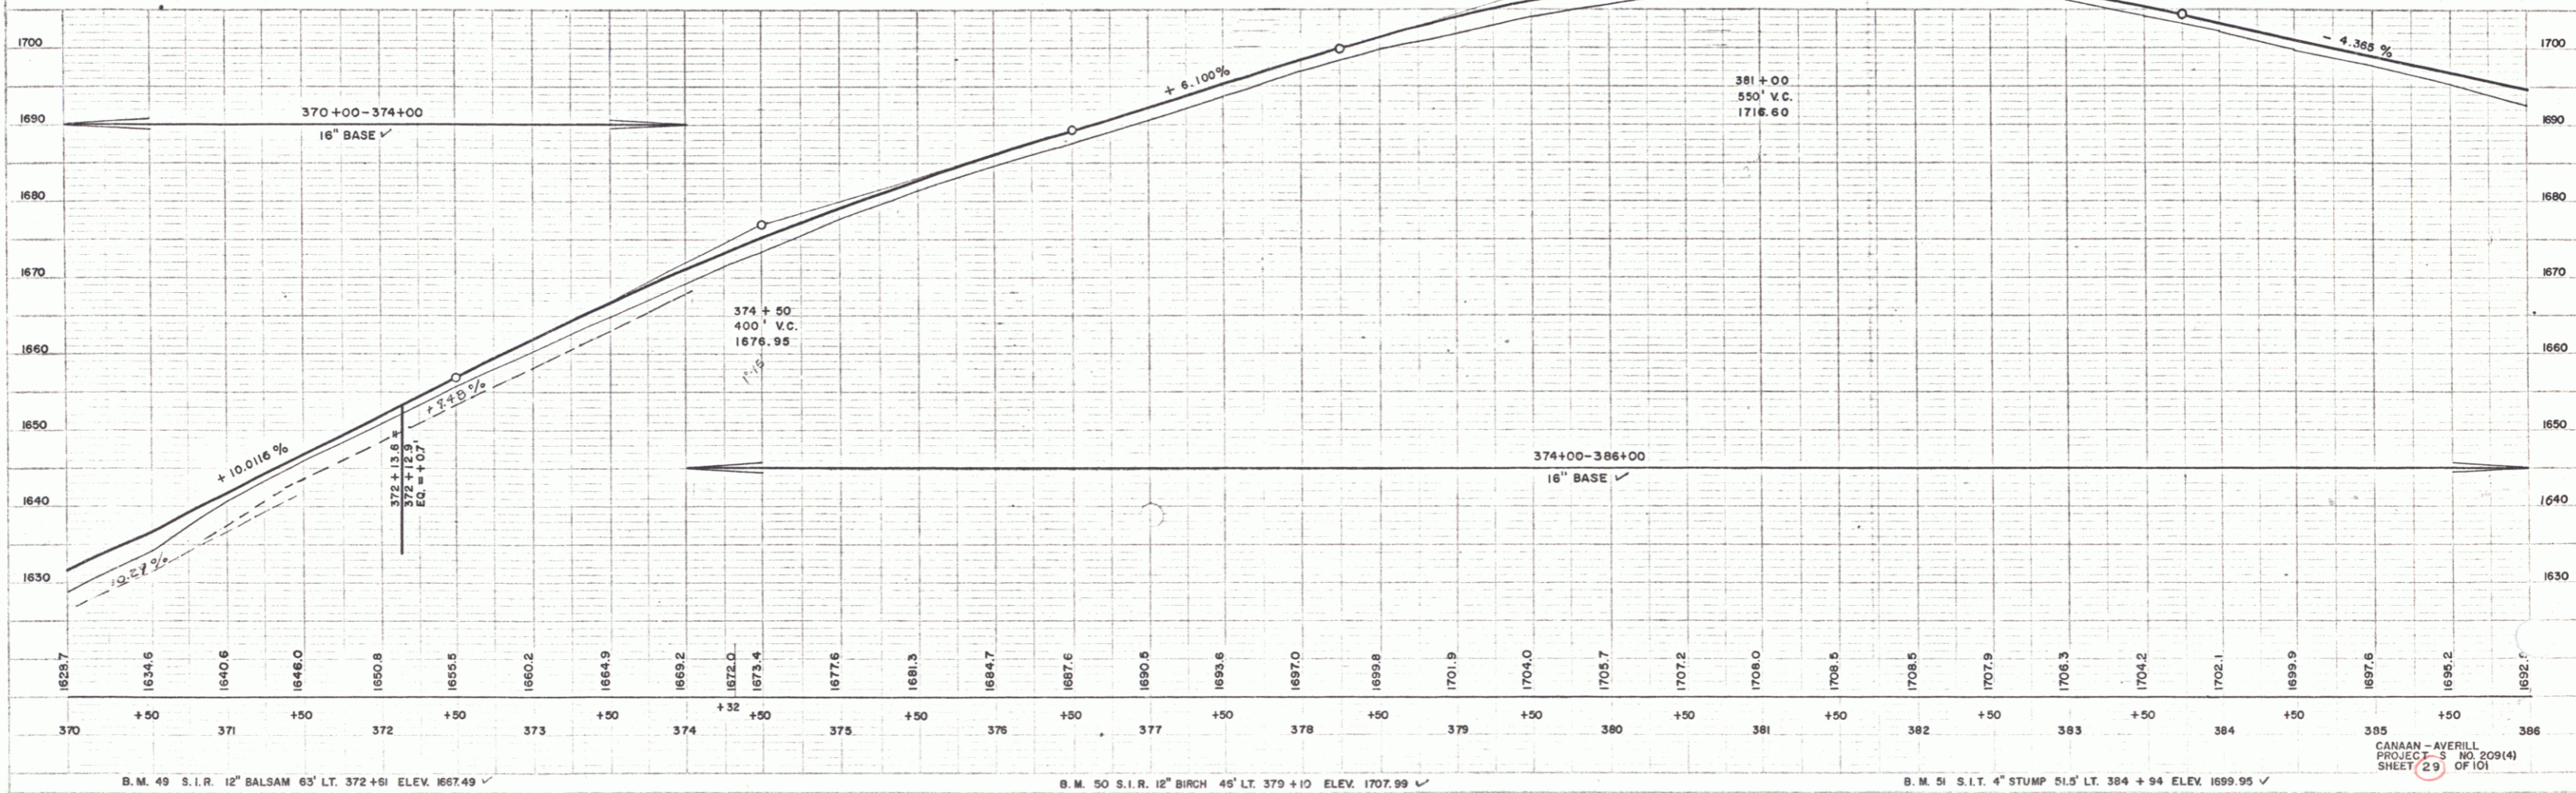

CANAAN-AVERILL  
 PROJECT - S NO 209(14)  
 SHEET 29 OF 101