
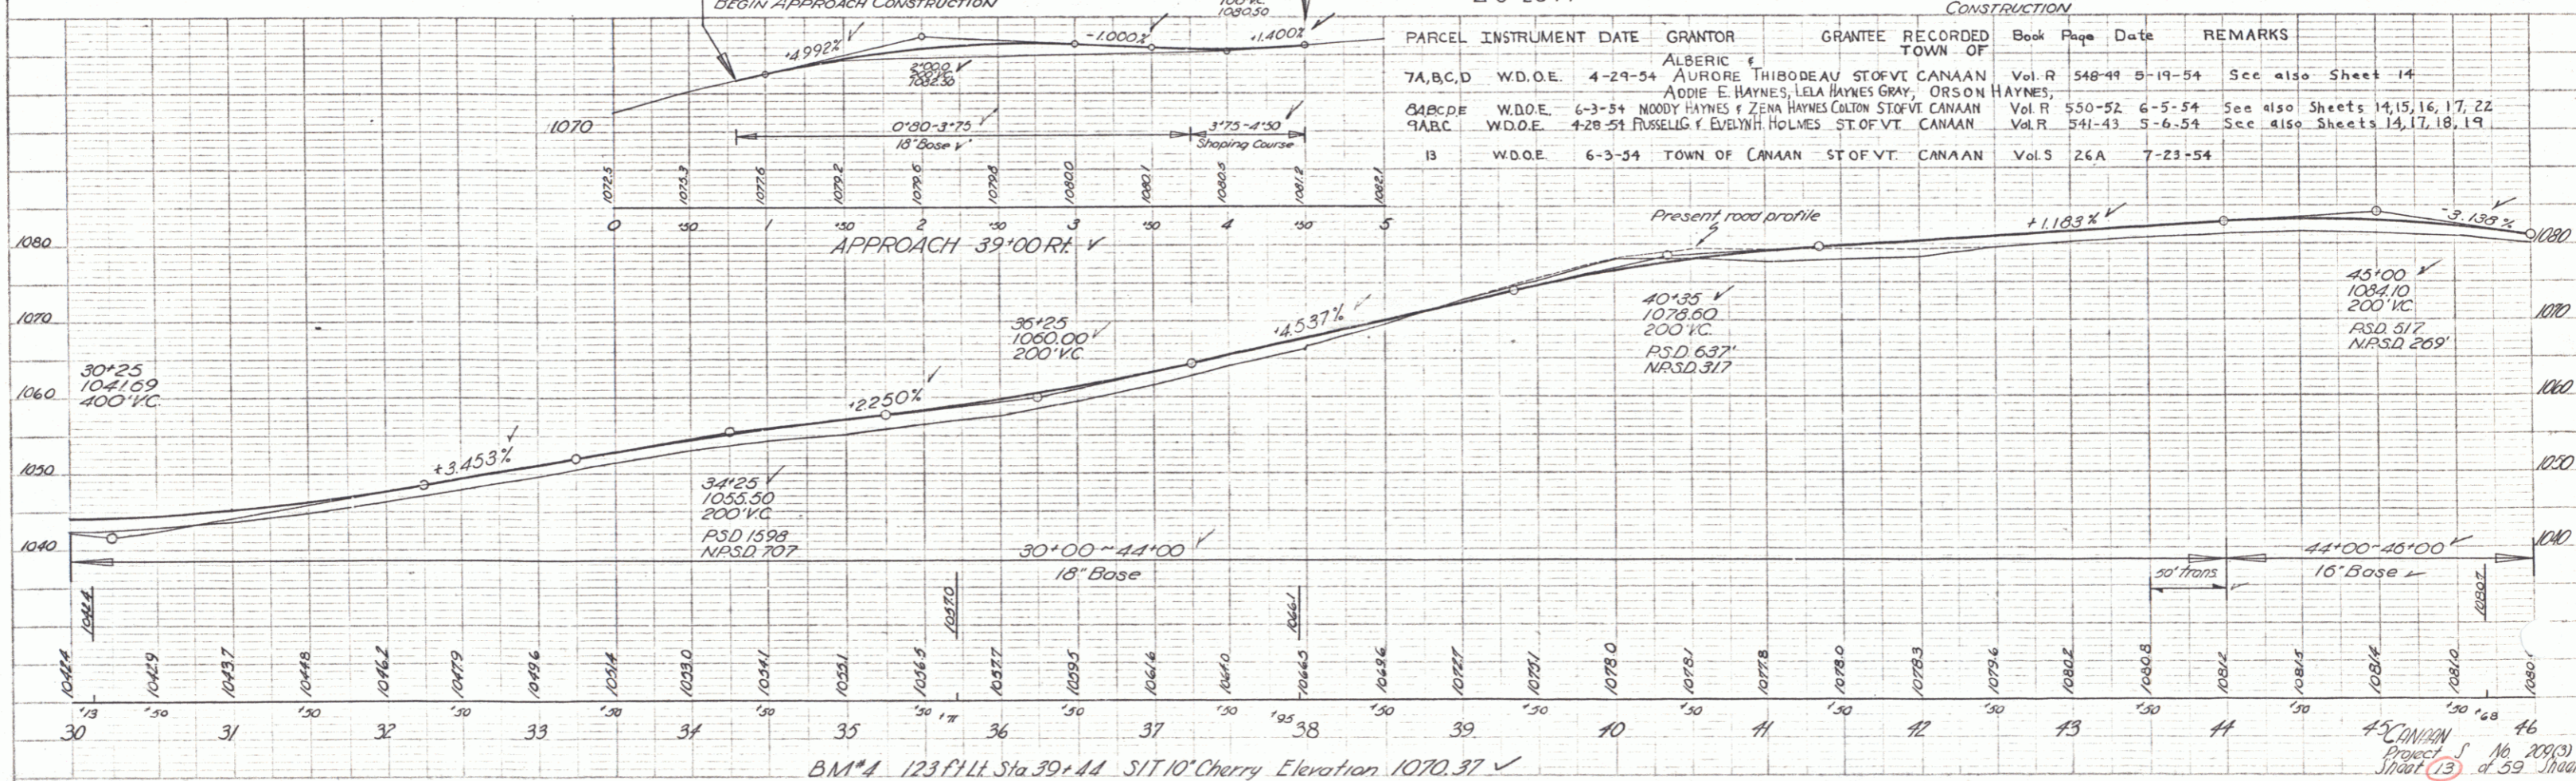


PLAN  
 DATE WORKED: 3/28/58  
 DRAWN BY: Hurley  
 CHECKED BY: E. White

PROFILE  
 DATE WORKED: 3/28/58  
 DRAWN BY: E. White  
 CHECKED BY: E. White

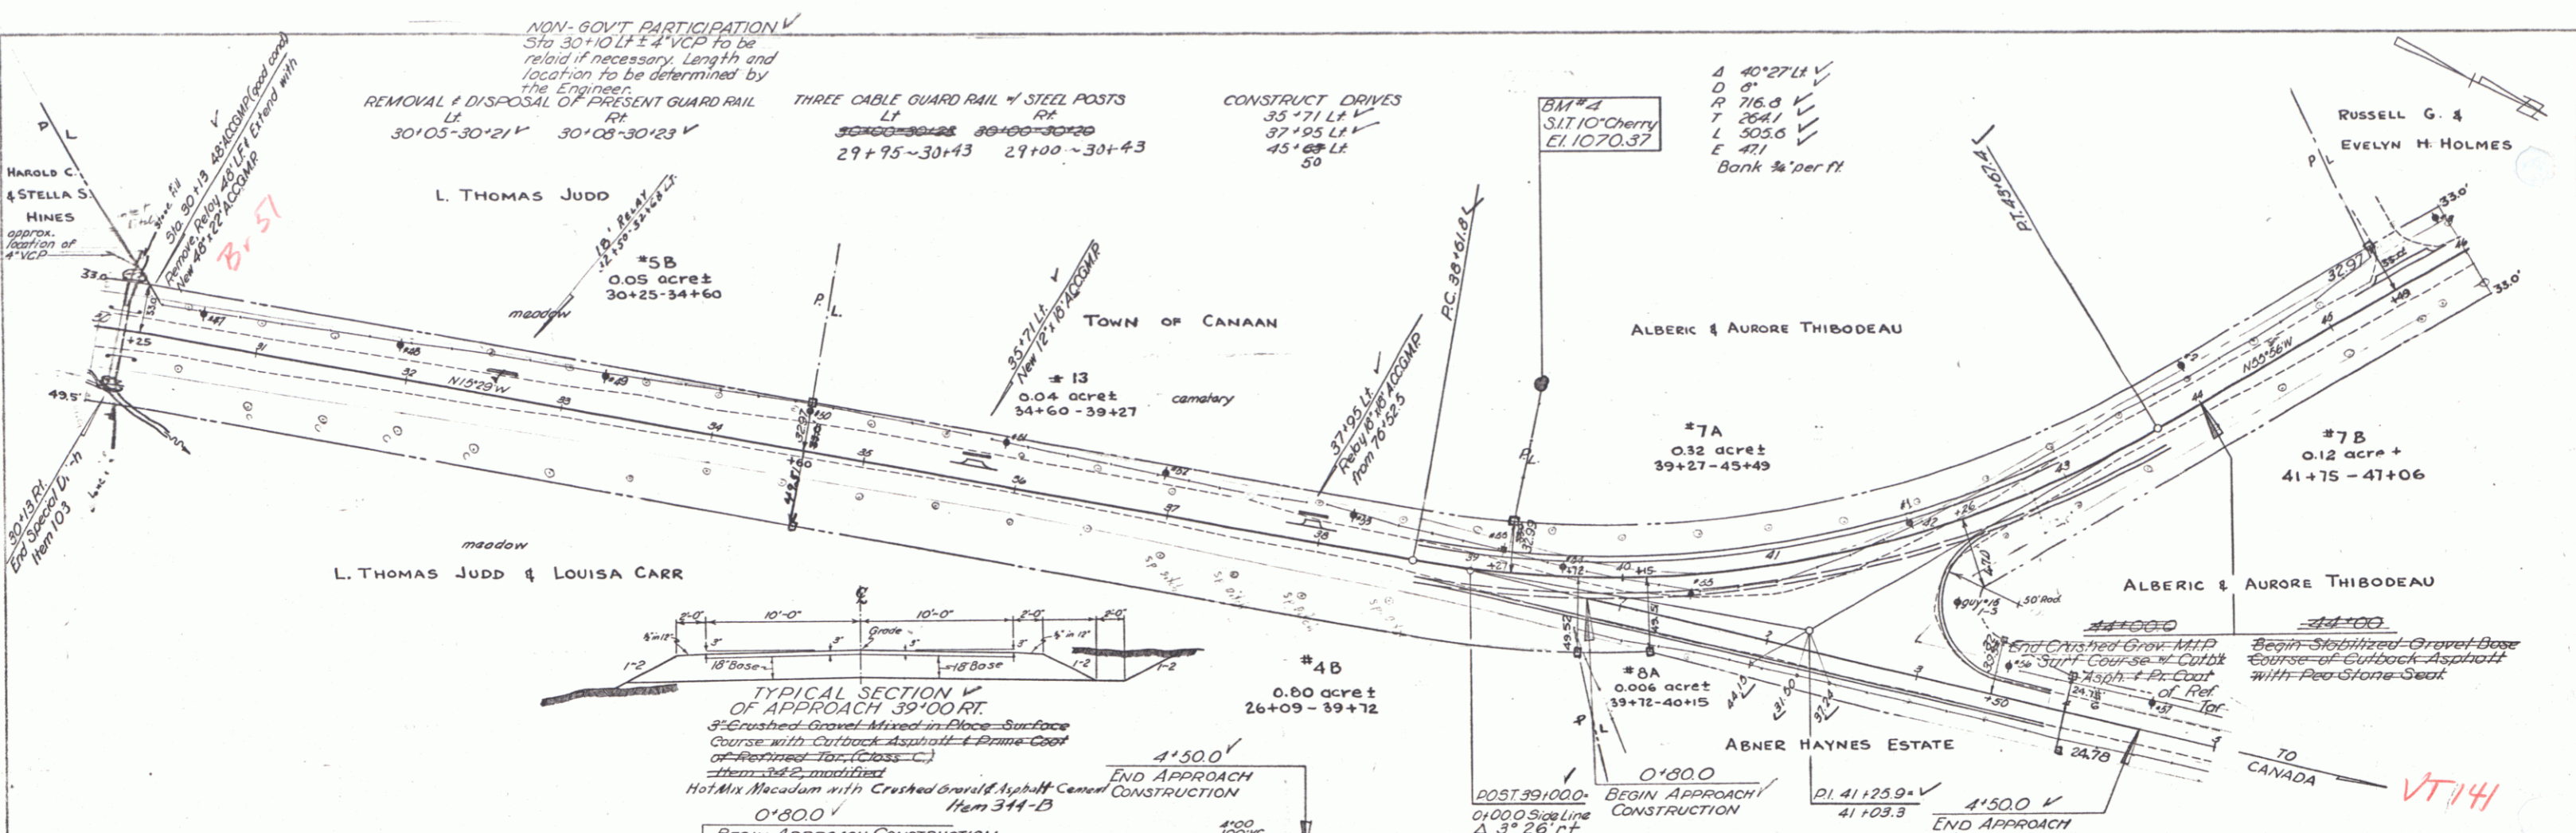

DATE: PLAN PROFILE: 3/28/58  
 DRAWN BY: E. White  
 CHECKED BY: E. White