


PLAN  
 DRAWN BY: B. Palmer  
 CHECKED BY: E. White  
 DATE: 12-28-51  
 SHEET NO. 13-38  
 PROJECT: Traced

PROFILE  
 DRAWN BY: B. Palmer  
 CHECKED BY: E. White  
 DATE: 12-28-51  
 SHEET NO. 13-38  
 PROJECT: Traced

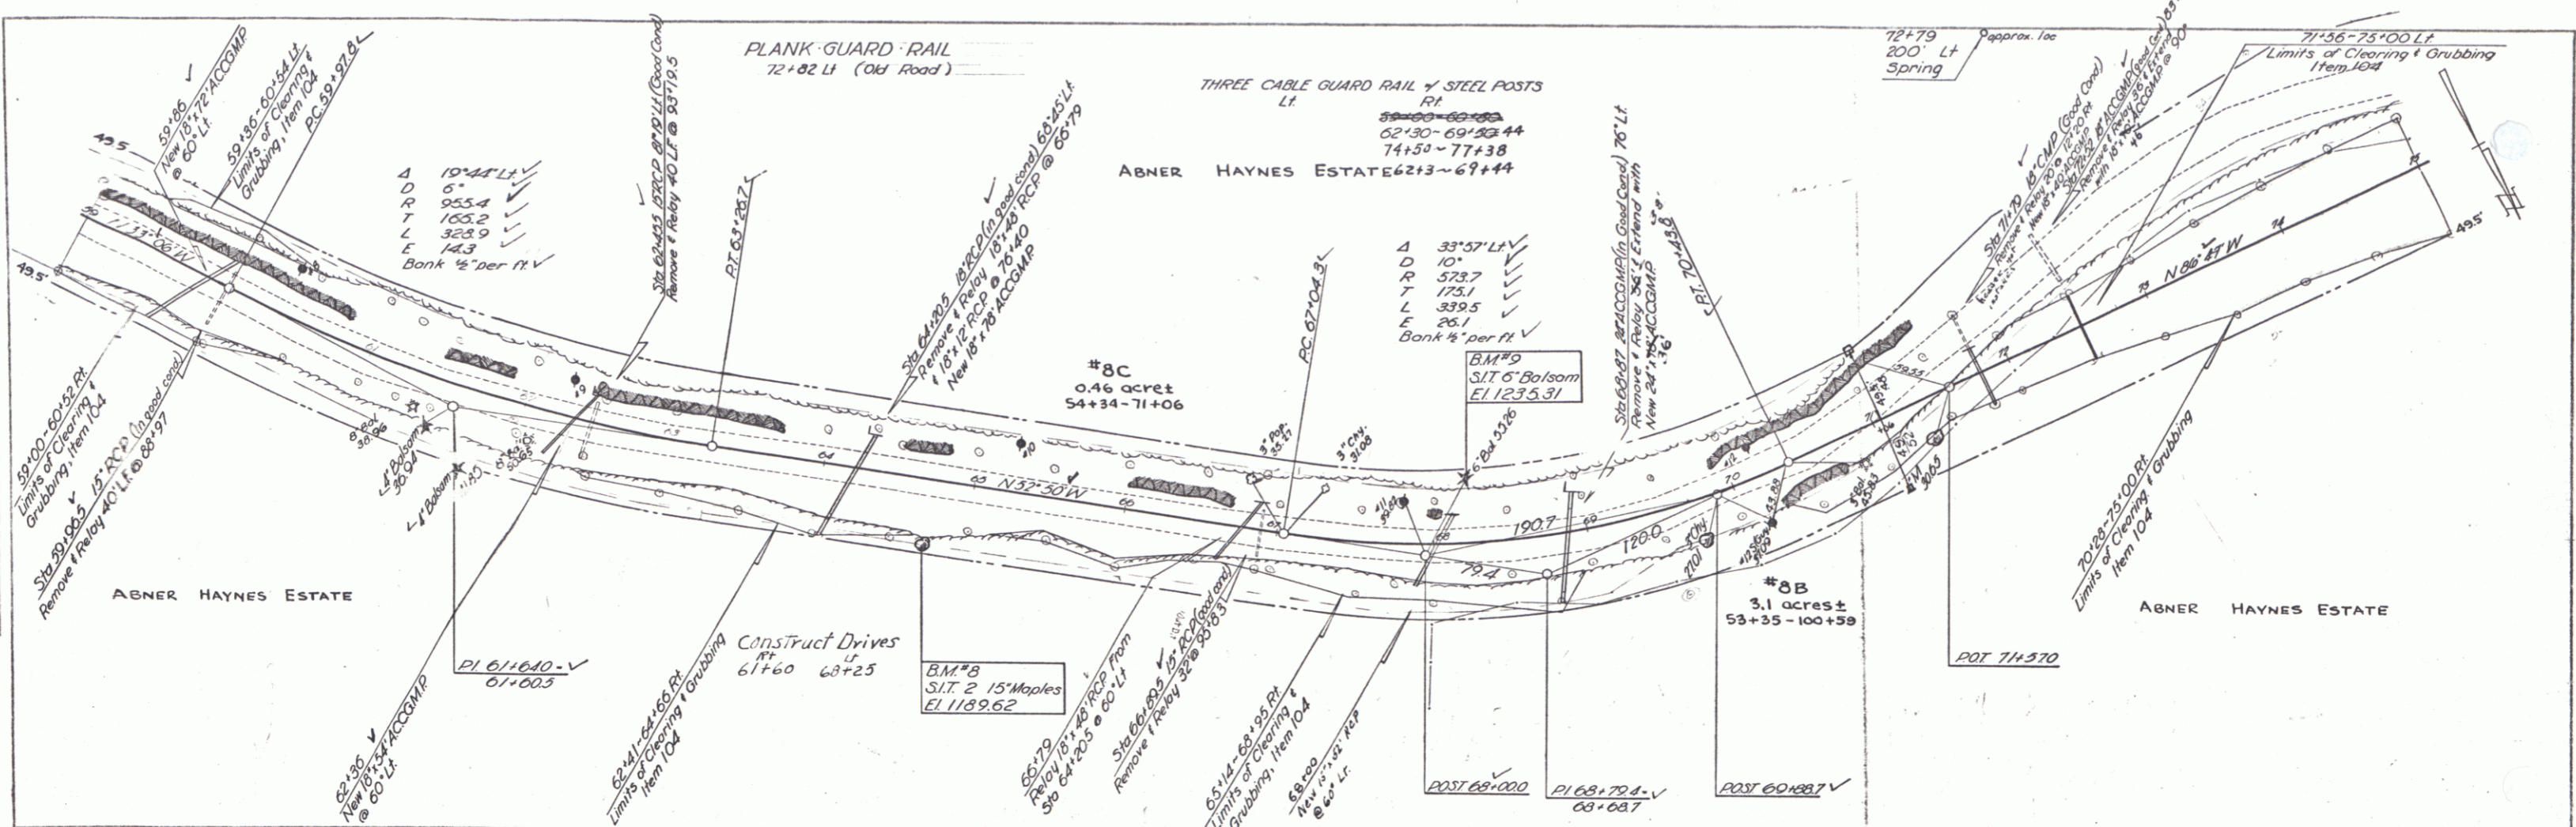

CANNON  
 Project No. 2073  
 Sheet 13 of 59 sheets