



PLAN  
DATE BOOK BY  
3/8/88  
E. White  
5/9/88  
Traced

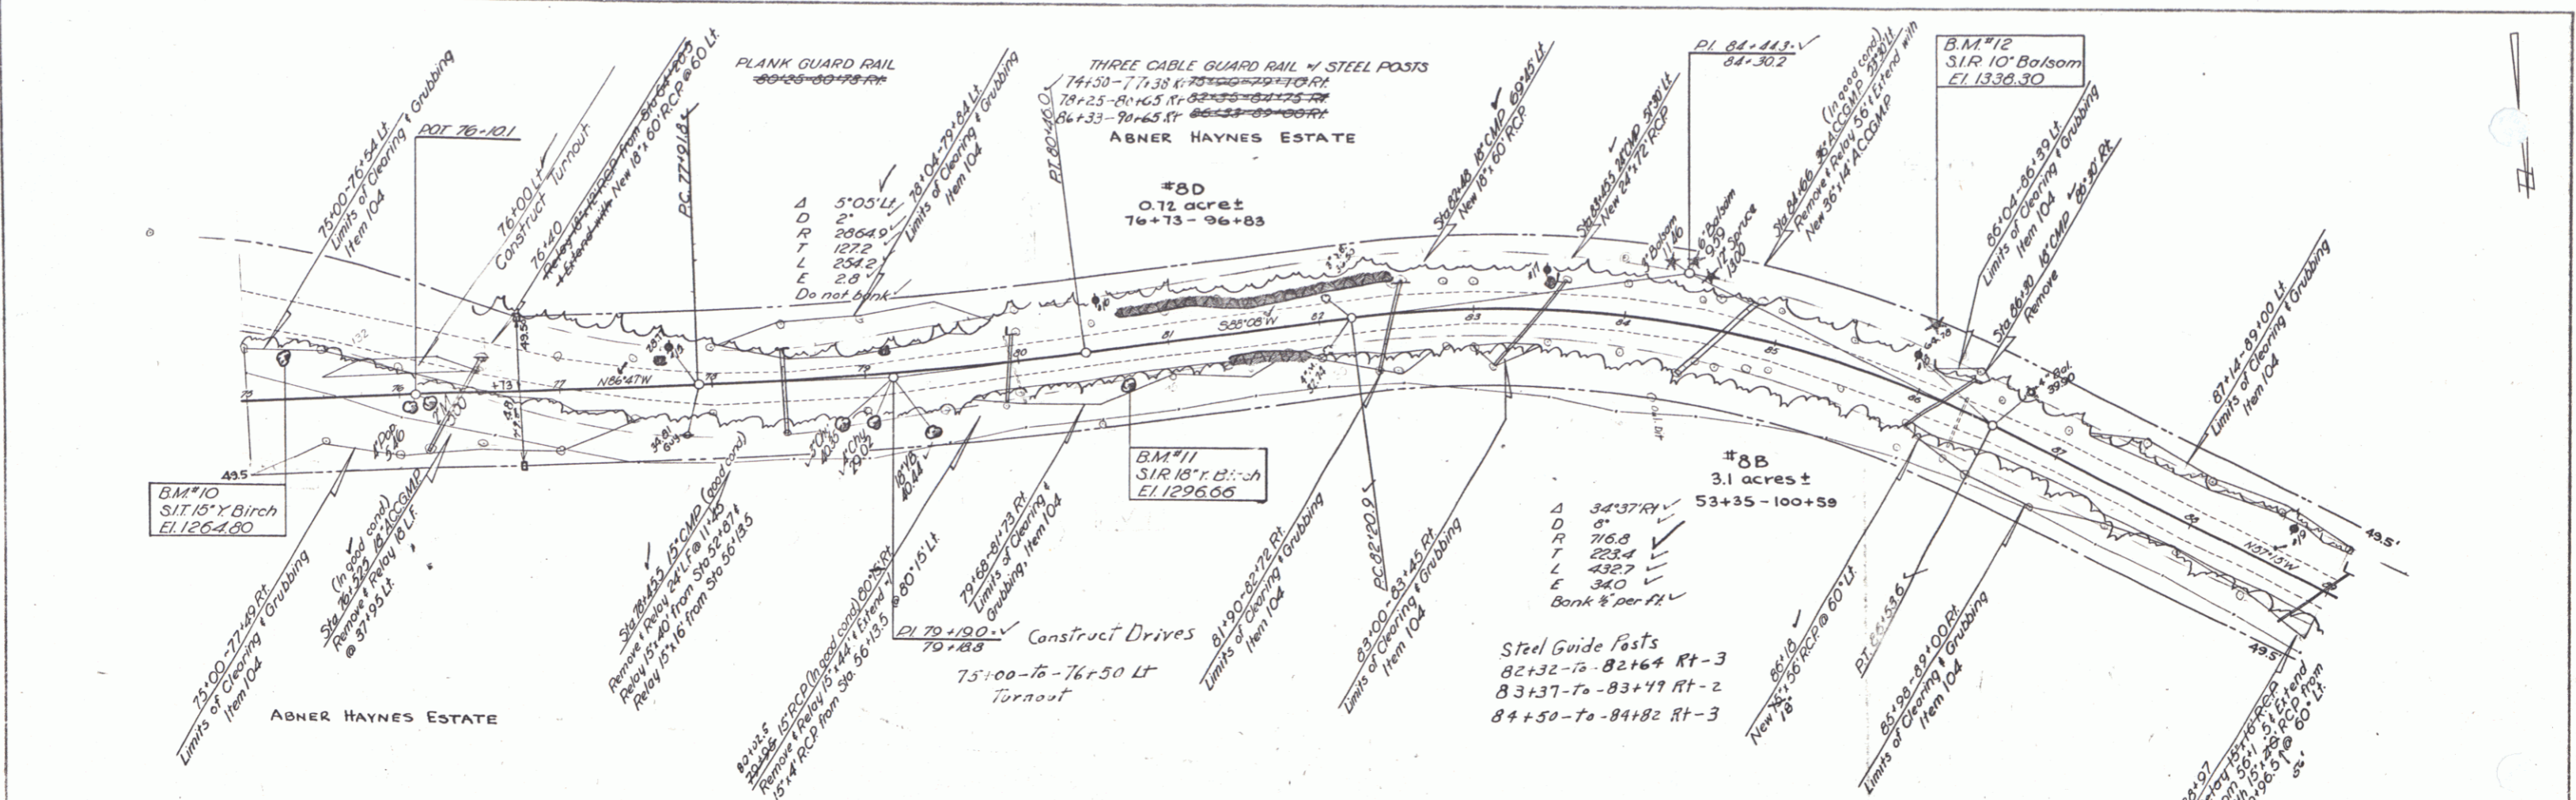

PROFILE  
DATE BOOK BY  
3/8/88  
E. White  
5/9/88

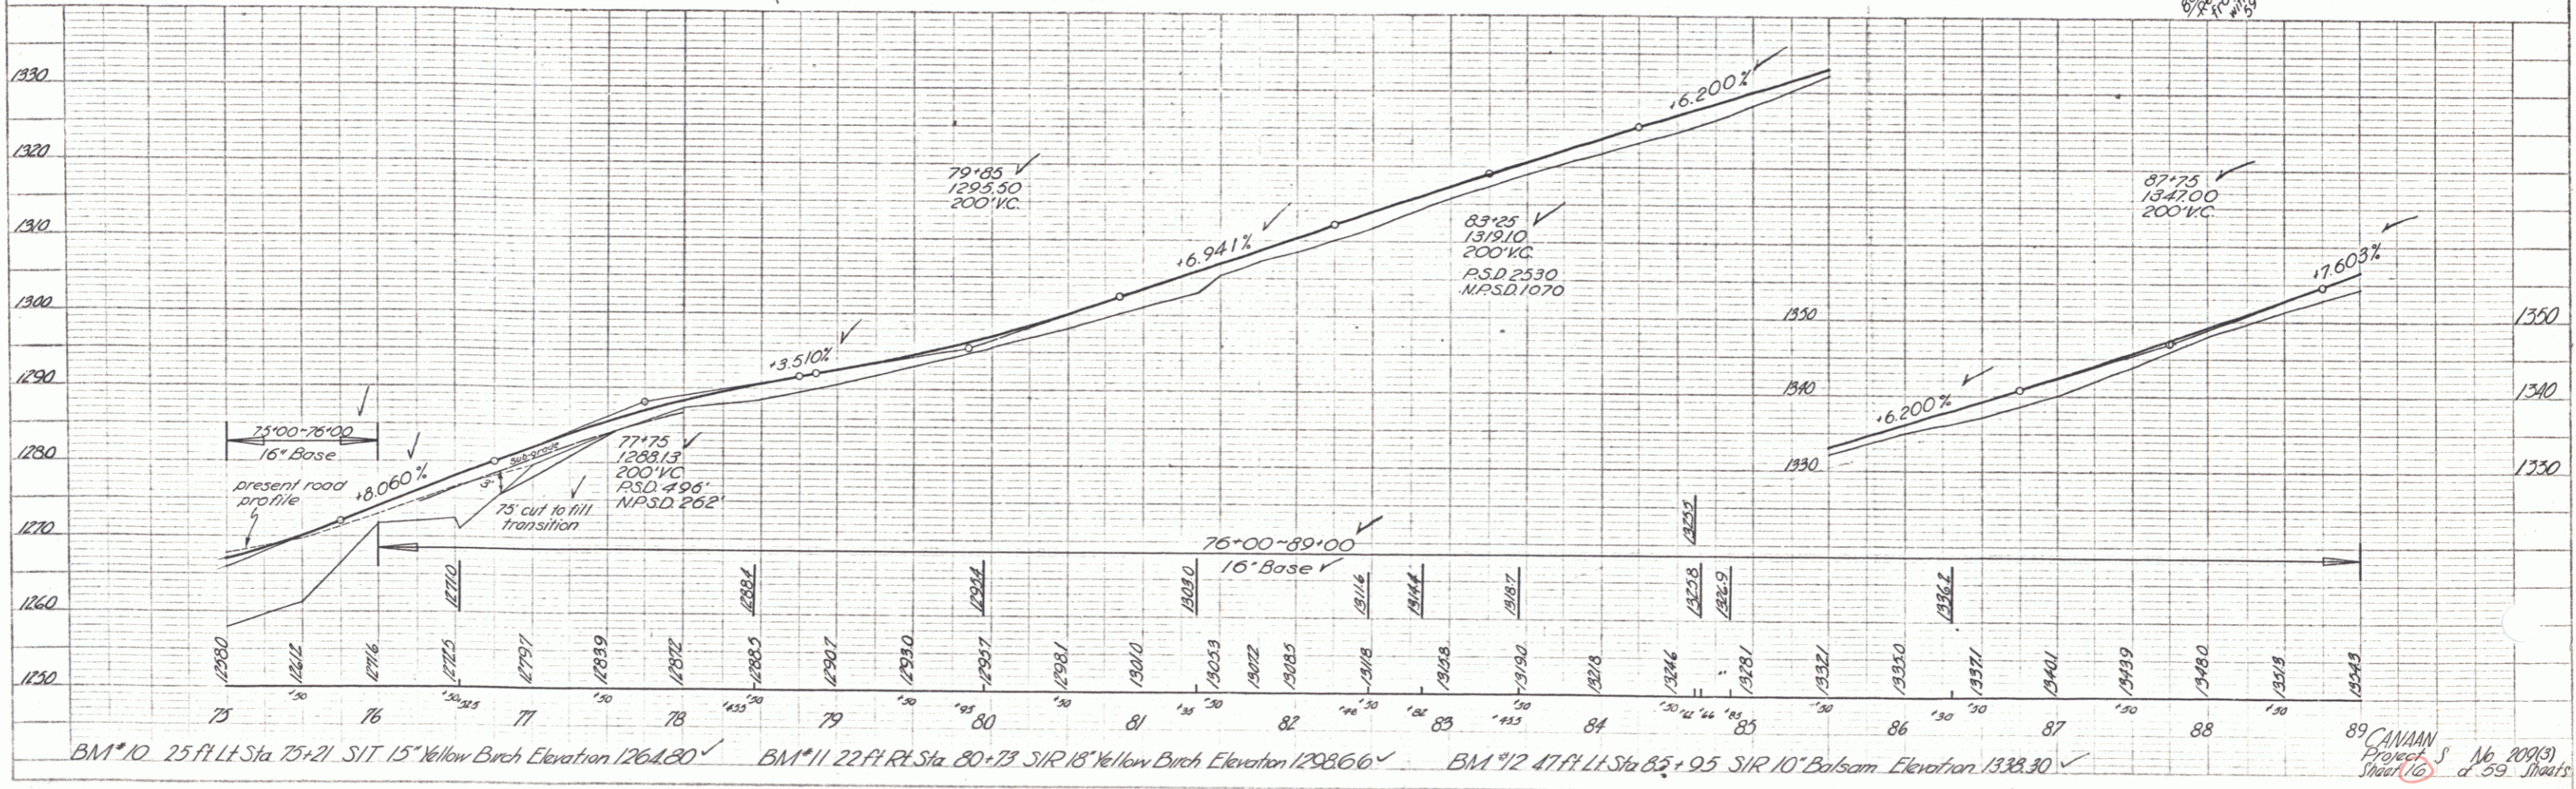

89 CAMMAN  
Project No. 200(3)  
Sheet 16 of 59 Sheets

7 Canada