

INDEX OF SHEETS

SHEET NO. 1	TITLE PAGE
2	BANKING AND WIDENING TABLES
3	TYPICAL SECTIONS
4	TYPICAL SECTIONS
5	QUANTITY SHEET, ITEMS
6	QUANTITY SHEET, DRAINAGE
7-10	EARTHWORKS
11-20	PLAN AND PROFILE SHEETS
21	CONSTRUCTION DETAILS CD DRAINAGE & MARKERS
22	CONSTRUCTION DETAILS CD-1 DITCHES
23	CONSTRUCTION DETAILS CD-2 TYPICAL SLOPE GRADING
24	STANDARD STRUCTURE SHEET S-40 BARRICADES, SIGNS, & LIGHTS
25	STANDARD STRUCTURE SHEET S-48-46 THREE CABLE GUARD RAIL
26-50	CROSS SECTIONS

STANDARD STRUCTURE SHEETS APPROVED BY THE CHIEF ENGINEER, VERMONT STATE DEPARTMENT OF HIGHWAYS, 5-40 JUNE 10, 1950

Hot Mix Macadam with Crushed Gravel / Asphalt Cement Item 311-B

**STATE OF VERMONT
DEPARTMENT OF HIGHWAYS**

PROPOSED IMPROVEMENT

SECONDARY PROJECT


TOWN OF CANAAN

COUNTY OF ESSEX

VERMONT ROUTE 114


CANAAN-AVERILL ROAD

PROJECT NAME & NUMBER	CANAAN S 209 (3)	TYPE	HOT MIX MACAD.	PAVEMENT AREA	30.111 S.Y.
RECORD PLANS					
MATERIALS					
SUB-BASE OF GRAVEL	PAQUETTE PIT CLARKSVILLE, N.H.	G.R. CABLE	AM. STEEL & WIRE CO., NEW HAVEN, CONN.		
CUTBACK ASPHALT	ESSO CO., EVERETT, MASS.	G.R. PAINT	BRADLEY LABS., BRATTLEBORO		
R.C.P.	VT. CONC. PIPE CORP., WINDSOR	MACADAM AGG.	PAQUETTE PIT CLARKSVILLE, N.H.		
ACC.G.M.P.	N.E. MET. CULVERT CO., BOSTON, MASS.	6" UNDERDRAIN	N.E. MET. CULV. CO., BOSTON, MASS.		
PEN. ASPHALT	AMBITUMULES CO. E. PROV. R.I.				
CONTRACTOR	H. J. O'CONNELL, LTD.	CONTRACT DATED	JUNE 8, 1954		
RESIDENT ENGR	R. WOODWARD	CONTRACT STARTED	JUNE 15, 1954		
INSPECTORS	H. MILES	CONTRACT COMPLETED	OCT. 6, 1955		
RECORD PLANS	KAMBOUR-WOODWARD	CONTRACT ACCEPTED	OCT. 6, 1955		

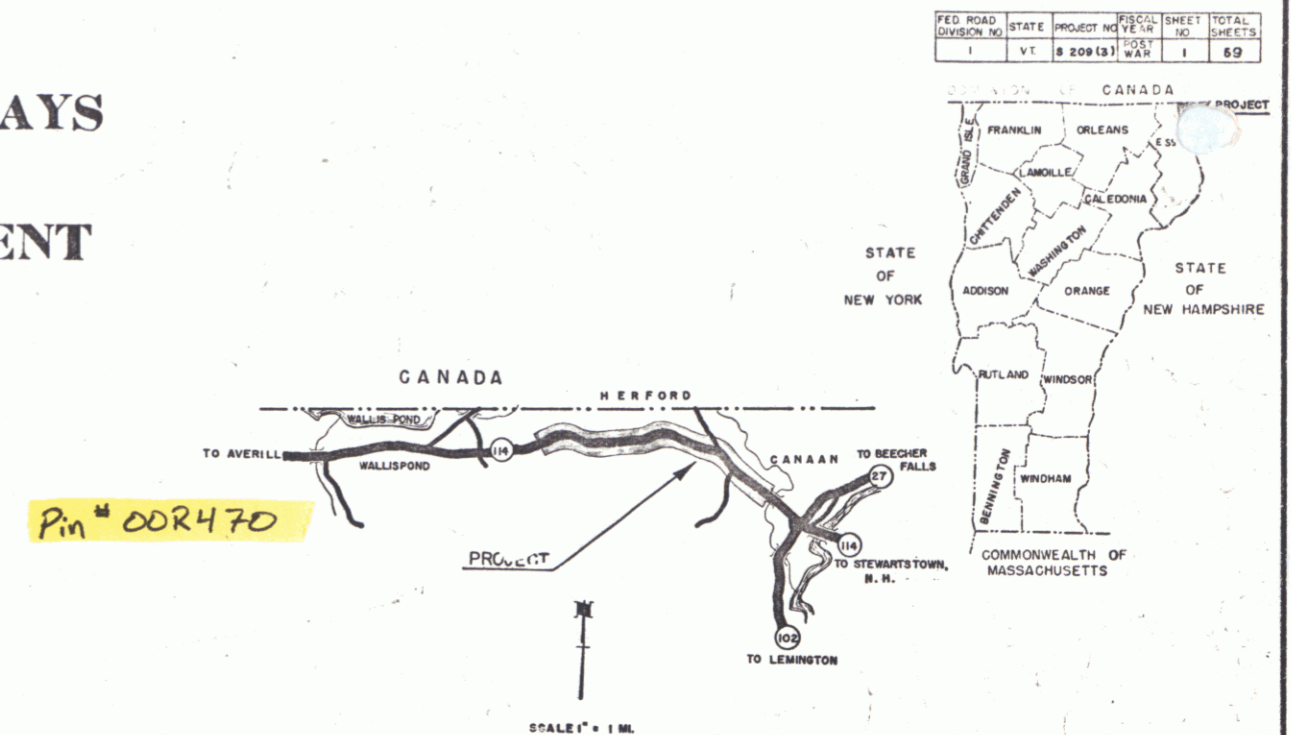

BEGINNING AT THE WESTERLY END OF THE BRIDGE OVER LEACH CREEK AND EXTENDING WESTERLY 13,549.8 FEET

LENGTH OF PROJECT 13,549.8 FT. = 2.566 MILES

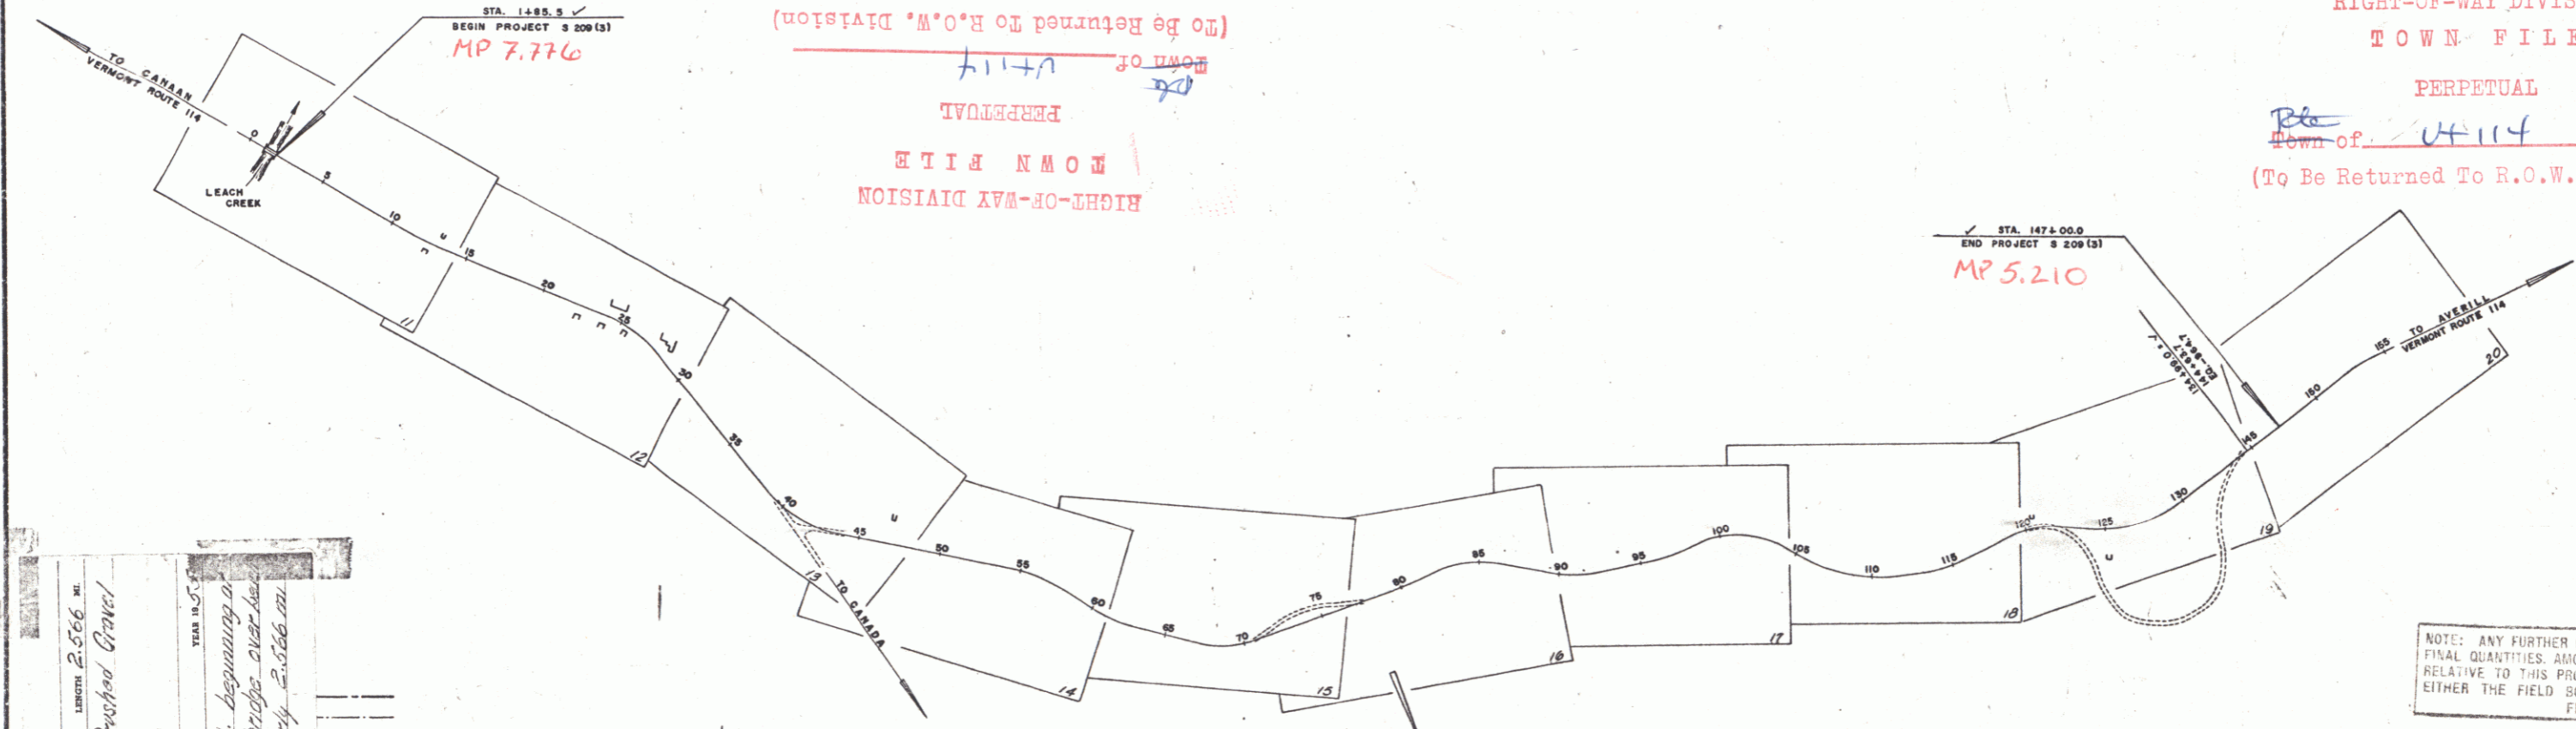

RIGHT-OF-WAY DIVISION
TOWN FILE
PERPETUAL
Town of Canaan
(To Be Returned To R.O.W. Division)

PROJECT: Canaan
NUMBER: S 209 (3)
TYPE: Hot Mix Macadam with Crushed Gravel / Asphalt Cement
CONTRACTOR: H. J. O'Connell, Ltd.
LOCATION: Canaan - Averill Road, beginning at the westerly end of the bridge over Leach Creek and extending westerly 2.566 miles

GROUND ELEVATION	DATUM	LINE
GRADE ELEVATION	DATUM	LINE
CURVE DATA		
DEFLECTION ANGLE	Δ	
DEGREE OF CURVE	D	
RADIUS OF CURVE	R	
TANGENT DISTANCE	T	
LENGTH OF CURVE	L	
EXTERNAL DISTANCE	E	
POINT OF INTERSECTION	P.I.	
POINT OF CURVE	P.C.	
POINT OF TANGENT	P.T.	
POINT ON TANGENT	P.O.T.	
POINT ON SUB-TANGENT	P.O.S.T.	

CONTRACTOR: H. J. O'CONNELL, LTD.
RECORD PLANS: KAMBOUR-WOODWARD
CONSTR. COMPLETED: OCT. 6, 1955

SCALES

TITLE	1" = 500'
TYPICAL	1" = 2'
PLAN	1" = 50'
PROFILE HORIZONTAL	1" = 50'
PROFILE VERTICAL	1" = 10'
CROSS SECTIONS	1" = 5'

THESE PLANS ARE SUBJECT TO SUCH REVISIONS AS MAY BE REQUIRED BY THE BUREAU OF PUBLIC ROADS OR THE COMMISSIONER OF HIGHWAYS.

CONSTRUCTION IS TO BE CARRIED ON IN ACCORDANCE WITH THE PLANS AND THE STANDARD ROAD AND BRIDGE SPECIFICATIONS OF 1948, AS APPROVED JULY 25, 1949 BY THE BUREAU OF PUBLIC ROADS, INCLUDING ALL SUBSEQUENT APPROVED REVISIONS AND SUCH REVISED SPECIFICATIONS AND SPECIAL PROVISIONS AS ARE SUBMITTED WITH THE PLANS.

NOTE: ANY FURTHER INFORMATION CONCERNING FINAL QUANTITIES, AMOUNTS OR OTHER DETAILS RELATIVE TO THIS PROJECT MAY BE FOUND IN EITHER THE FIELD BOOKS OR THE ESTIMATE FILE.

APPROVED: *[Signature]* CONSTRUCTION ENGINEER DATE: 12-19-53
 APPROVED: *[Signature]* SECONDARY ENGINEER DATE: 12-19-53
 APPROVED: Jan 8 1954 DISTRICT ENGINEER DATE: 1-8-54
 APPROVED: *[Signature]* HIGHWAY ENGINEER DATE: DEC 18, 1953
 APPROVED: *[Signature]* CHIEF ENGINEER DATE: DEC 18, 1953
 SUBMITTED BY: *[Signature]* CHIEF OF THE STATE HIGHWAY BOARD

DEPARTMENT OF COMMERCE
BUREAU OF PUBLIC ROADS

DISTRICT ENGINEER: _____ DATE: _____



APPROVED: _____ DATE: _____

PROJECT S NO. 209 (3)

SHEET 1 OF 59 SHEETS

PLAN
 DATE 9/18
 DRAWN BY E. Wilkie
 CHECKED BY
 NO. 5-51



PROFILE
 DATE 9/18
 DRAWN BY E. Wilkie
 CHECKED BY
 NO. 5-51

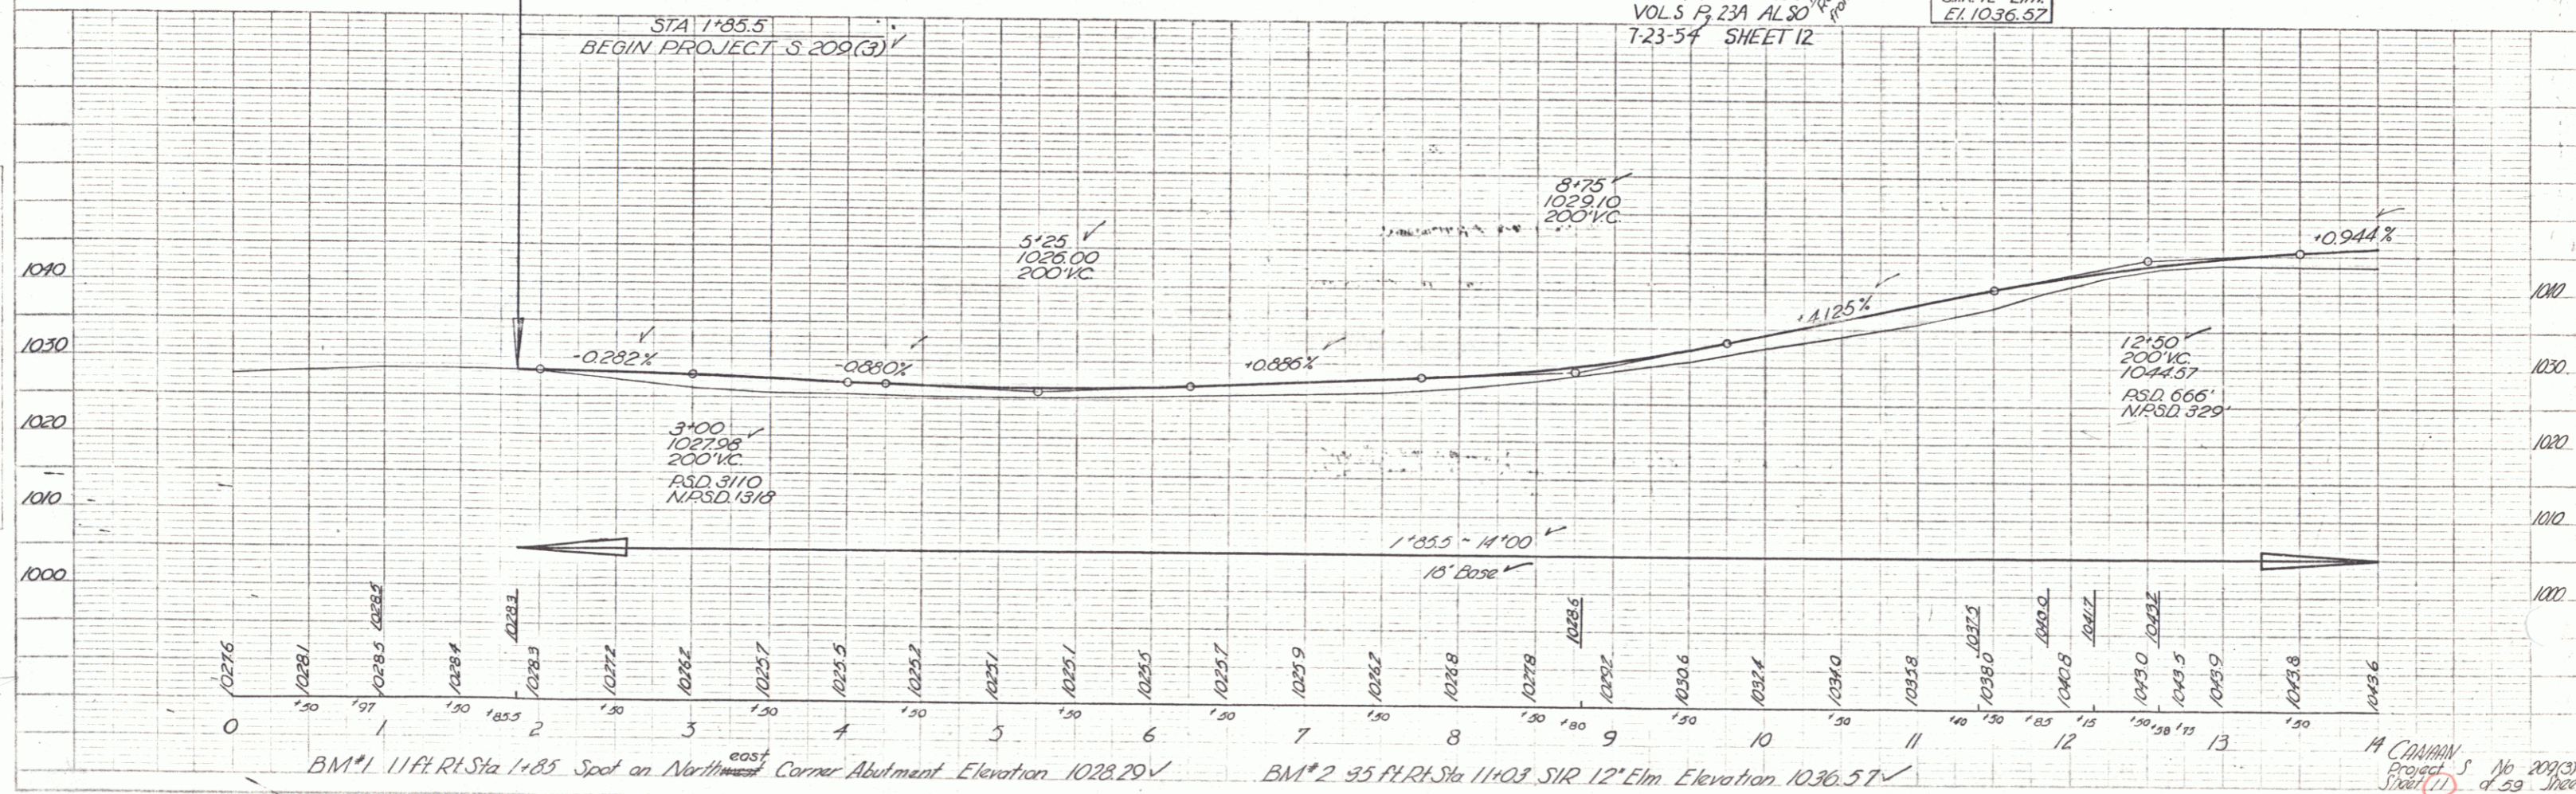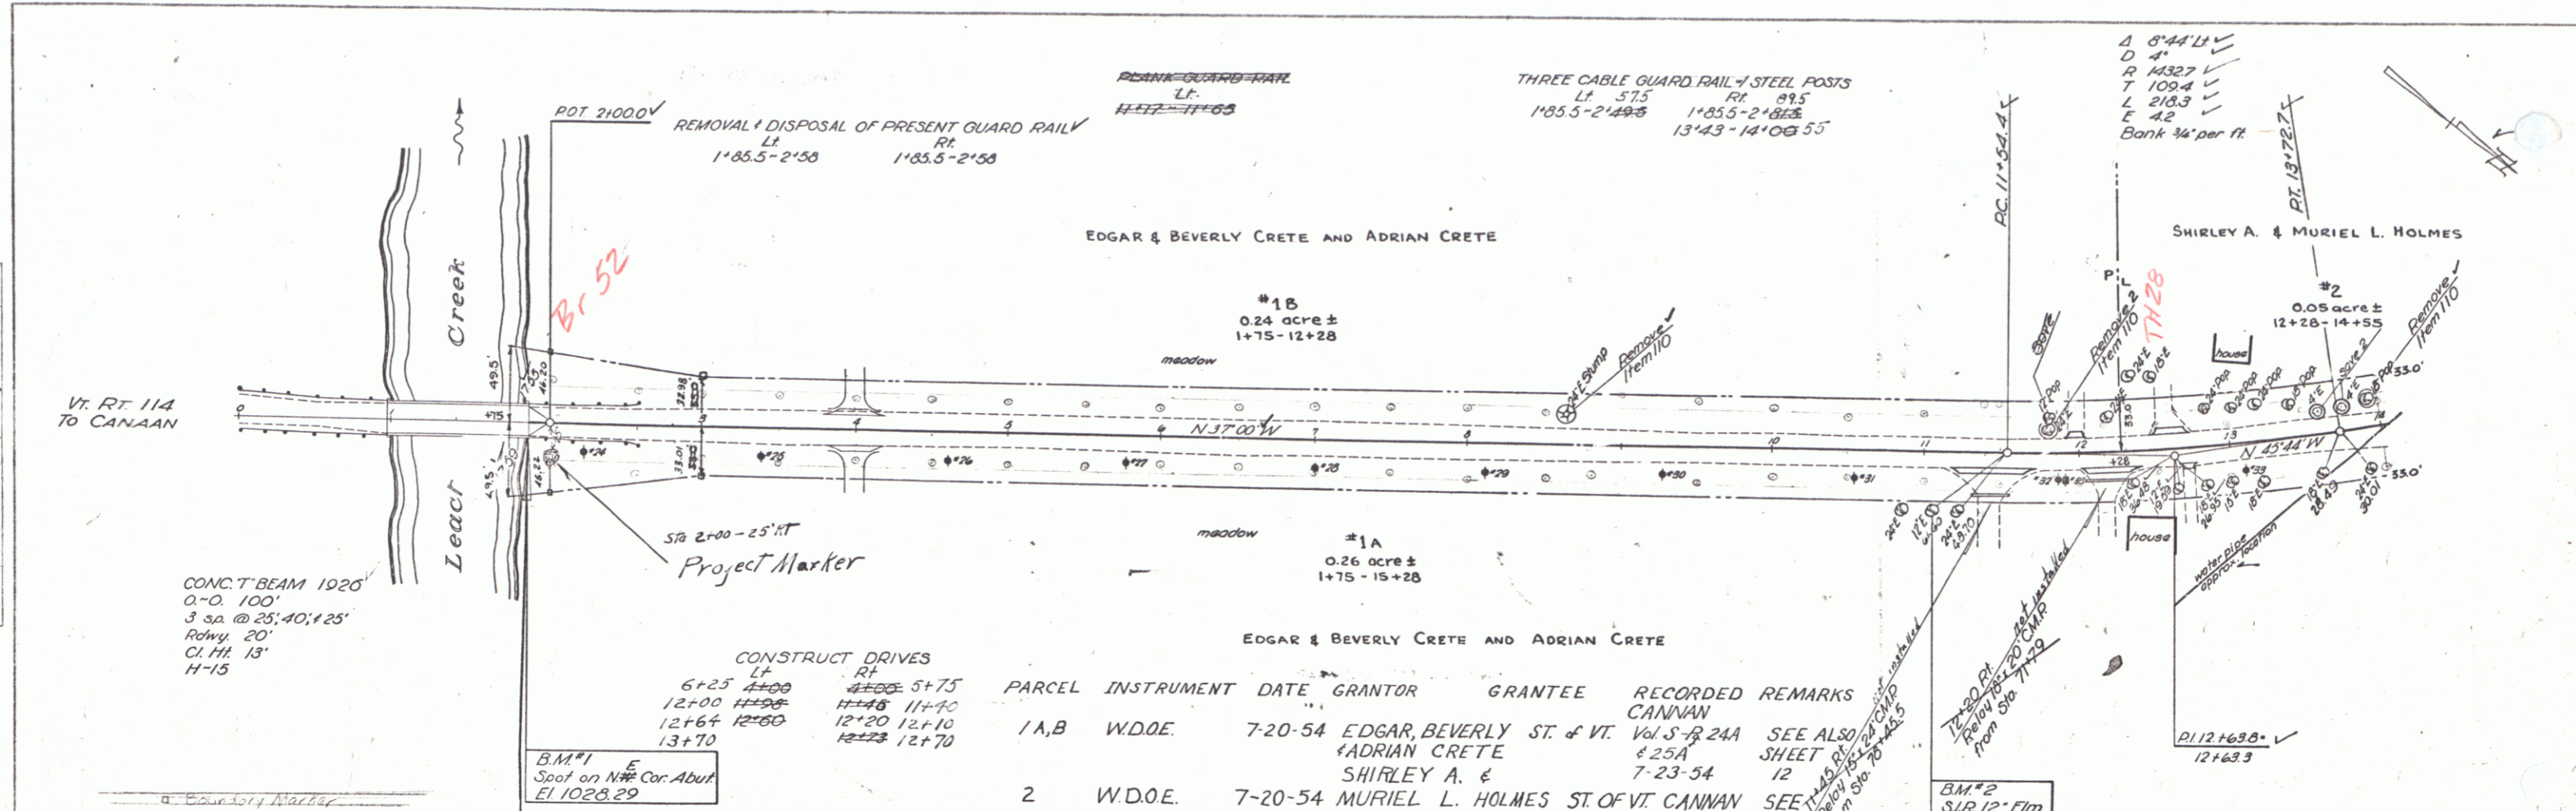

H. CANNAN
 Project No. 209(3)
 Sheet 11 of 59 Sheets

PLAN
 DATE WORKED: 3/28
 DRAWN BY: Hurley
 CHECKED BY: [Signature]

PROFILE
 DATE WORKED: 3/28
 DRAWN BY: E. White
 CHECKED BY: [Signature]

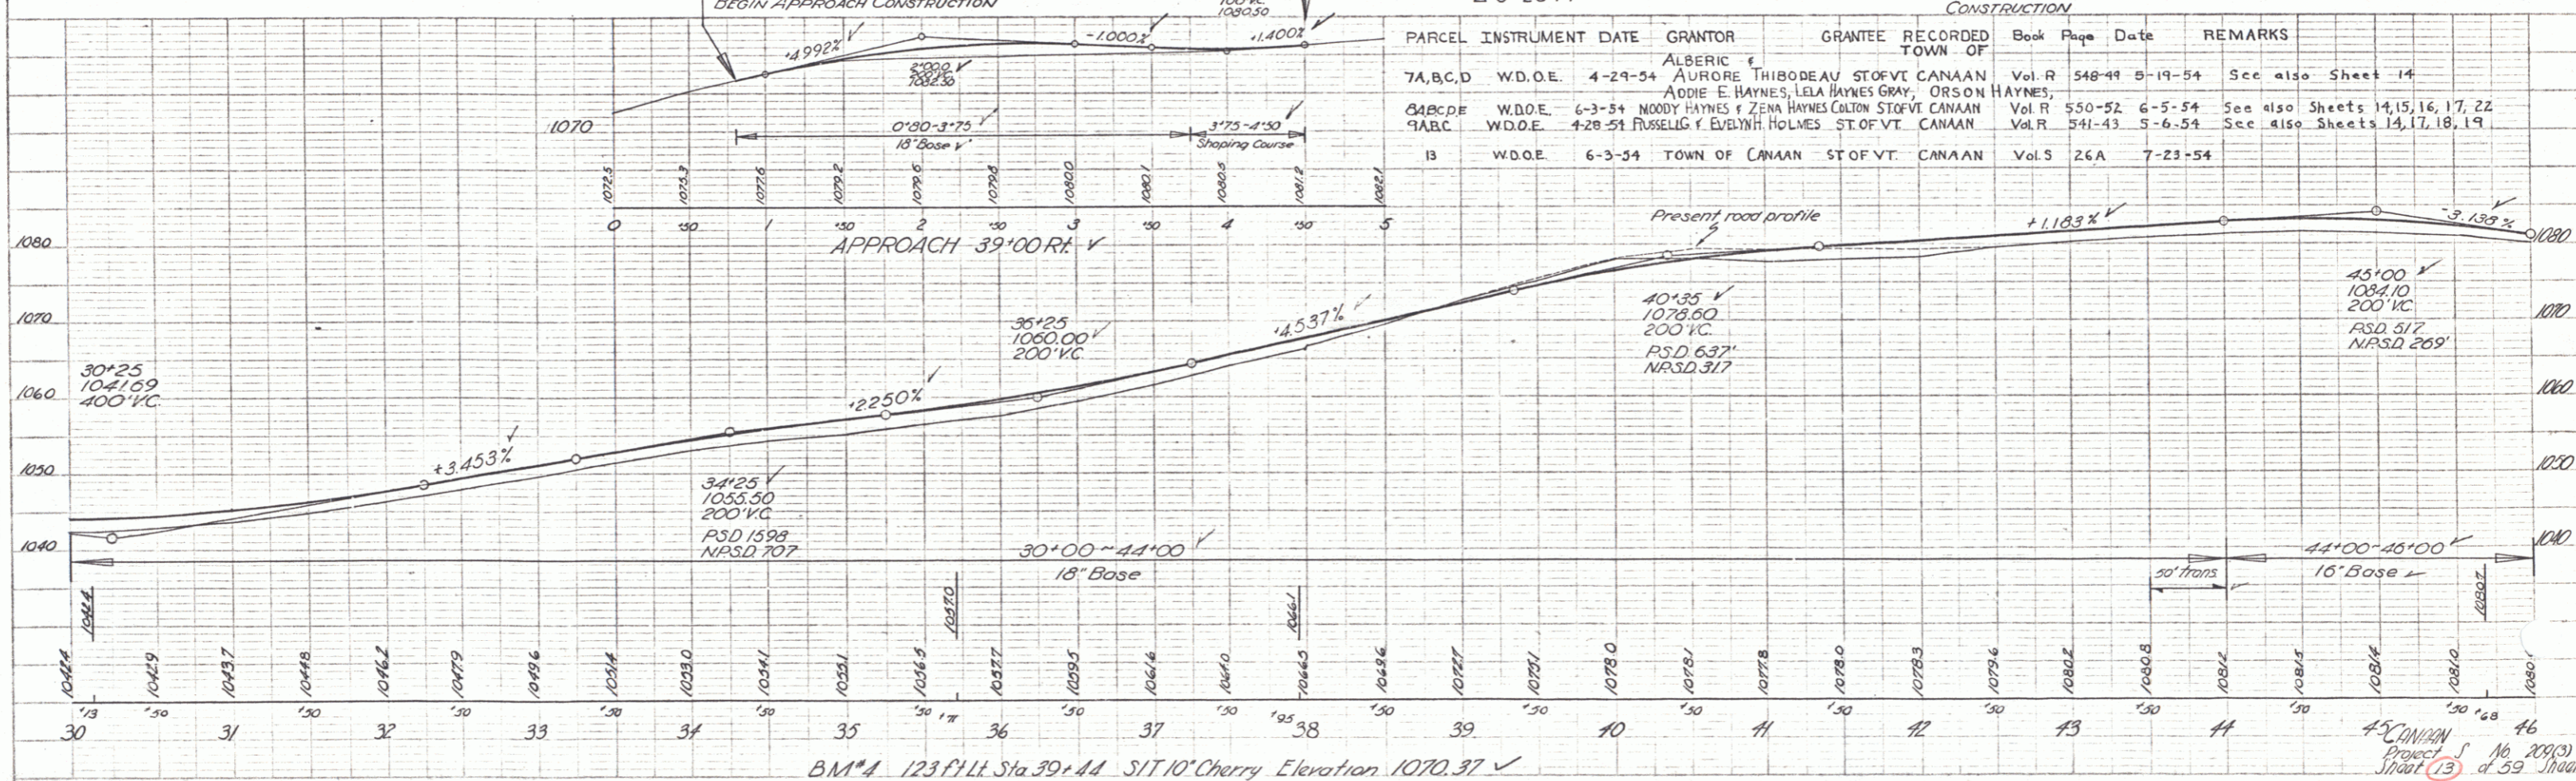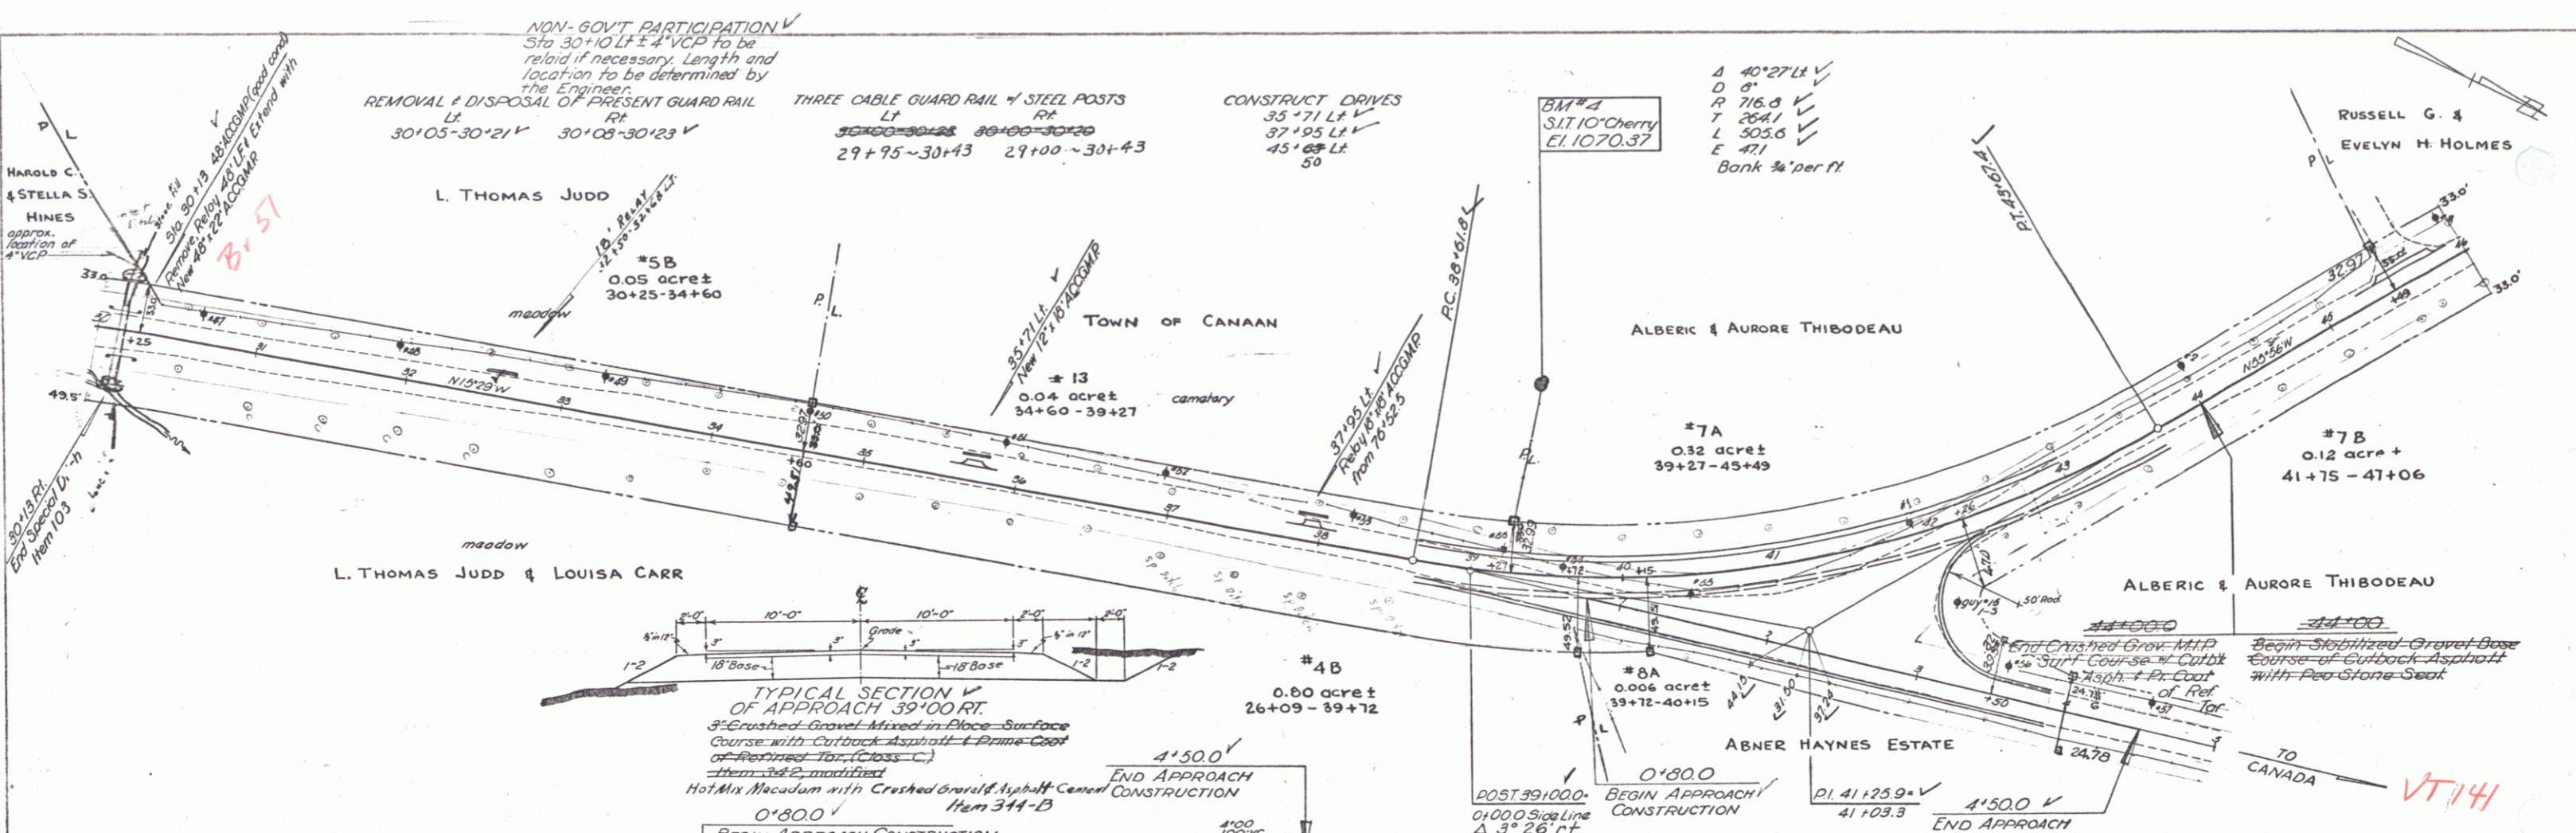


DATE: PLAN PROFILE: C.P. & L.C. 1988
 SCALE: 1" = 40' HORIZ. 1" = 10' VERT.
 11880 VIA 248-92

NON-GOVT PARTICIPATION
Sta 49+00- Install sleeve
for water pipe, item 431 across
roadway. Sleeve to be furnished
by the State.


PLAN
DATE: 5/28/88
BY: Hurby
PROJECT NO.: 59
SHEET NO.: 14

PROFILE
DATE: 5/28/88
BY: E. White
PROJECT NO.: 59
SHEET NO.: 14

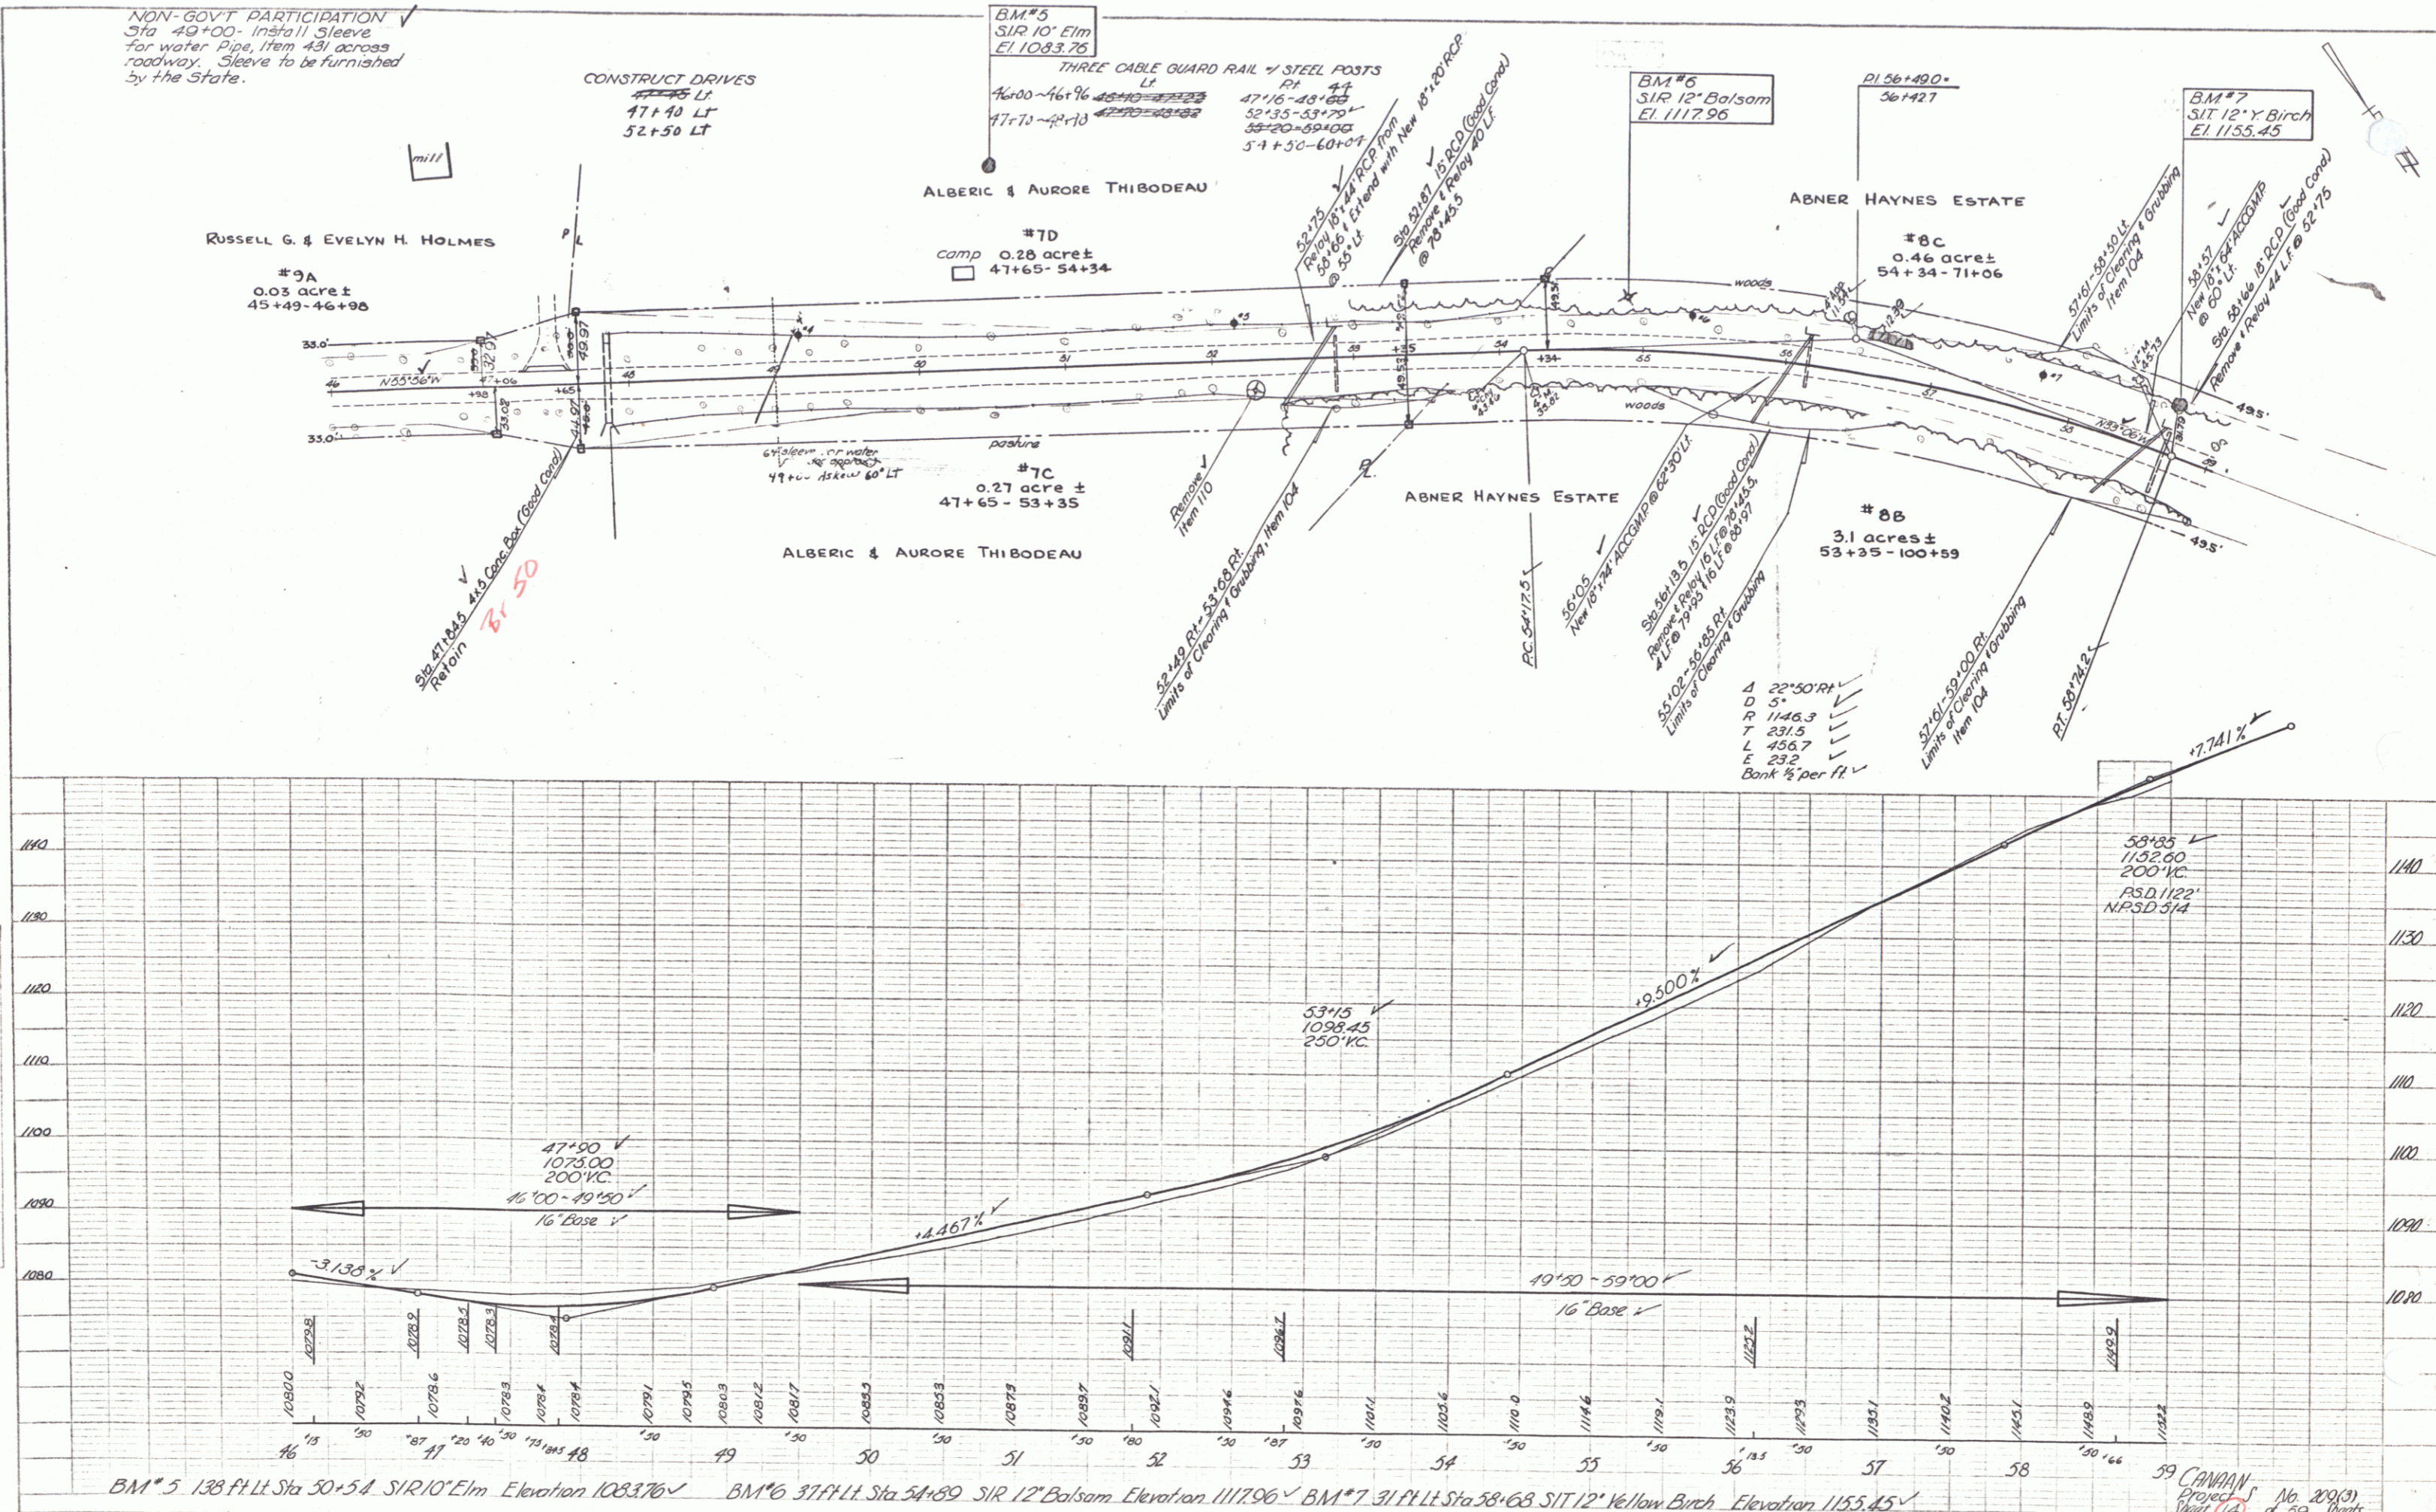


BM#5 1.28 FT Lt Sta 50+5.4 SIR 10' Elm Elevation 1083.76
 BM#6 3.11 FT Lt Sta 54+8.9 SIR 12' Balsam Elevation 1117.96
 BM#7 3.1 FT Lt Sta 58+6.8 SIT 12' Yellow Birch Elevation 1155.45
 59 CROWN Project 14 d. 59. Sheds

PLAN
DATE BOOK
3/8/88
3/8
E. White
5/97

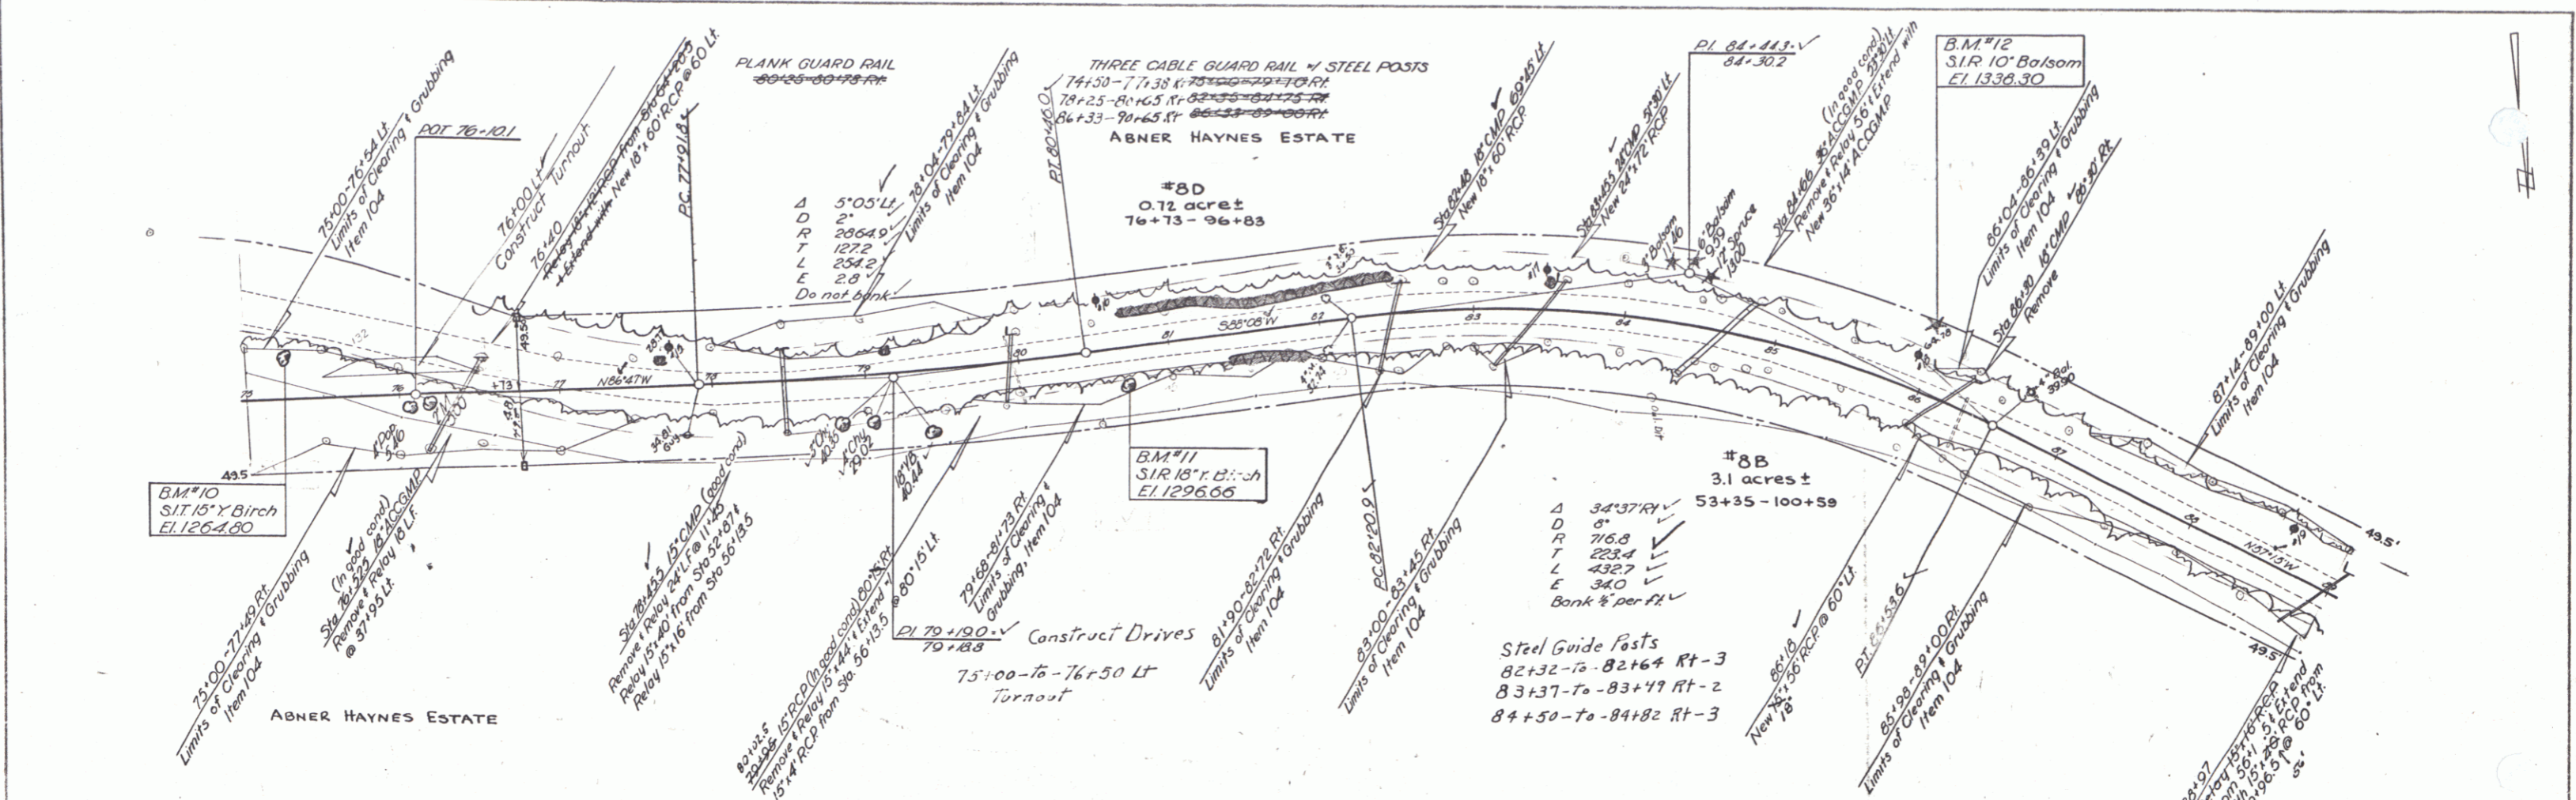


PROFILE
DATE BOOK
3/8/88
3/8
E. White
5/97

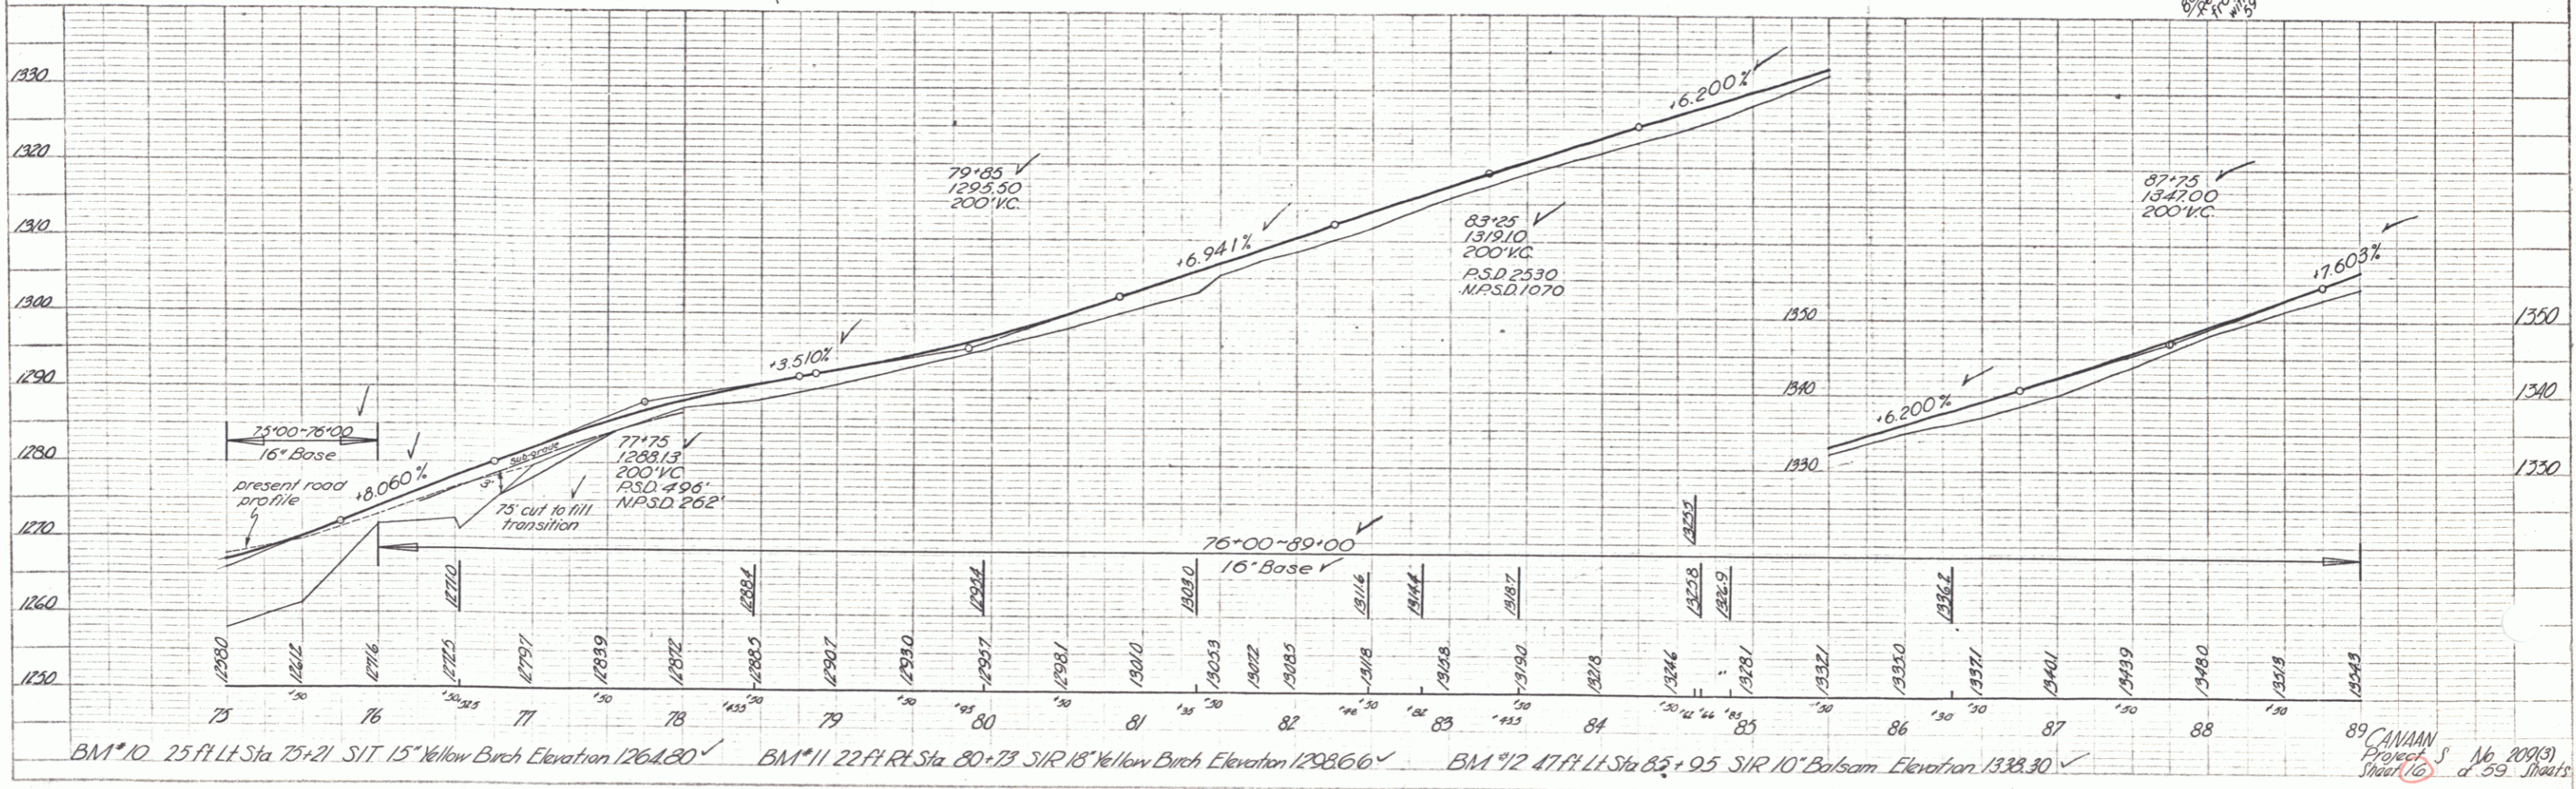


89 CAMMAN
Project 5 No. 200(3)
Sheet 16 of 59 Sheets

7 Canada

PLAN
 DATE: 10/11/67
 DRAWN BY: A. L. Palmer
 CHECKED BY: E. White

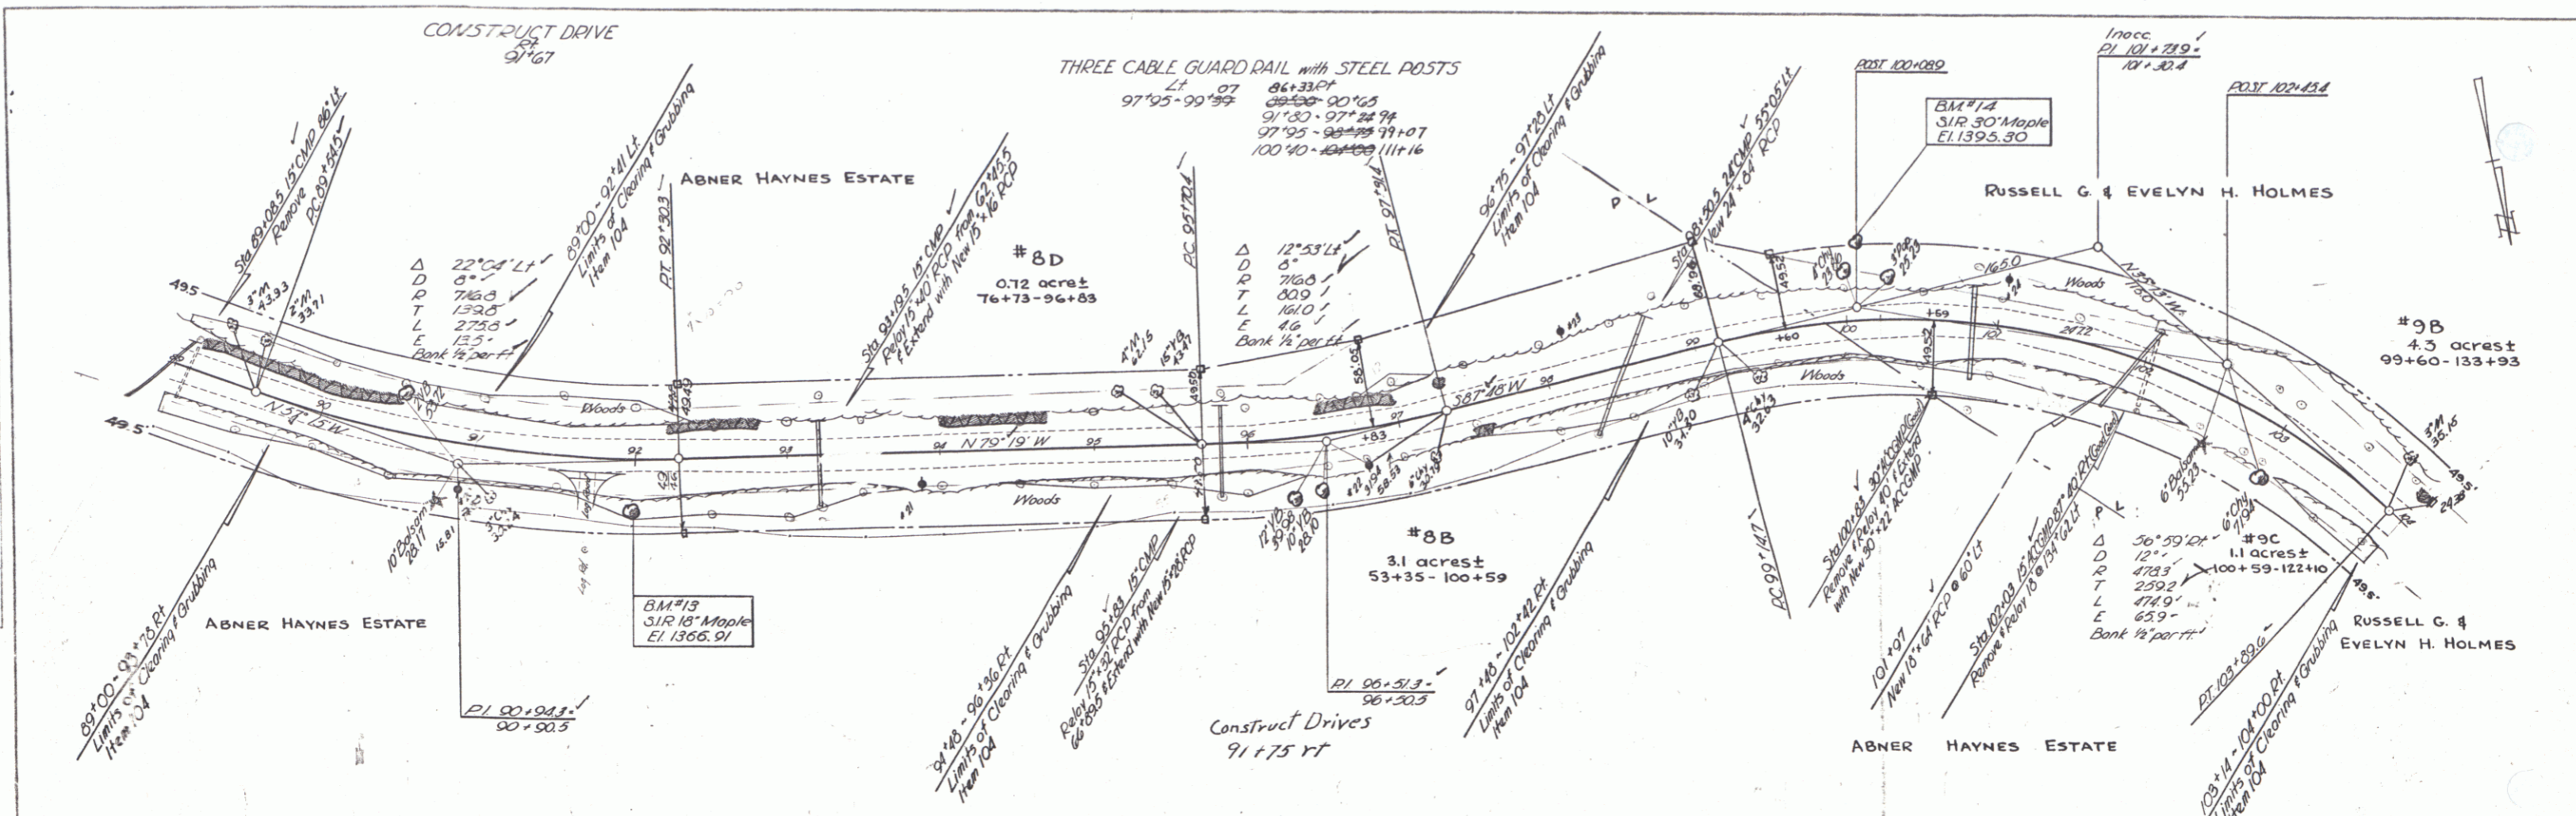


PROFILE
 DATE: 10/11/67
 DRAWN BY: A. L. Palmer
 CHECKED BY: E. White

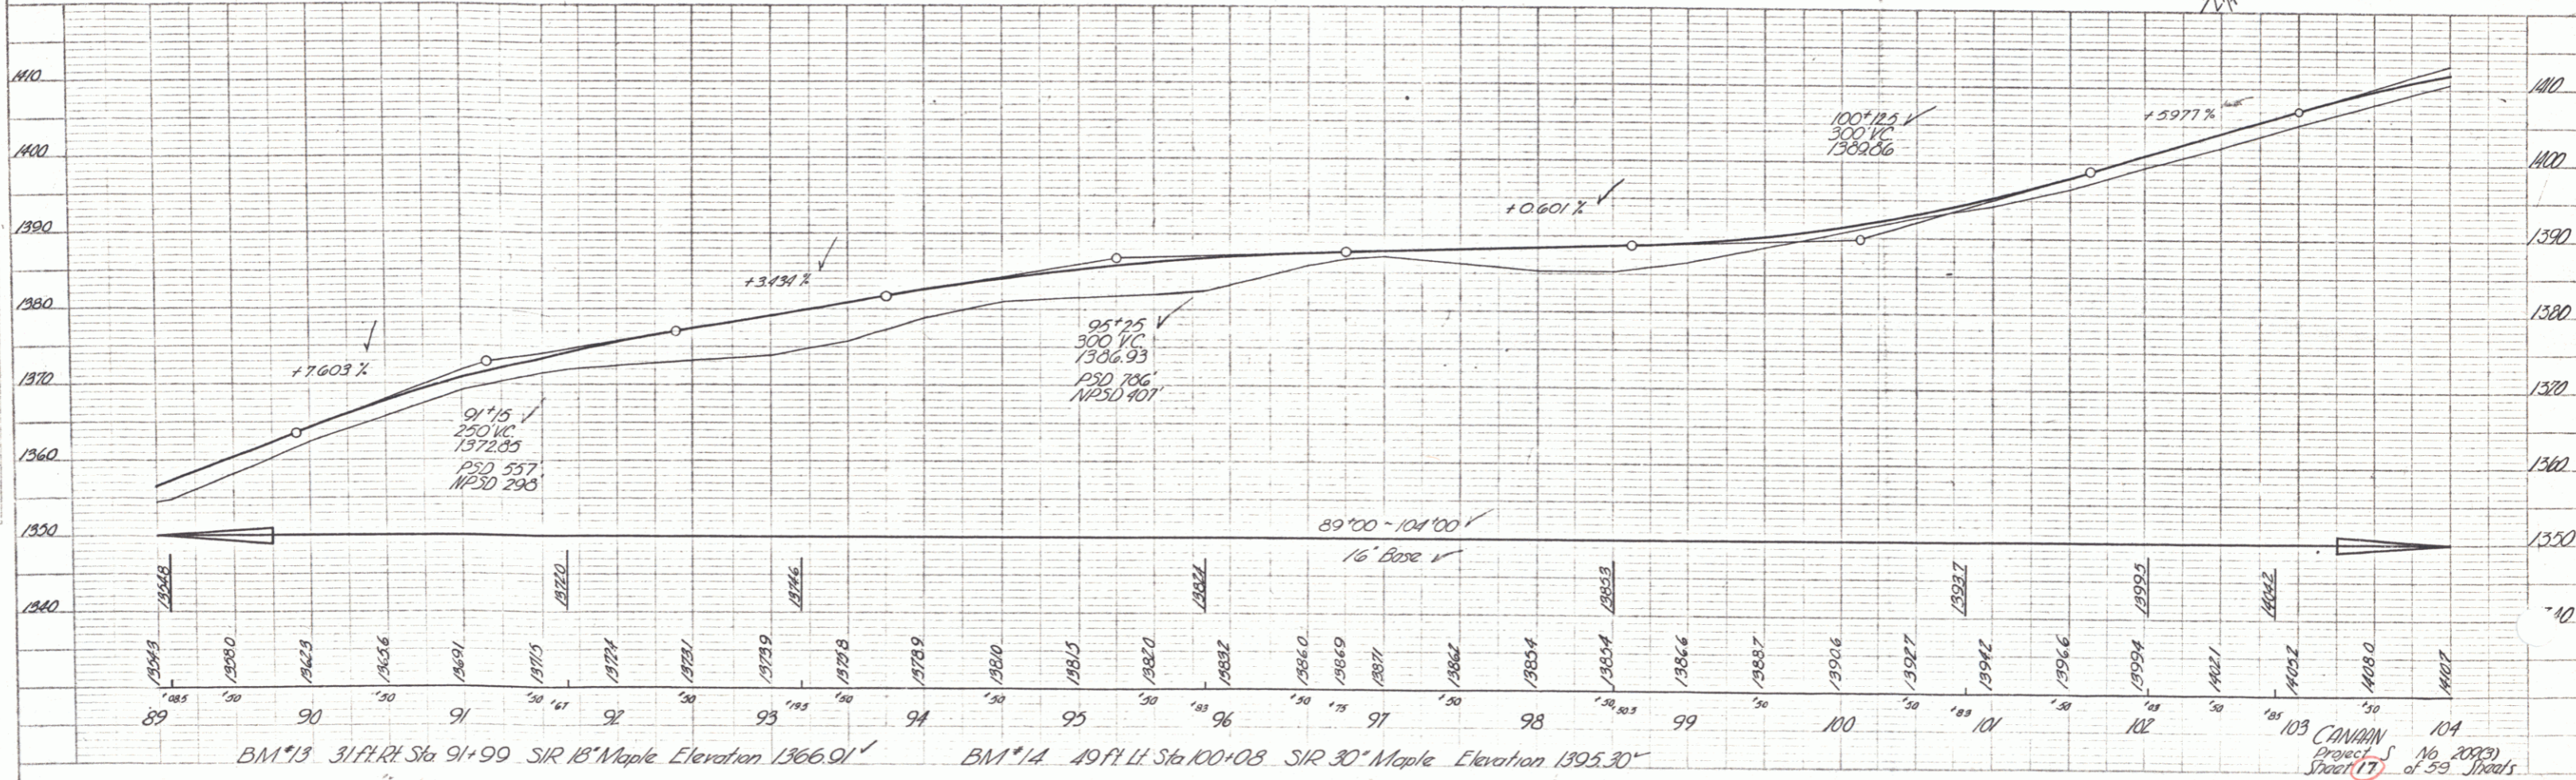




103 CANVIAN
 Project No. 20723
 Sheet 17 of 59 Sheets

PLAN
 8-28
 Traced
 E. White

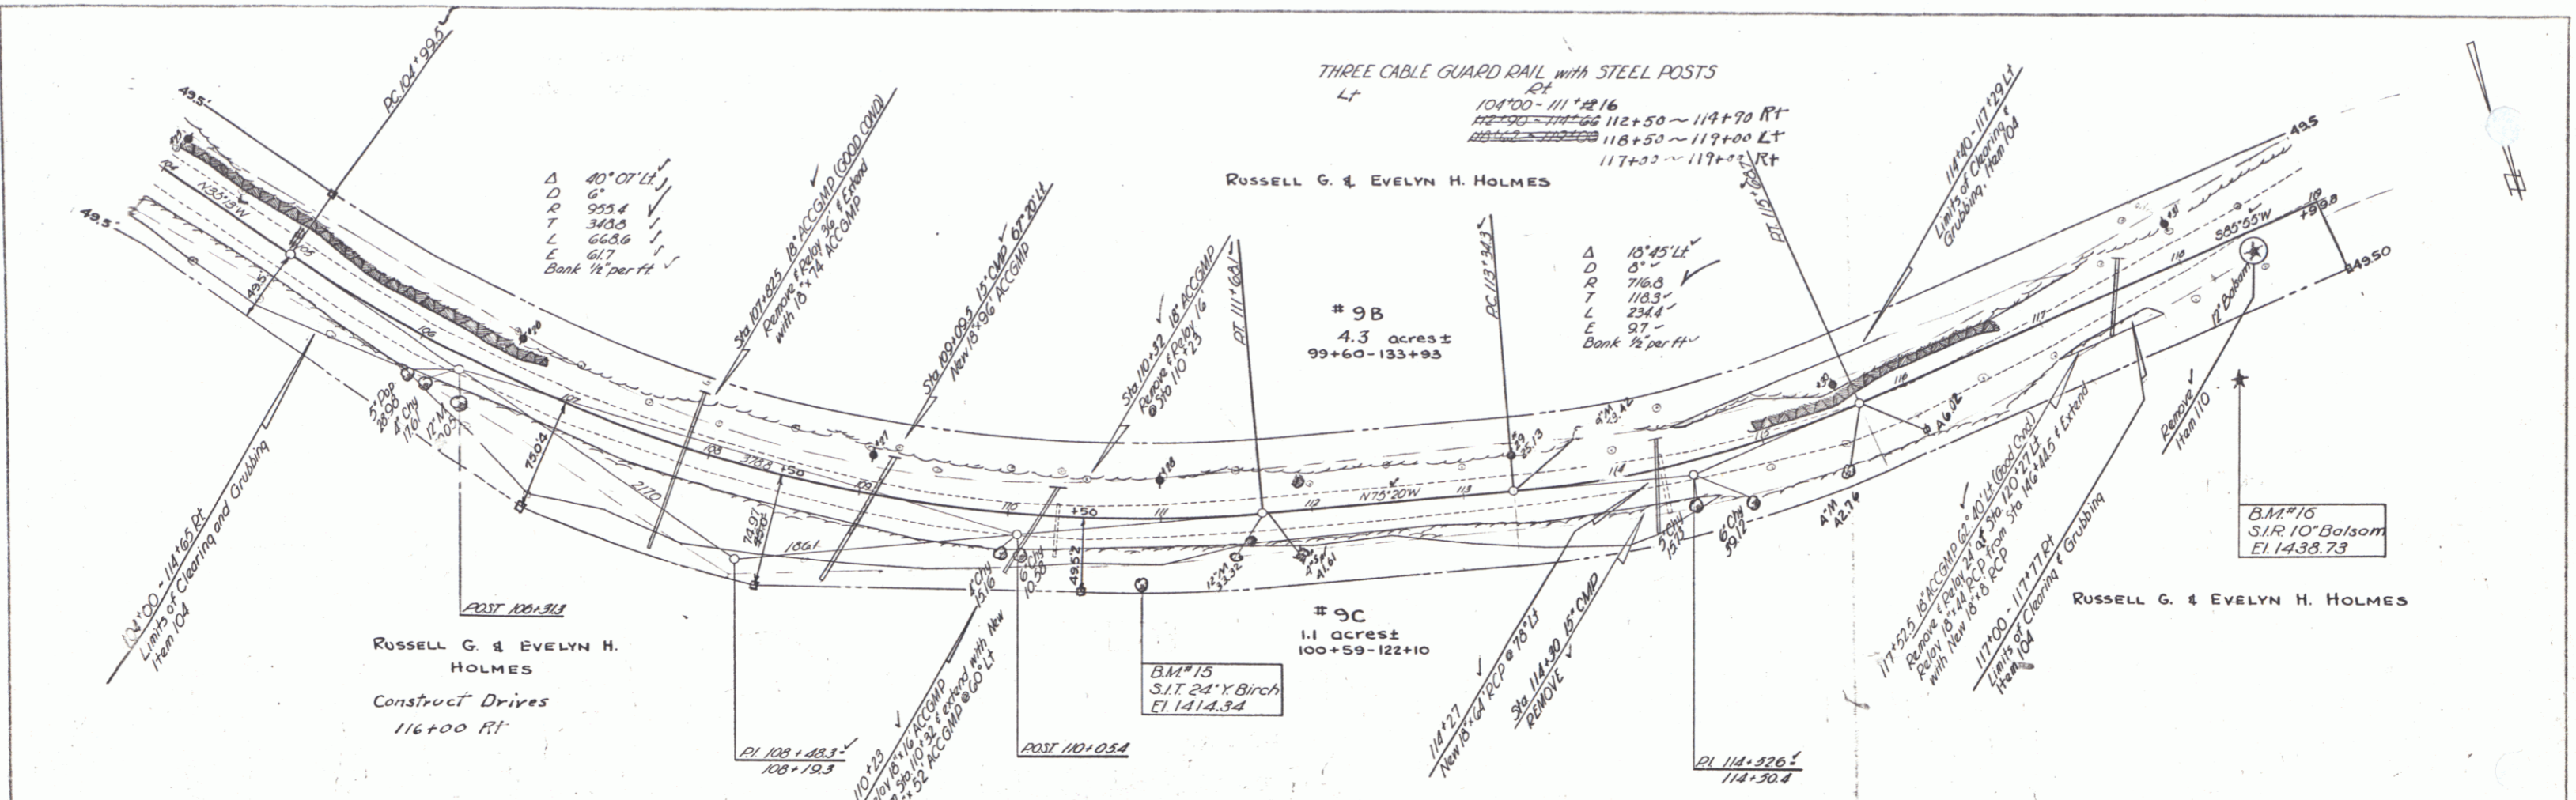

PROFILE
 8-28
 E. White

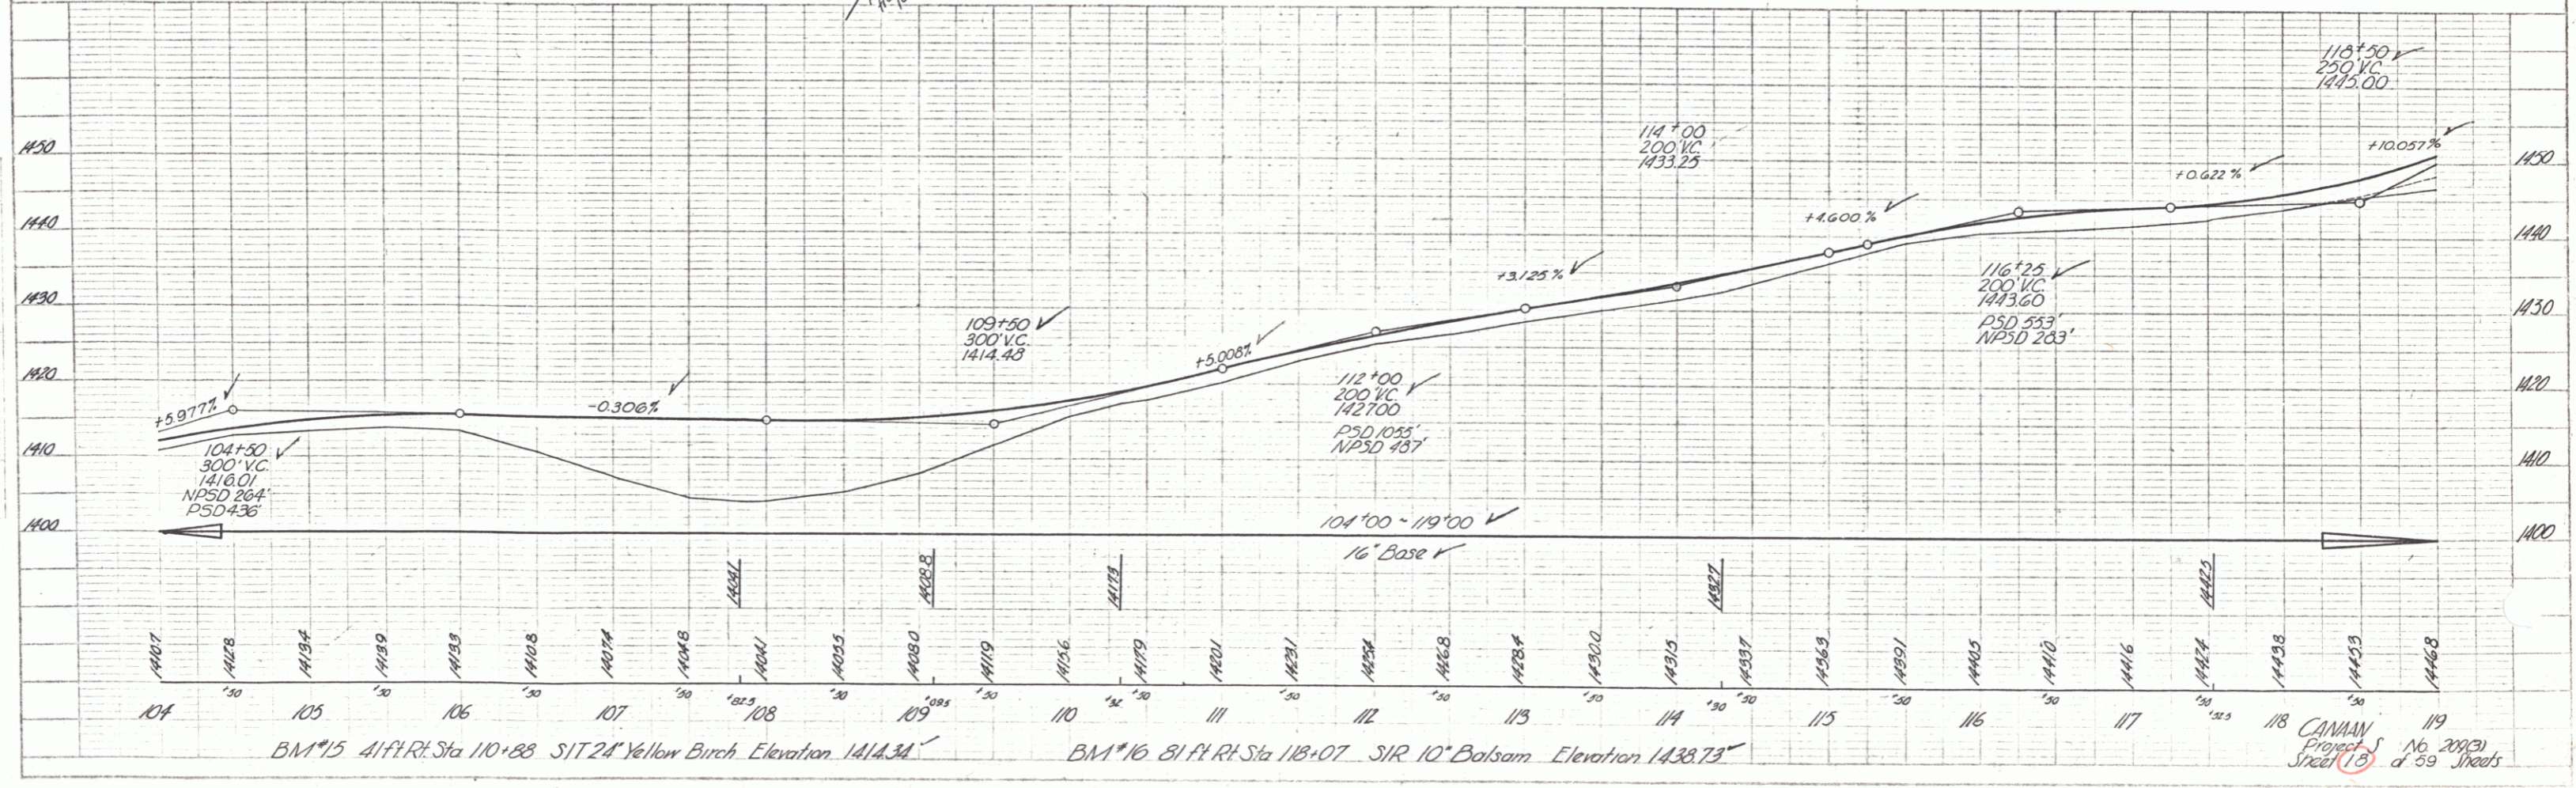

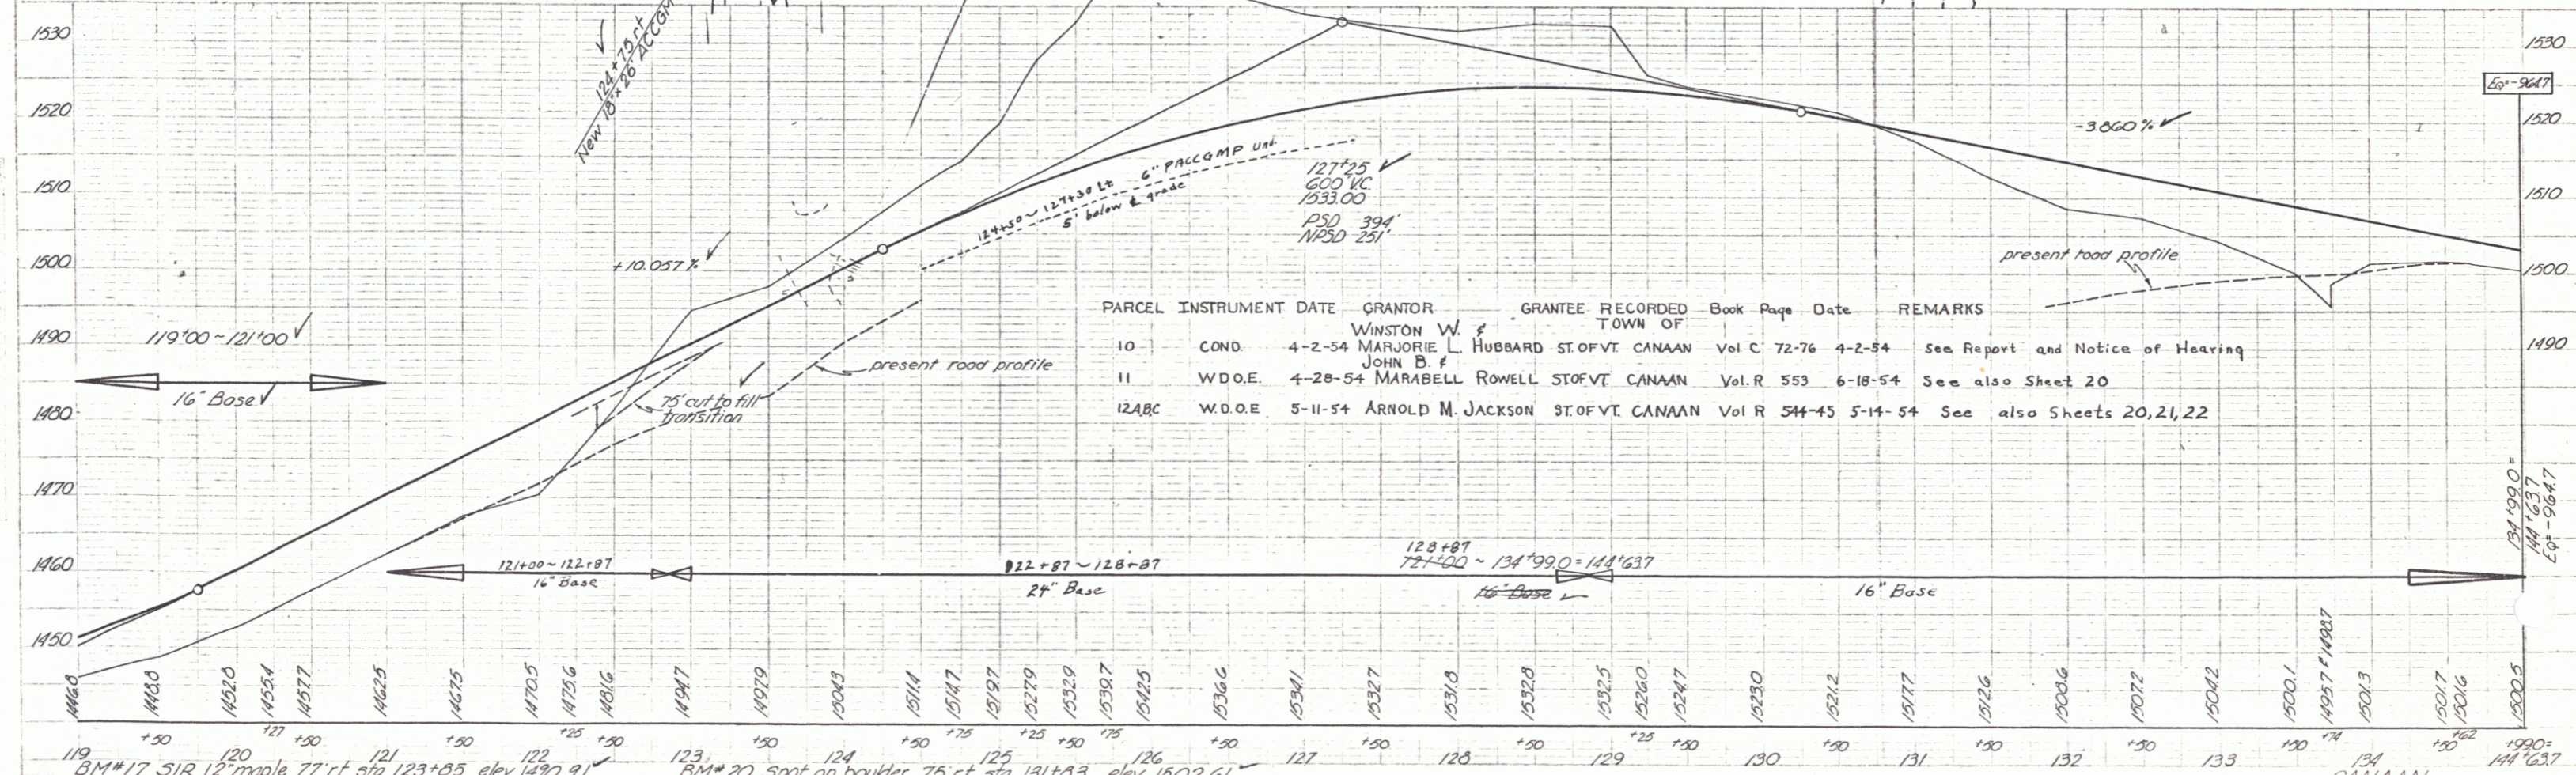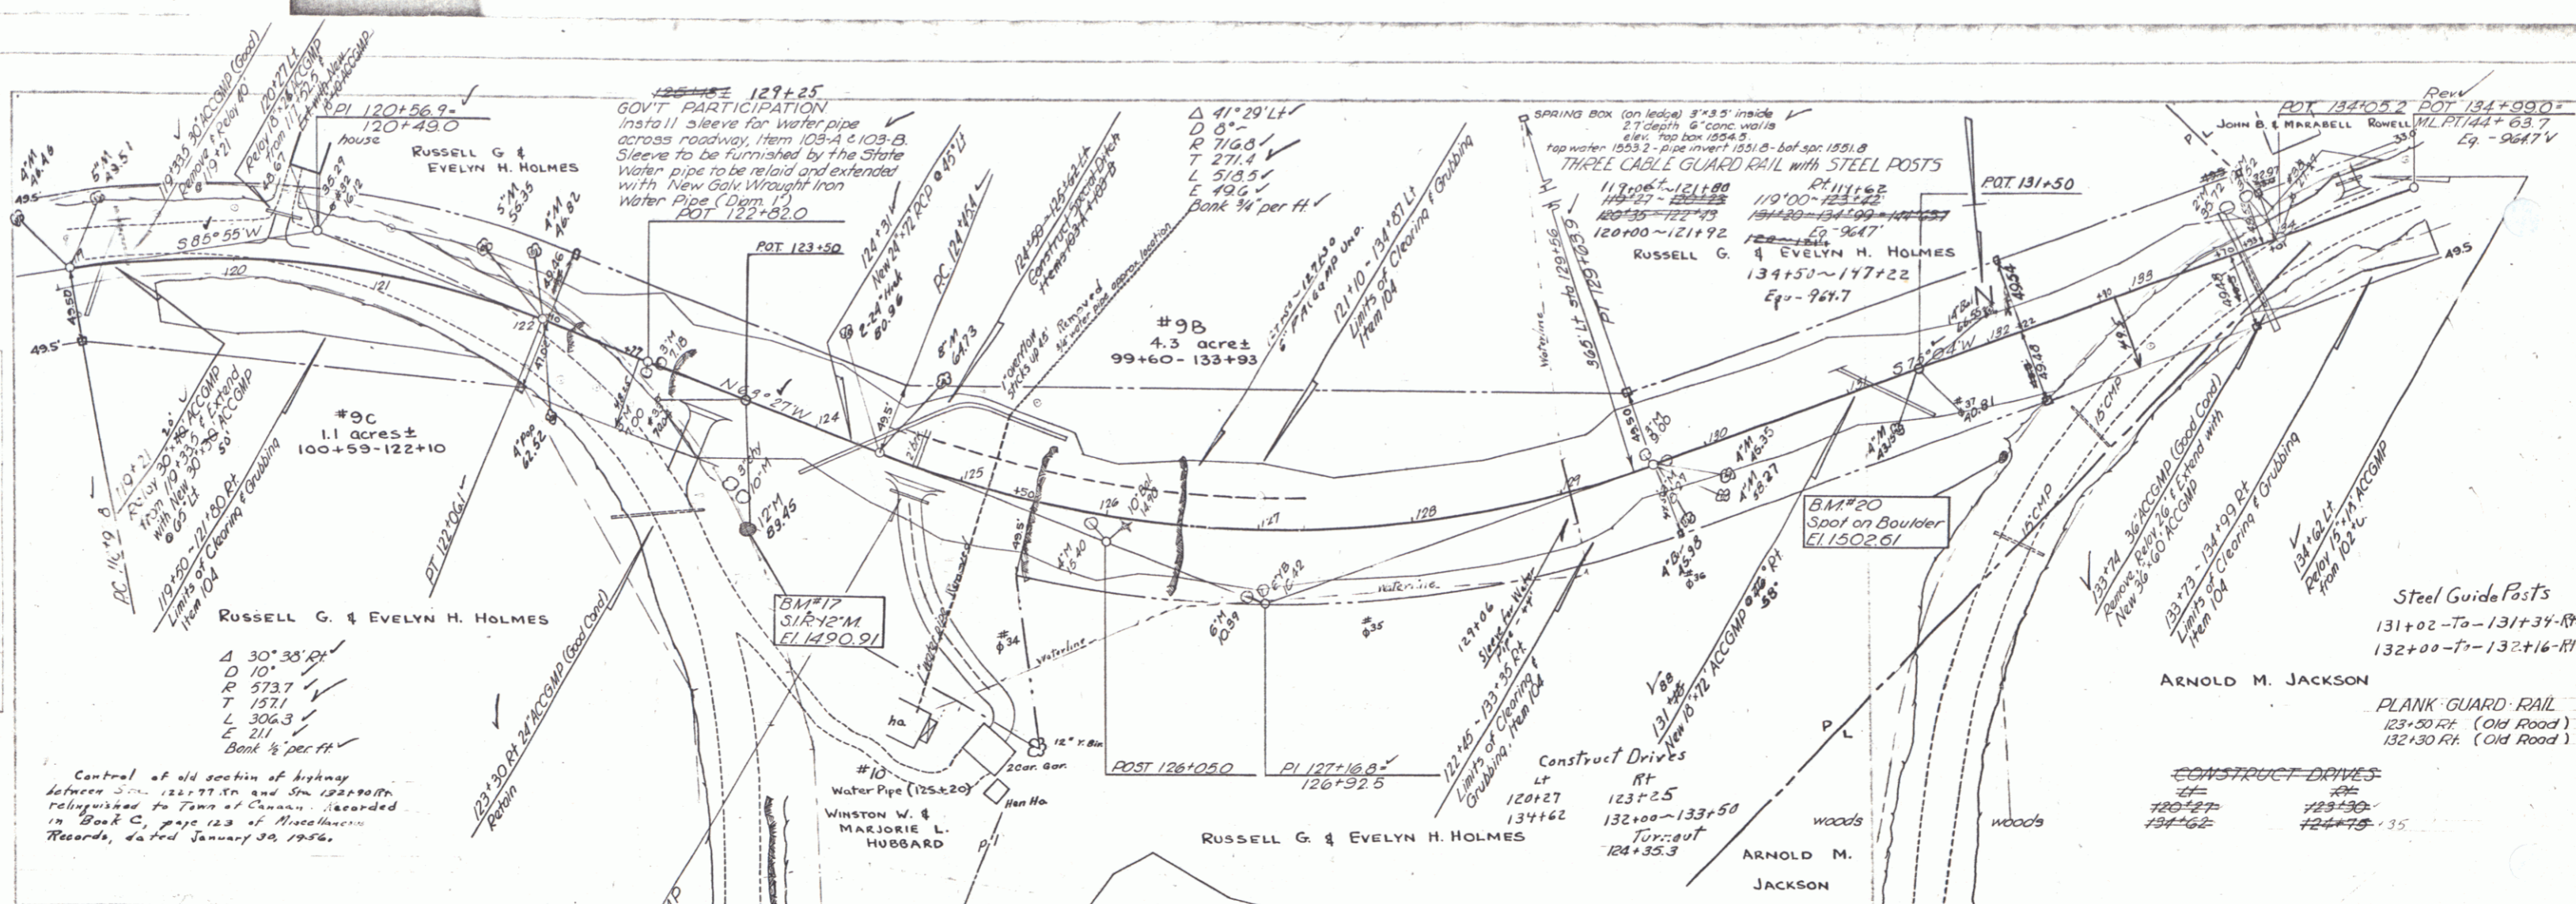

PARCEL	INSTRUMENT	DATE	GRANTOR	GRANTEE	RECORDED TOWN OF	Book	Page	Date	REMARKS
10	COND.	4-2-54	WINSTON W. & MARJORIE L. HUBBARD	ST. OF VT.	CANAAN	Vol C	72-76	4-2-54	See Report and Notice of Hearing
11	W.D.O.E.	4-28-54	MARABELL ROWELL	ST. OF VT.	CANAAN	Vol R	553	6-18-54	See also Sheet 20
12ABC	W.D.O.E.	5-11-54	ARNOLD M. JACKSON	ST. OF VT.	CANAAN	Vol R	544-45	5-14-54	See also Sheets 20, 21, 22

119+00-121+00
 121+00-122+87
 122+87-128+87
 128+87-134+99.0
 134+99.0 = 144+63.7
 144+63.7 = 144+96.7

