

FED. ROAD DIST. NO.	STATE	PROJ. NO.	FISCAL YEAR	SHEET NO.	TOTAL SHEETS
9	VI.				

PLAN
 DATE 1966
 SCALE 1" = 40'

PROFILE
 DATE 1966
 SCALE 1" = 10'

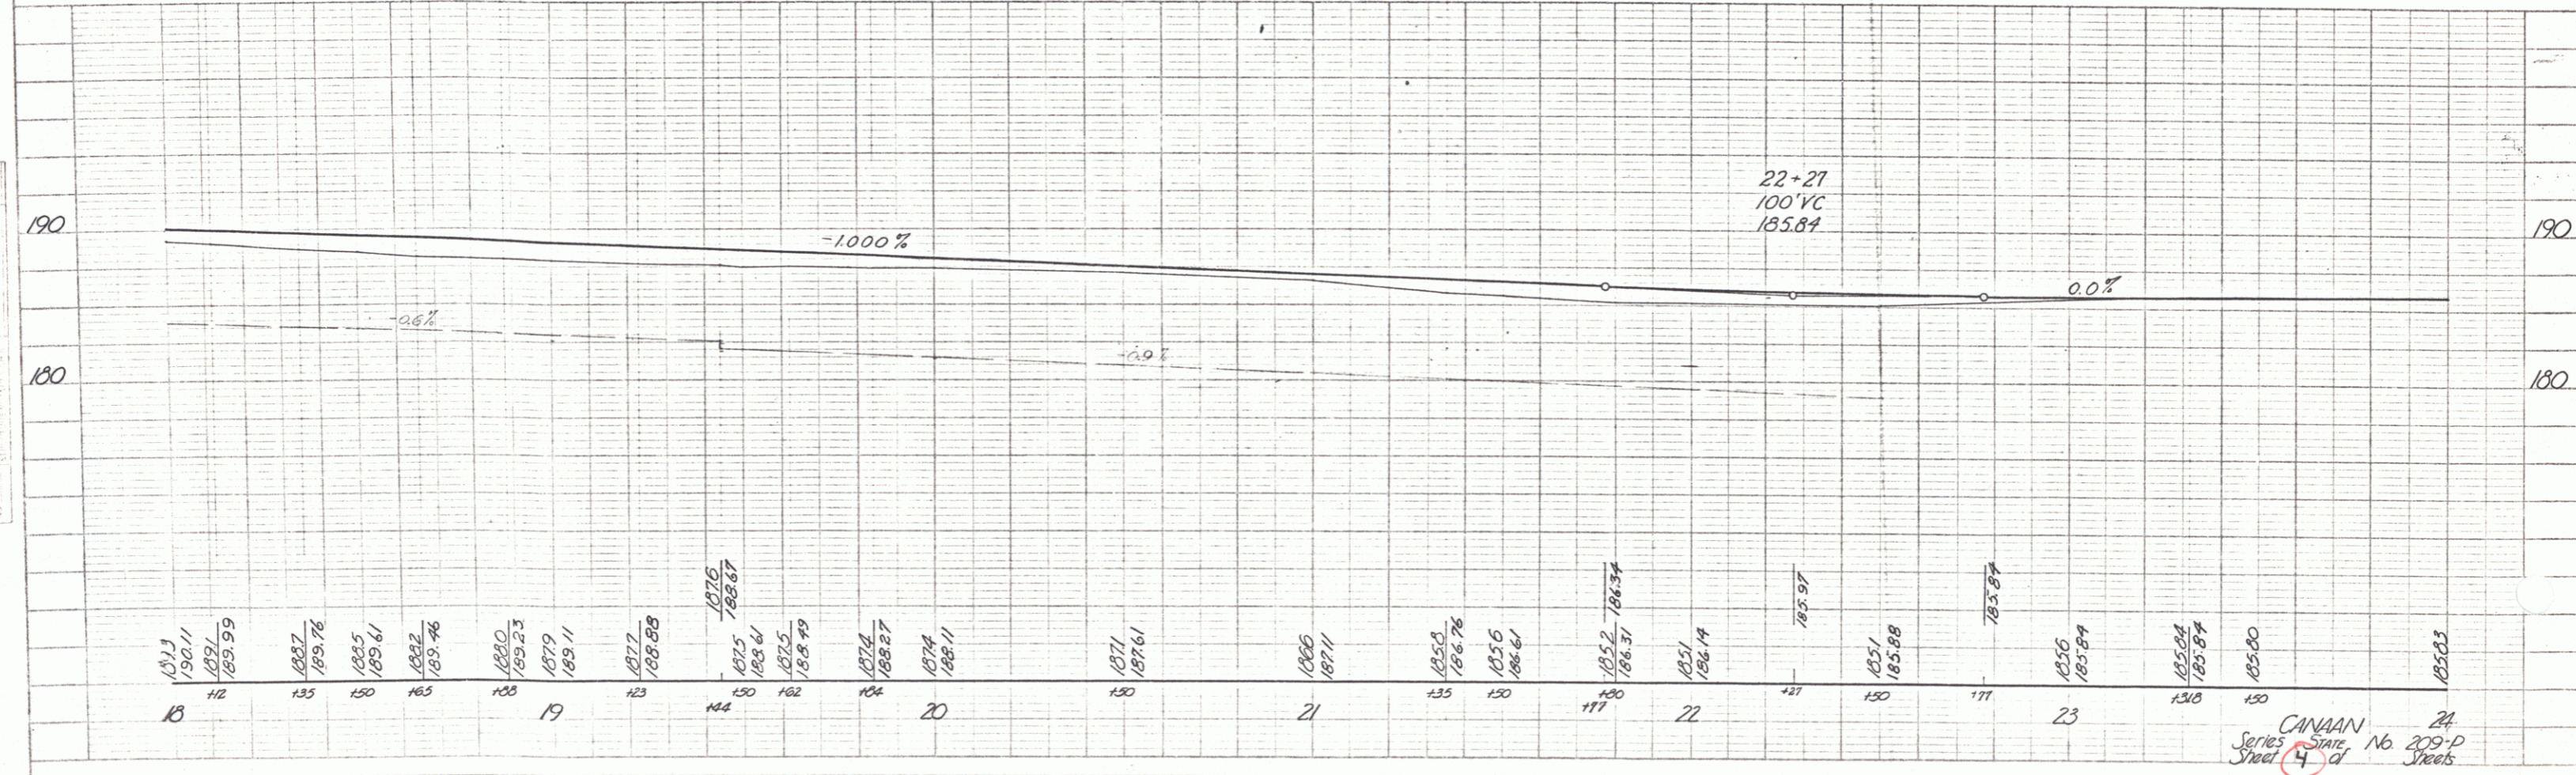
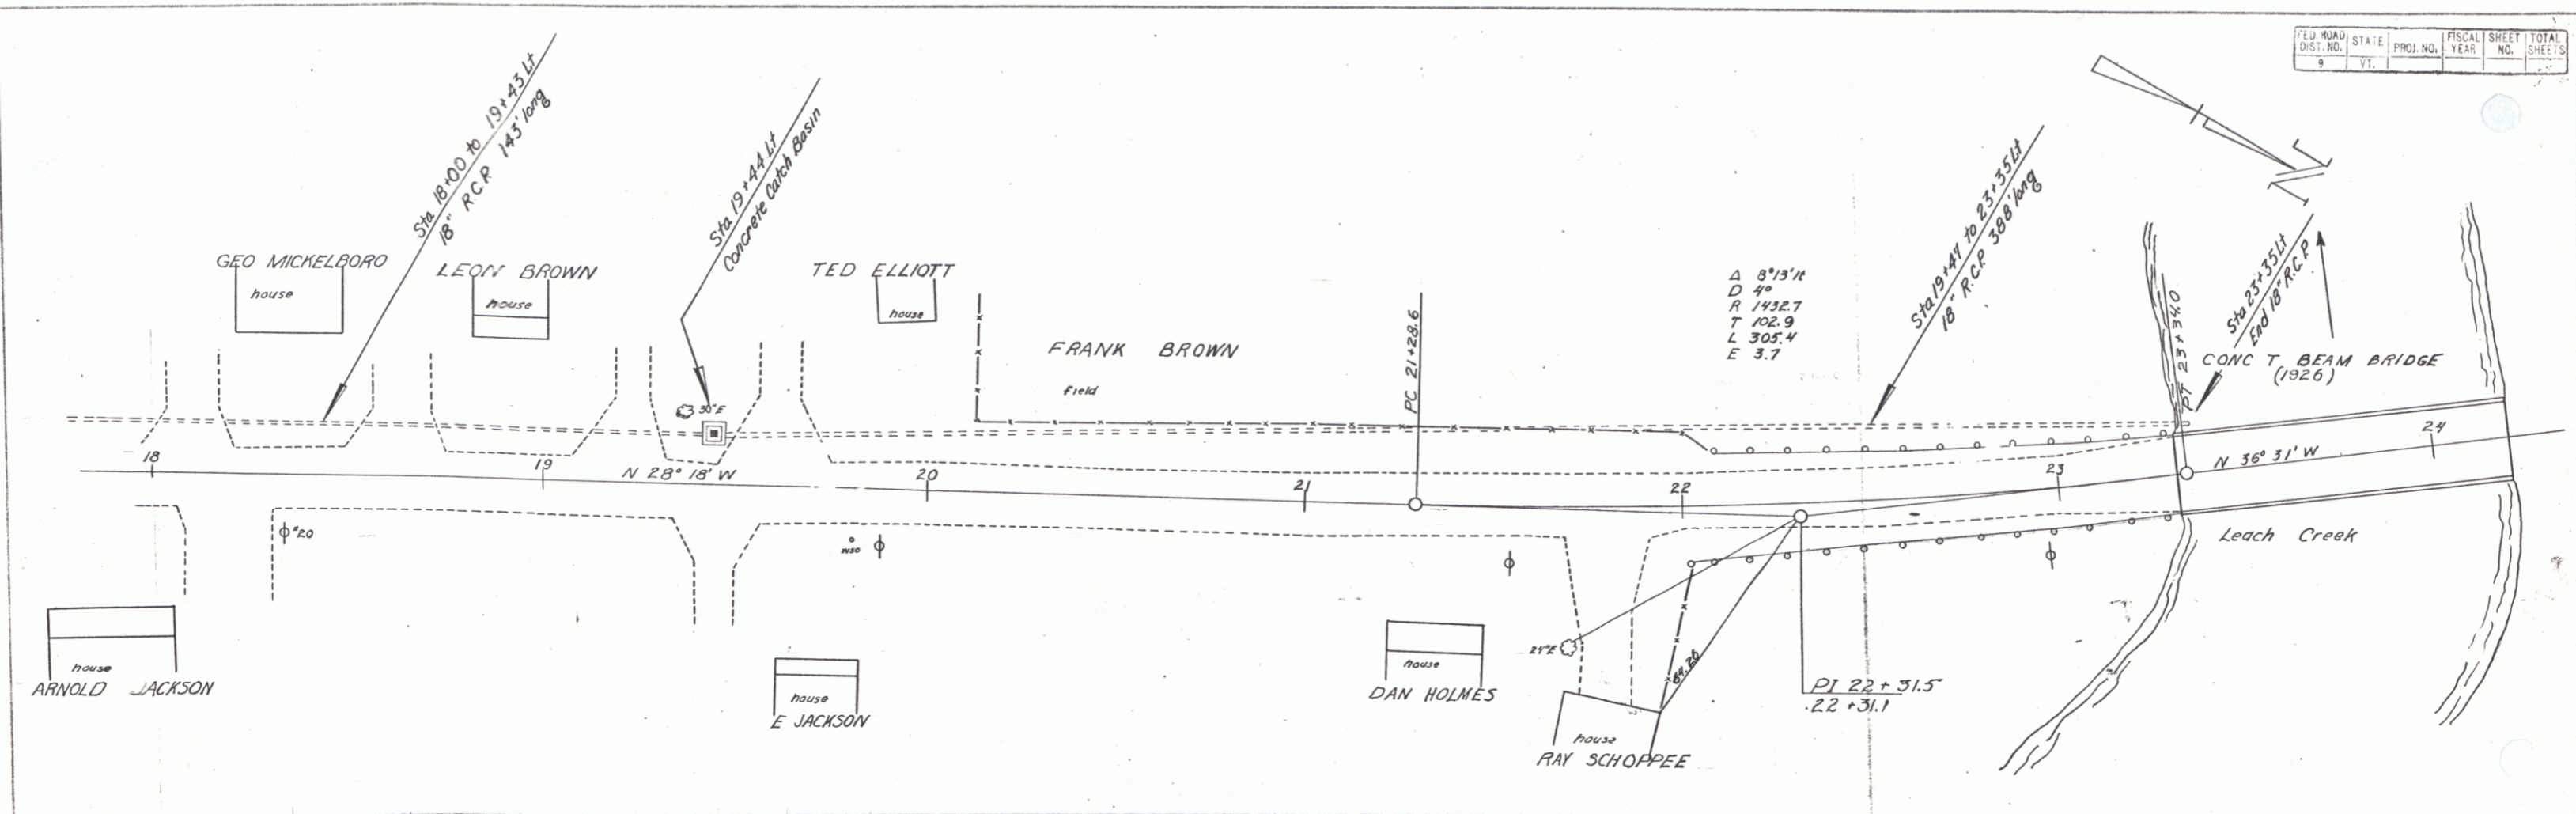


PLATE 1 - PLAN/PROFILE
 REYNOLDS & SMITH, INC., NEW YORK
 11/4/66

CANAAN
 Series State of
 No. 209-P
 Sheet 4