



POOR ORIGINAL COPY

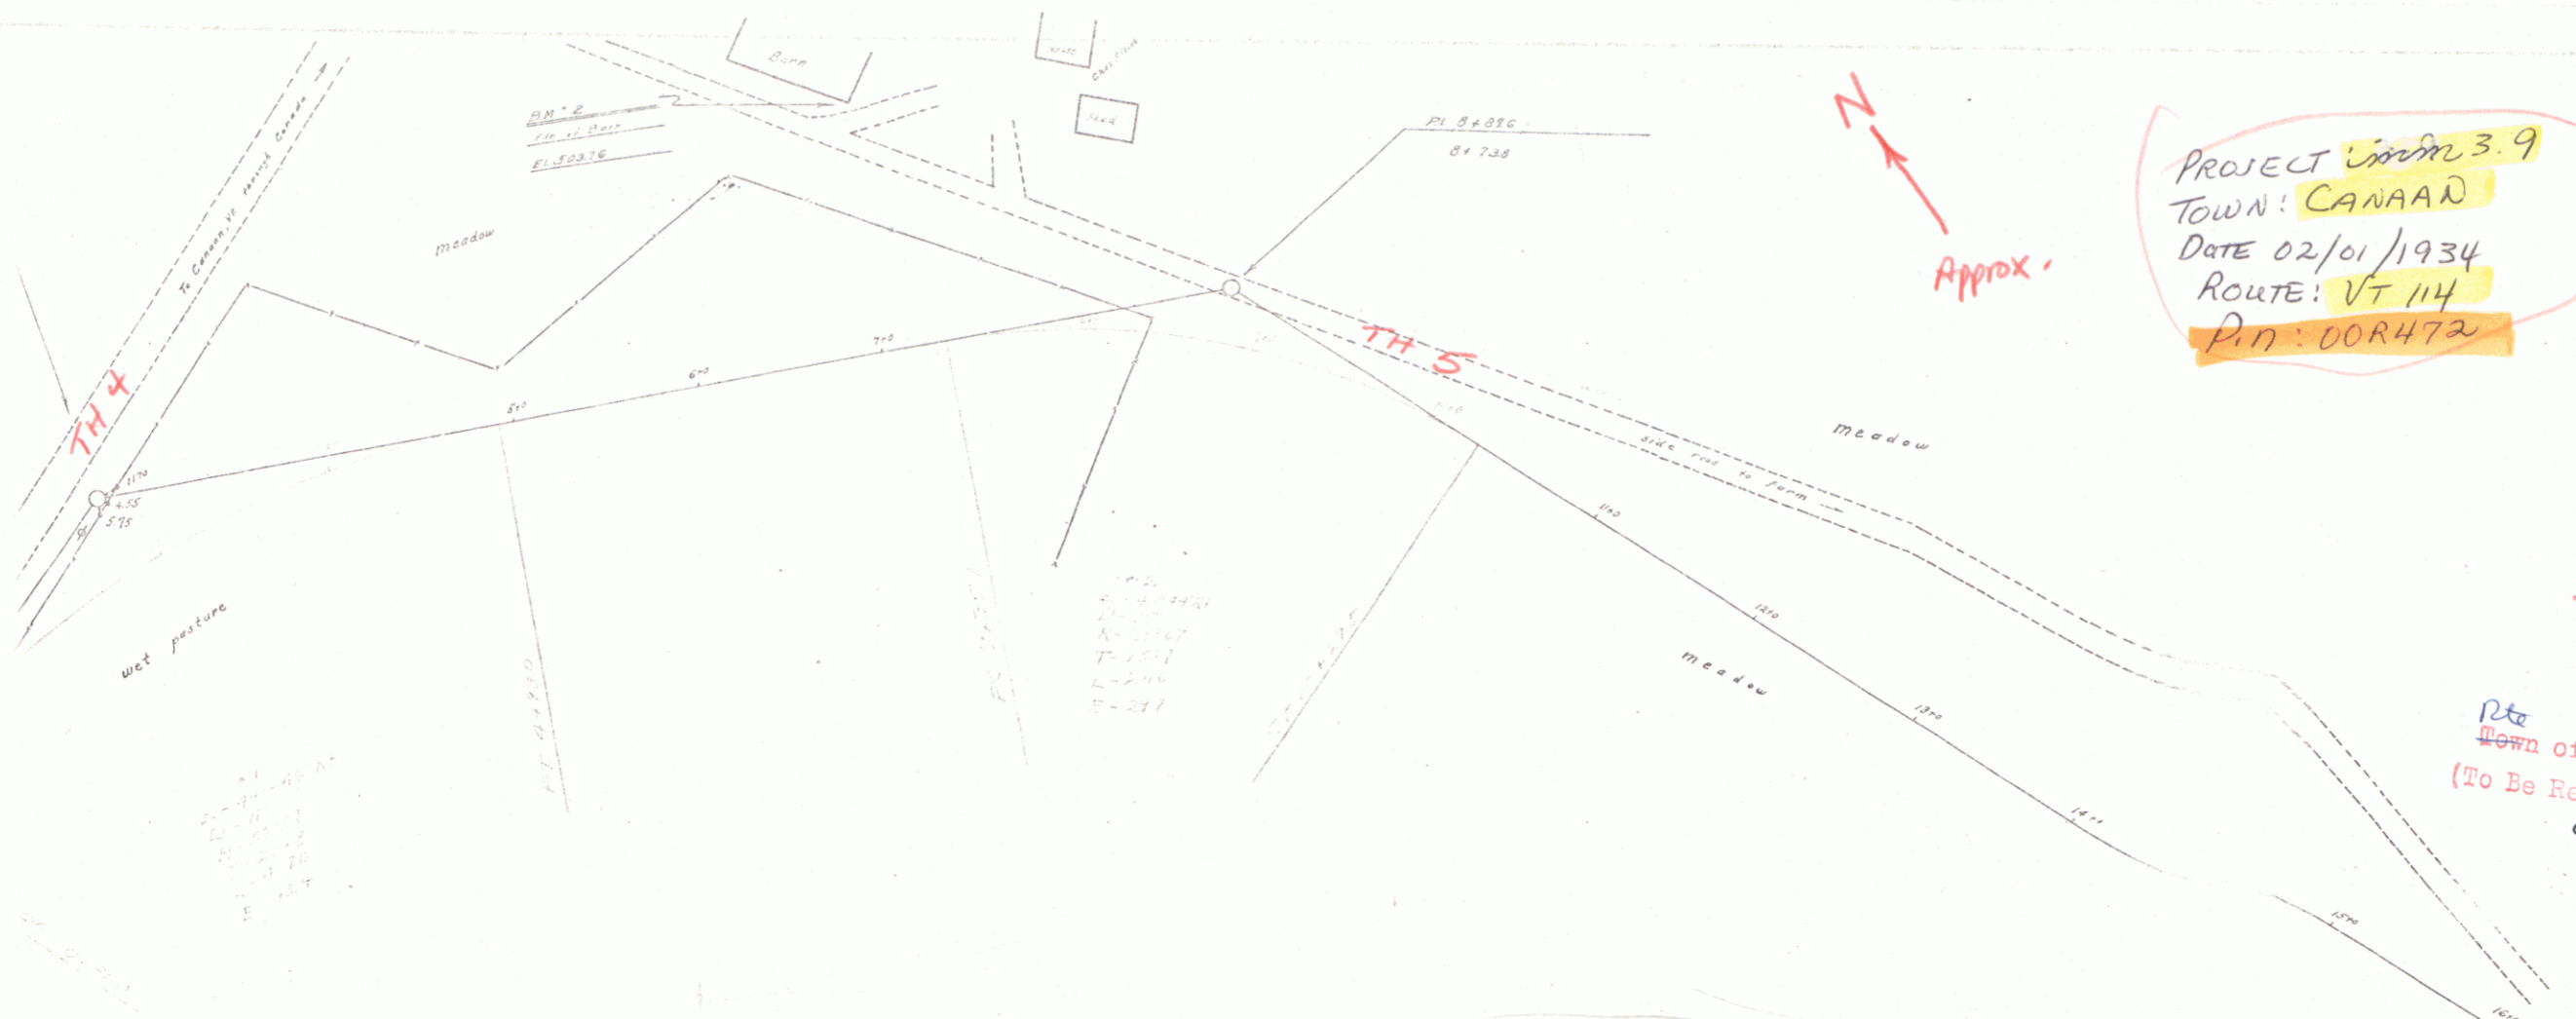

MP: 4.06 - 7.14
 RIGHT-OF-WAY DIVISION
 TOWN FILE
 PERPETUAL
 Town of VT 114
 (To Be Returned To R.O.W. Division)
 OLD ALIGNMENT

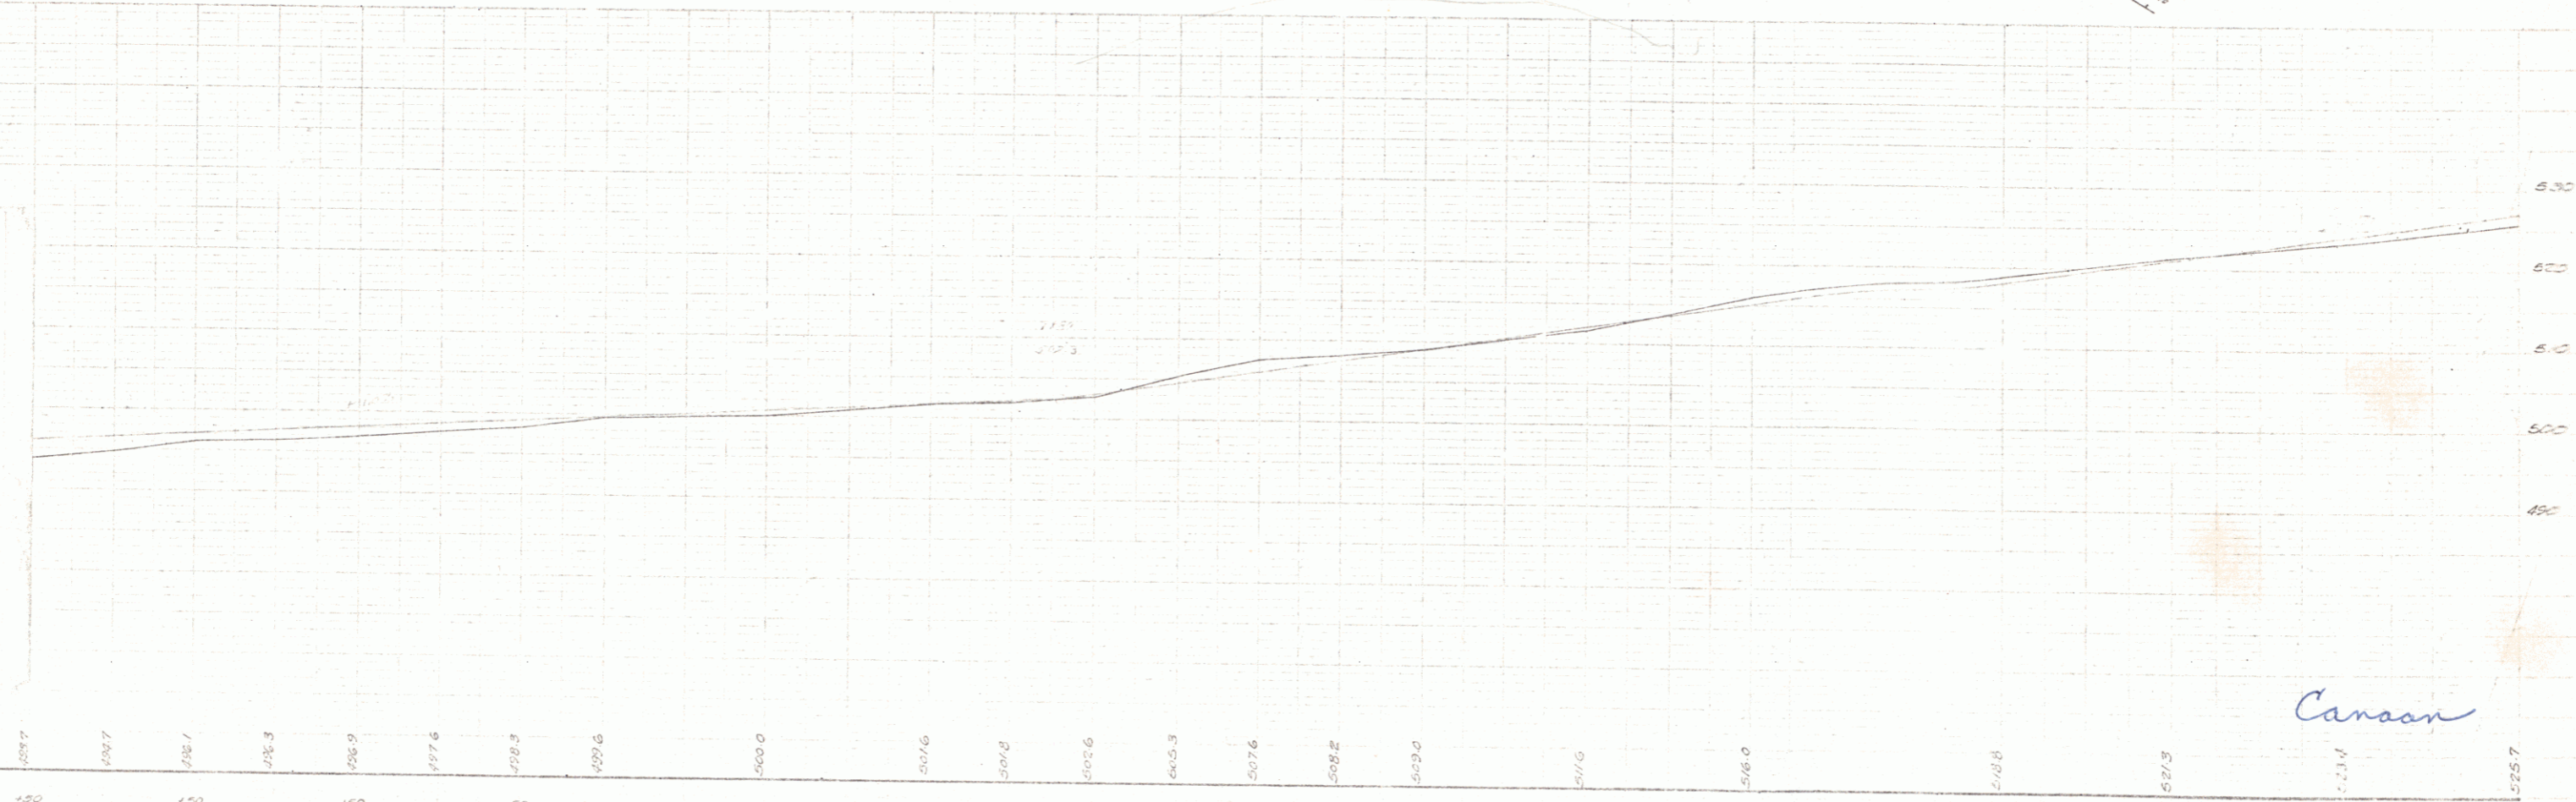

1+50 2+50 3+50 4+50 5+50 6+50 7+50 8+50 9+50 10+50 11+50 12+50 13+50 14+50 15+50
 DIST # 9 PLANS SHEET 1