



PLAN	PROPOSED	EXISTING	REMARKS
136	136	136	
137	137	137	
138	138	138	
139	139	139	
140	140	140	
141	141	141	
142	142	142	
143	143	143	
144	144	144	
145	145	145	
146	146	146	
147	147	147	
148	148	148	
149	149	149	
150	150	150	

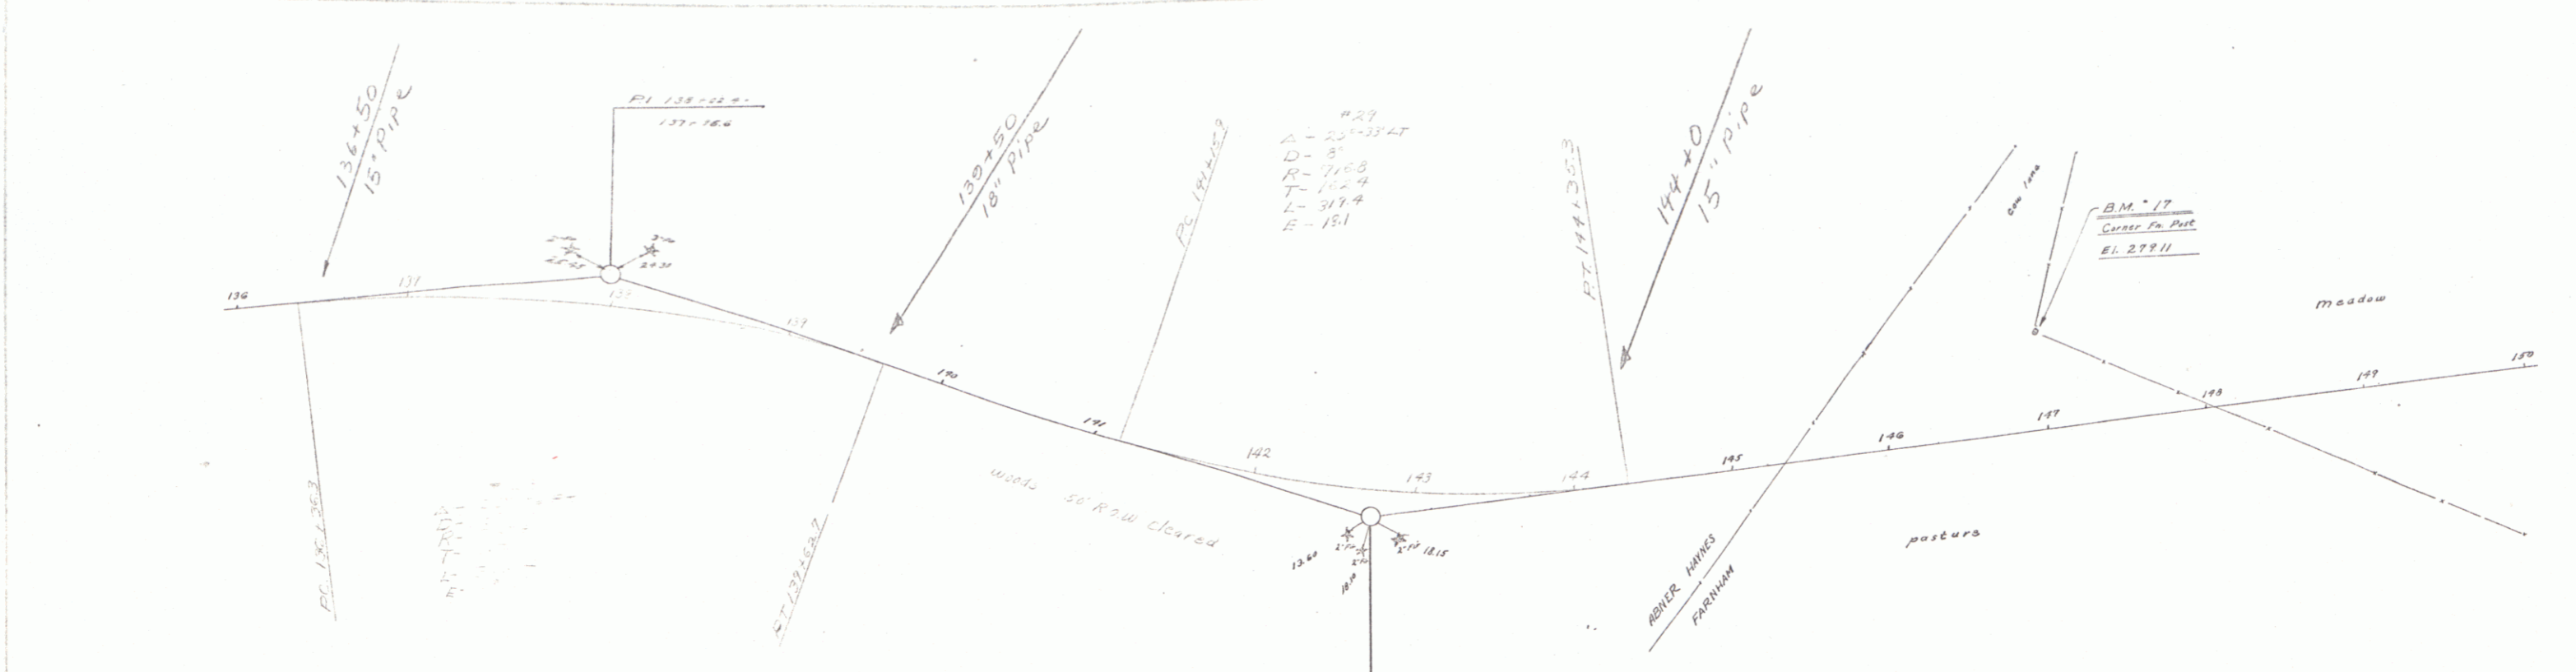

#27
 A - 25'-33.47
 D - 5'
 R - 715.8
 T - 152.4
 L - 379.4
 E - 18.1

B.M. #17
 Corner on Post
 EL. 279.11

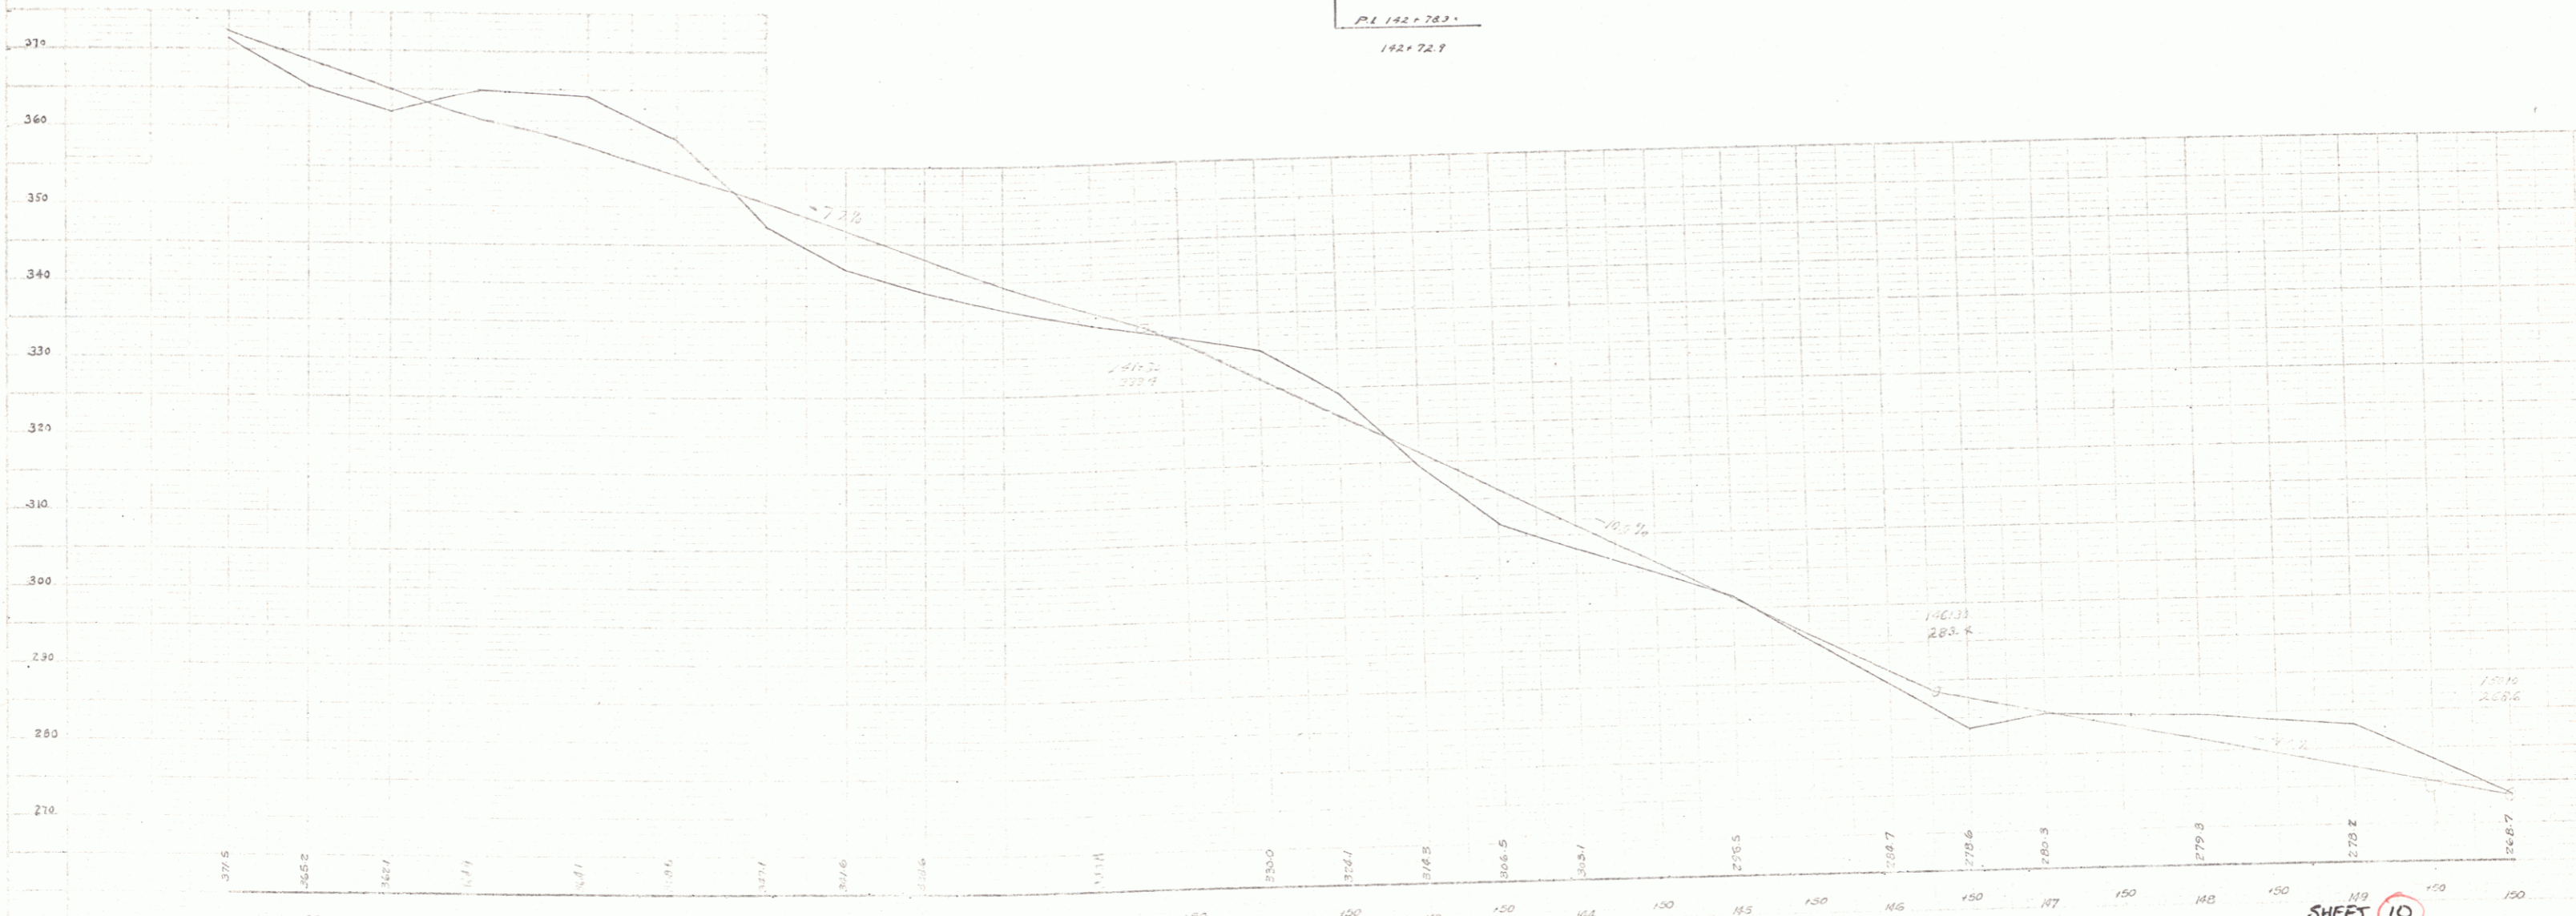

B.M. #7 SHIRE COR. POST LT 20 371 147+0 EL. 279.11

SHEET 10

10