

Lane
17' Propy

720
710
700


STA. 0+19.5
BEGINNING OF PROJECT
STATE 188 M

2+00
300' VC.
703.60

5+75
300' VC.
713.90
2+40 Rt - 8+73 Lt Sta

0+19.5 - 1+75
8' Sub-base of Gravel
Transition in
Depth of Sub-
base

1+75 - 10+00
12' Sub-base of Gravel

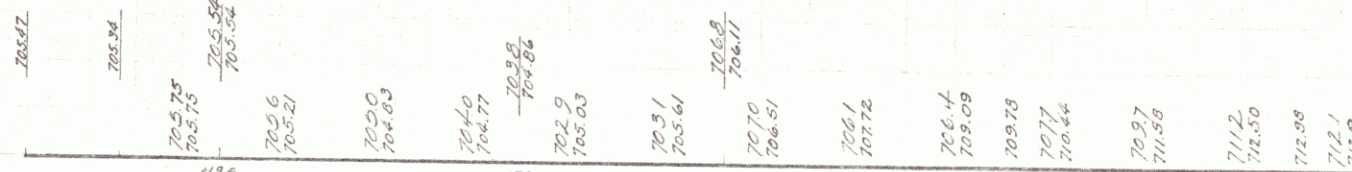

Station	Elevation
0+00	705.75
0+25	705.54
0+50	705.21
0+75	704.86
1+00	704.03
1+25	703.03
1+50	703.61
1+75	704.11
2+00	706.11
2+25	707.72
2+50	709.09
2+75	709.78
3+00	710.44
3+25	711.55
3+50	712.11
3+75	712.50
4+00	712.88
4+25	713.19
4+50	713.33
4+75	713.44
5+00	713.50
5+25	713.55
5+50	713.60
5+75	713.65
6+00	713.70
6+25	713.75
6+50	713.80
6+75	713.85
7+00	713.90

B.M. #1 Spot on Conc. Bridge Wing 13' Lt. Sta. 4+48+04 El. 709.26
B.M. #2 S.I.R. 42' Elm 10.5' Rt. Sta 4+99 El. 710.33