
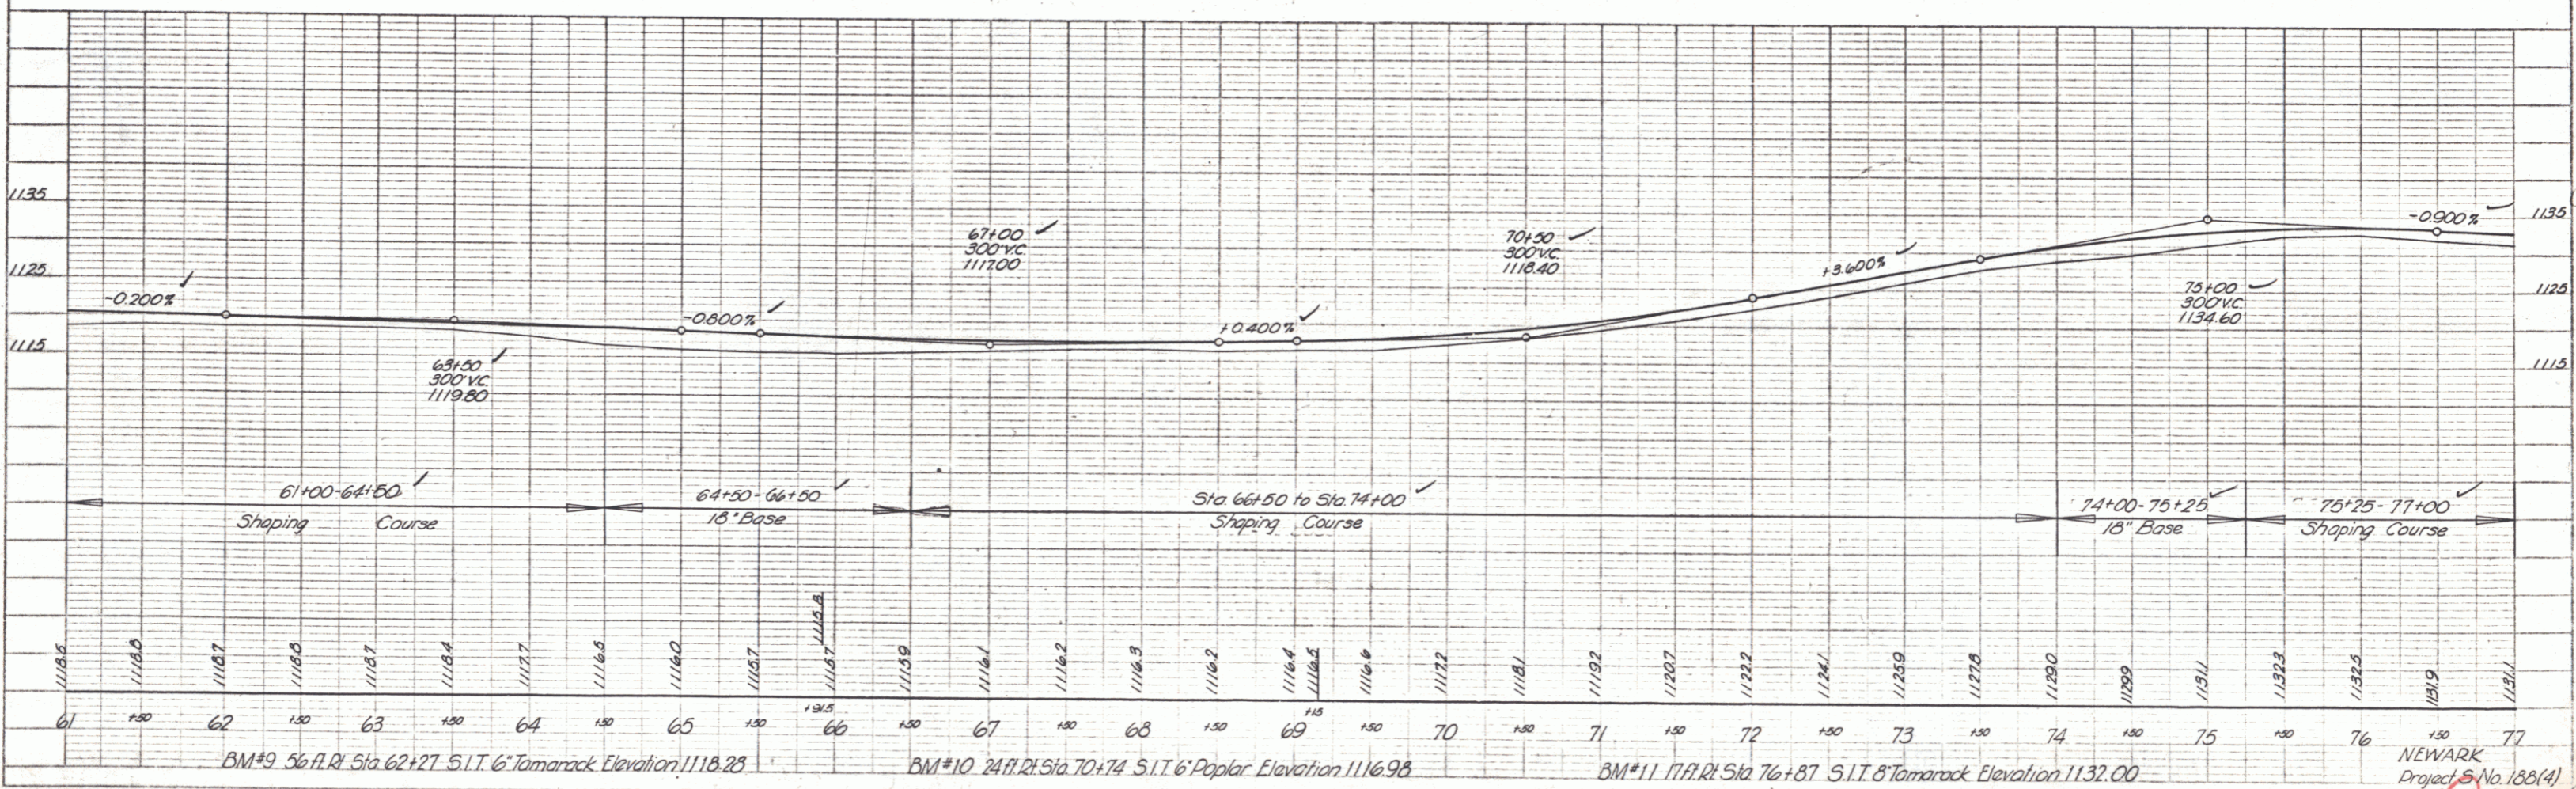


PLAN
 DATE: 9-30
 DRAWN BY: ALDRIN
 CHECKED BY: HURLEY
 PROJECT NO.: 185(4)
 SHEET NO.: 46

PROFILE
 DATE: 9-30
 DRAWN BY: ALDRIN
 CHECKED BY: HURLEY
 PROJECT NO.: 185(4)
 SHEET NO.: 46

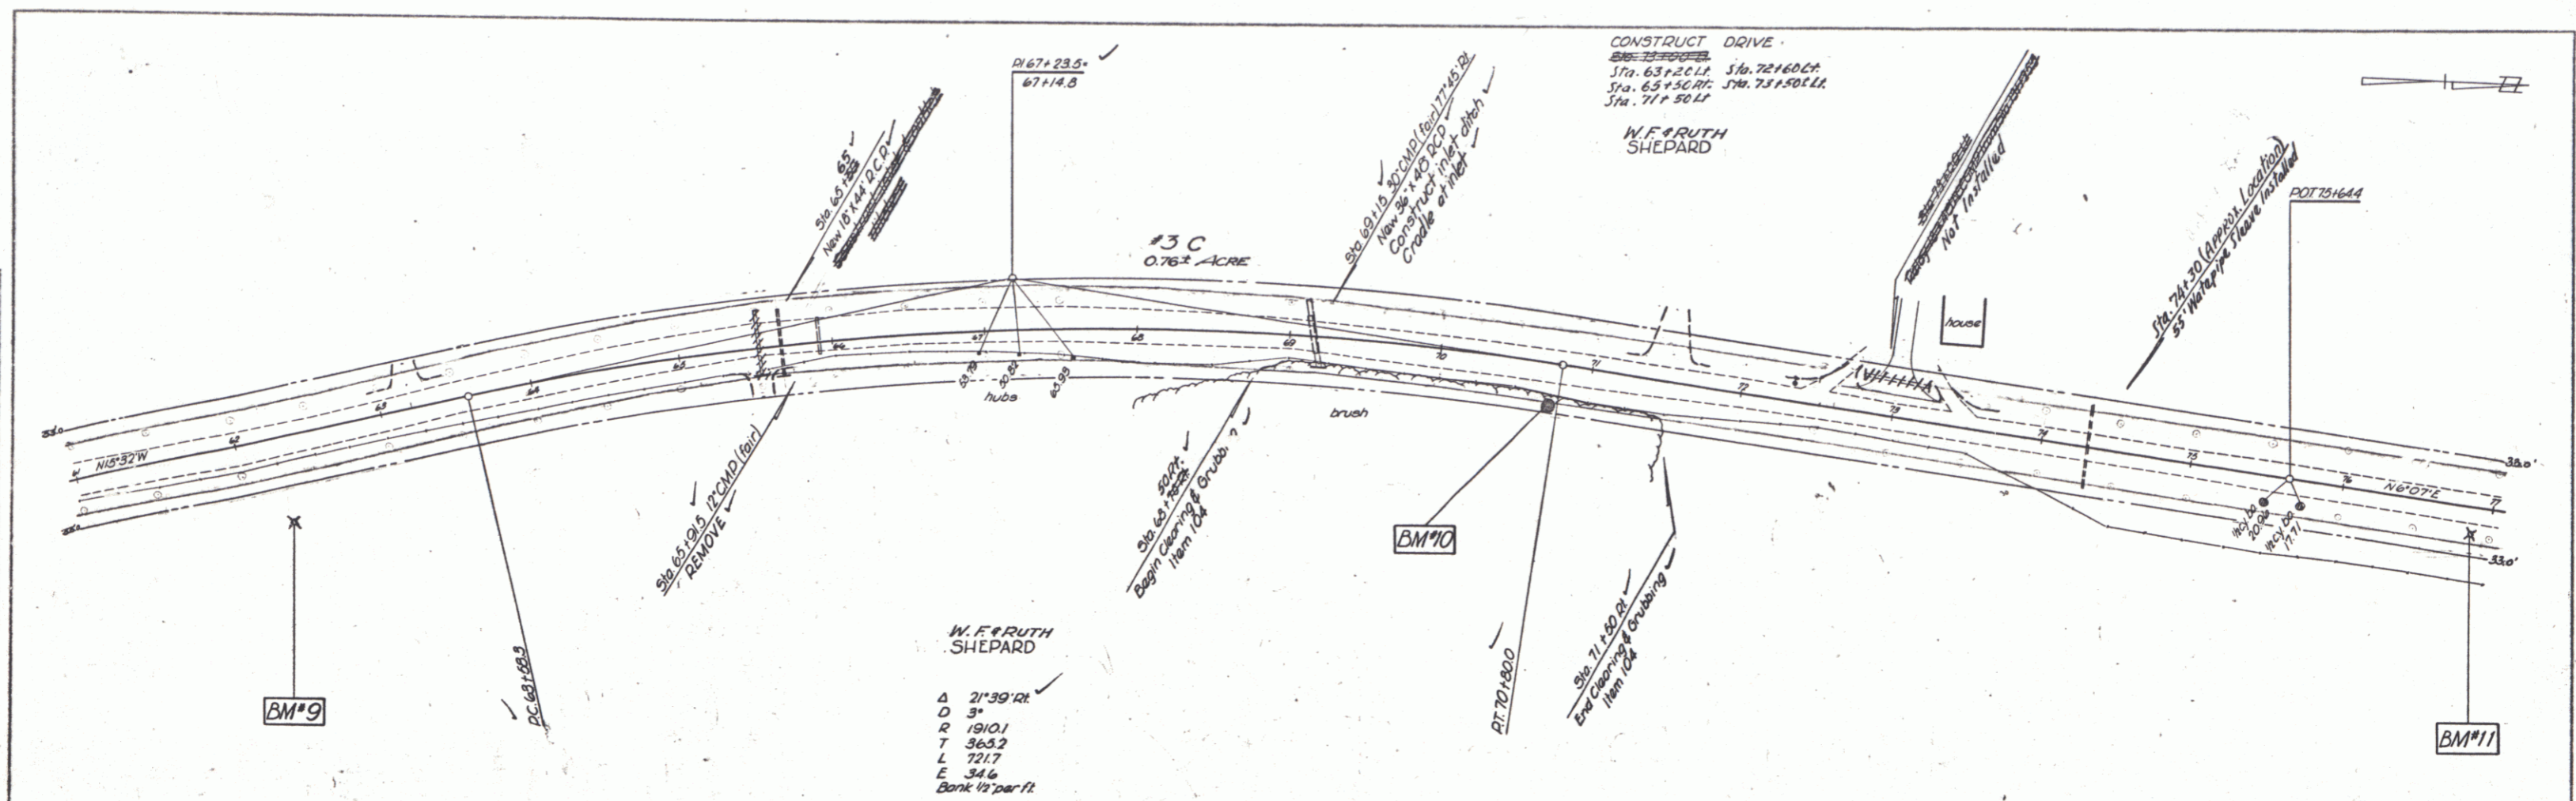

NEWARK
 Project No. 185(4)
 Sheet 46 of 46