
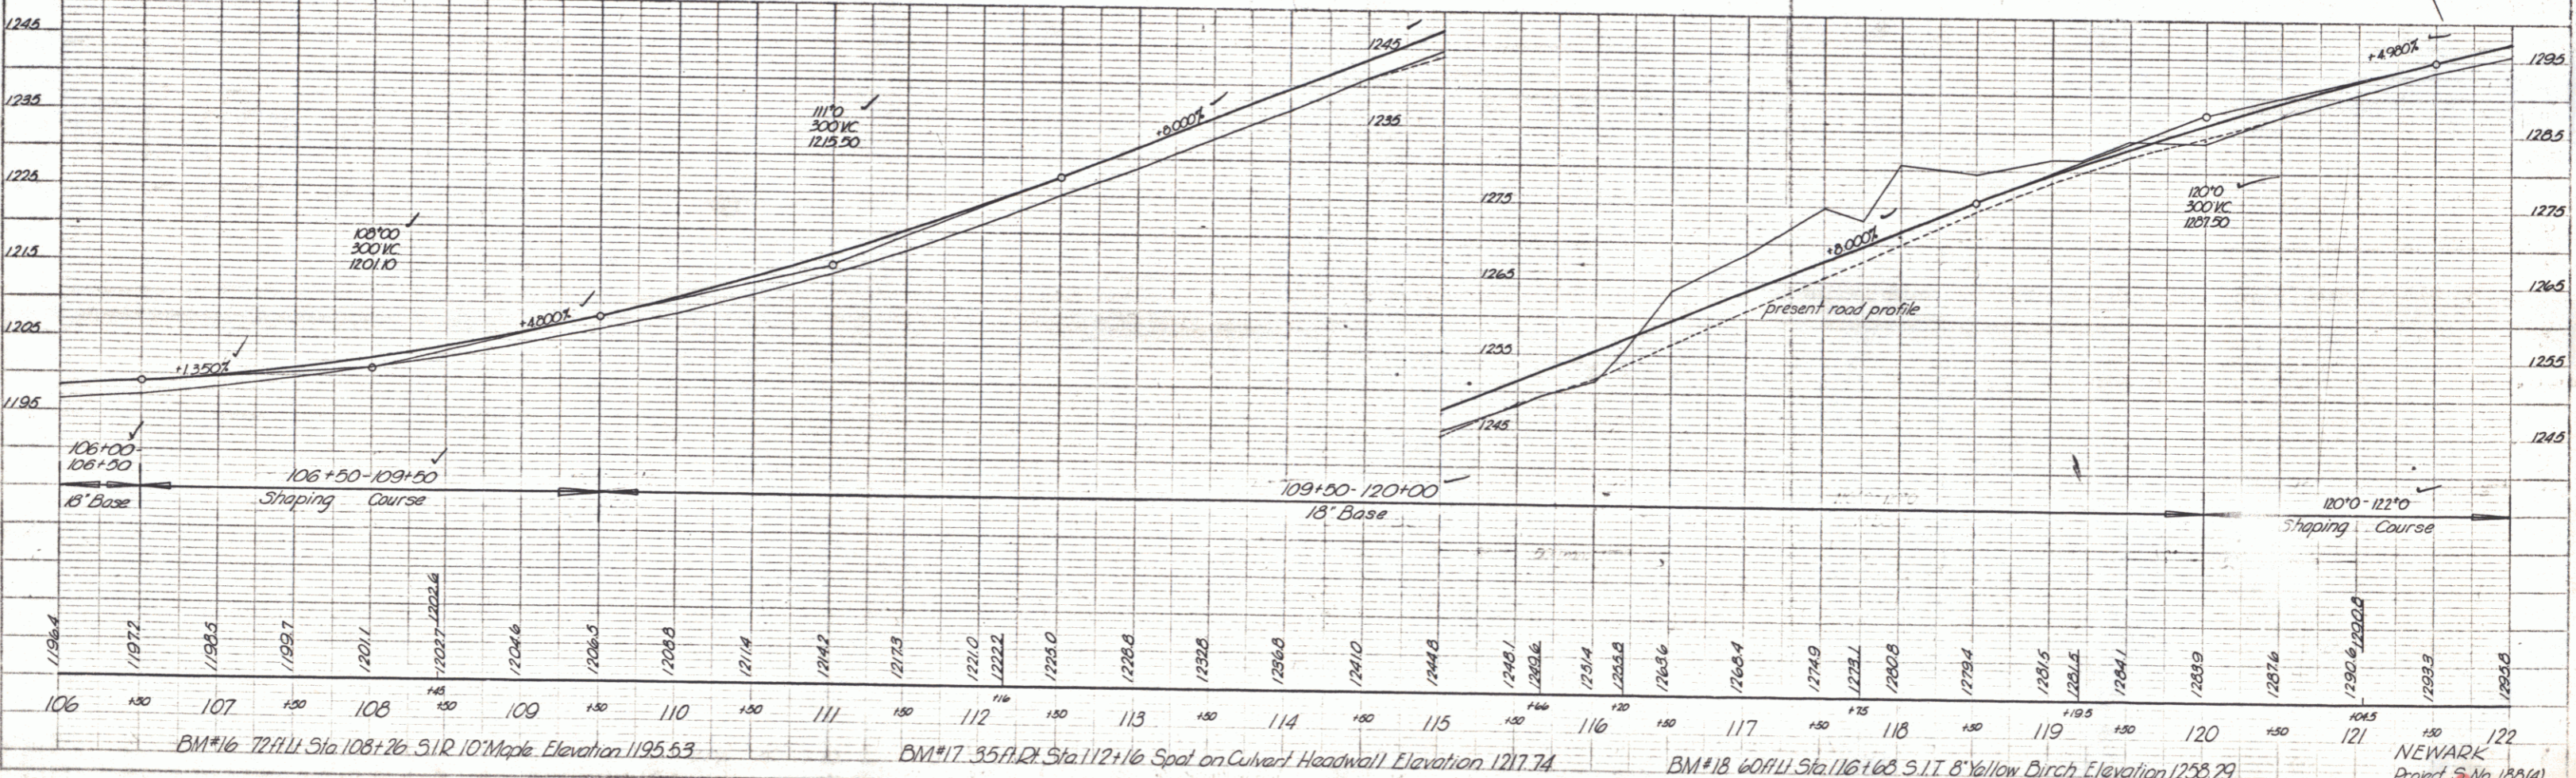


PLAN
 DATE: 12-30-50
 DRAWN BY: A. L. ...
 CHECKED BY: ...
 NO. 147-109

PROFILE
 DATE: 12-30-50
 DRAWN BY: A. L. ...
 CHECKED BY: ...
 NO. 147-109

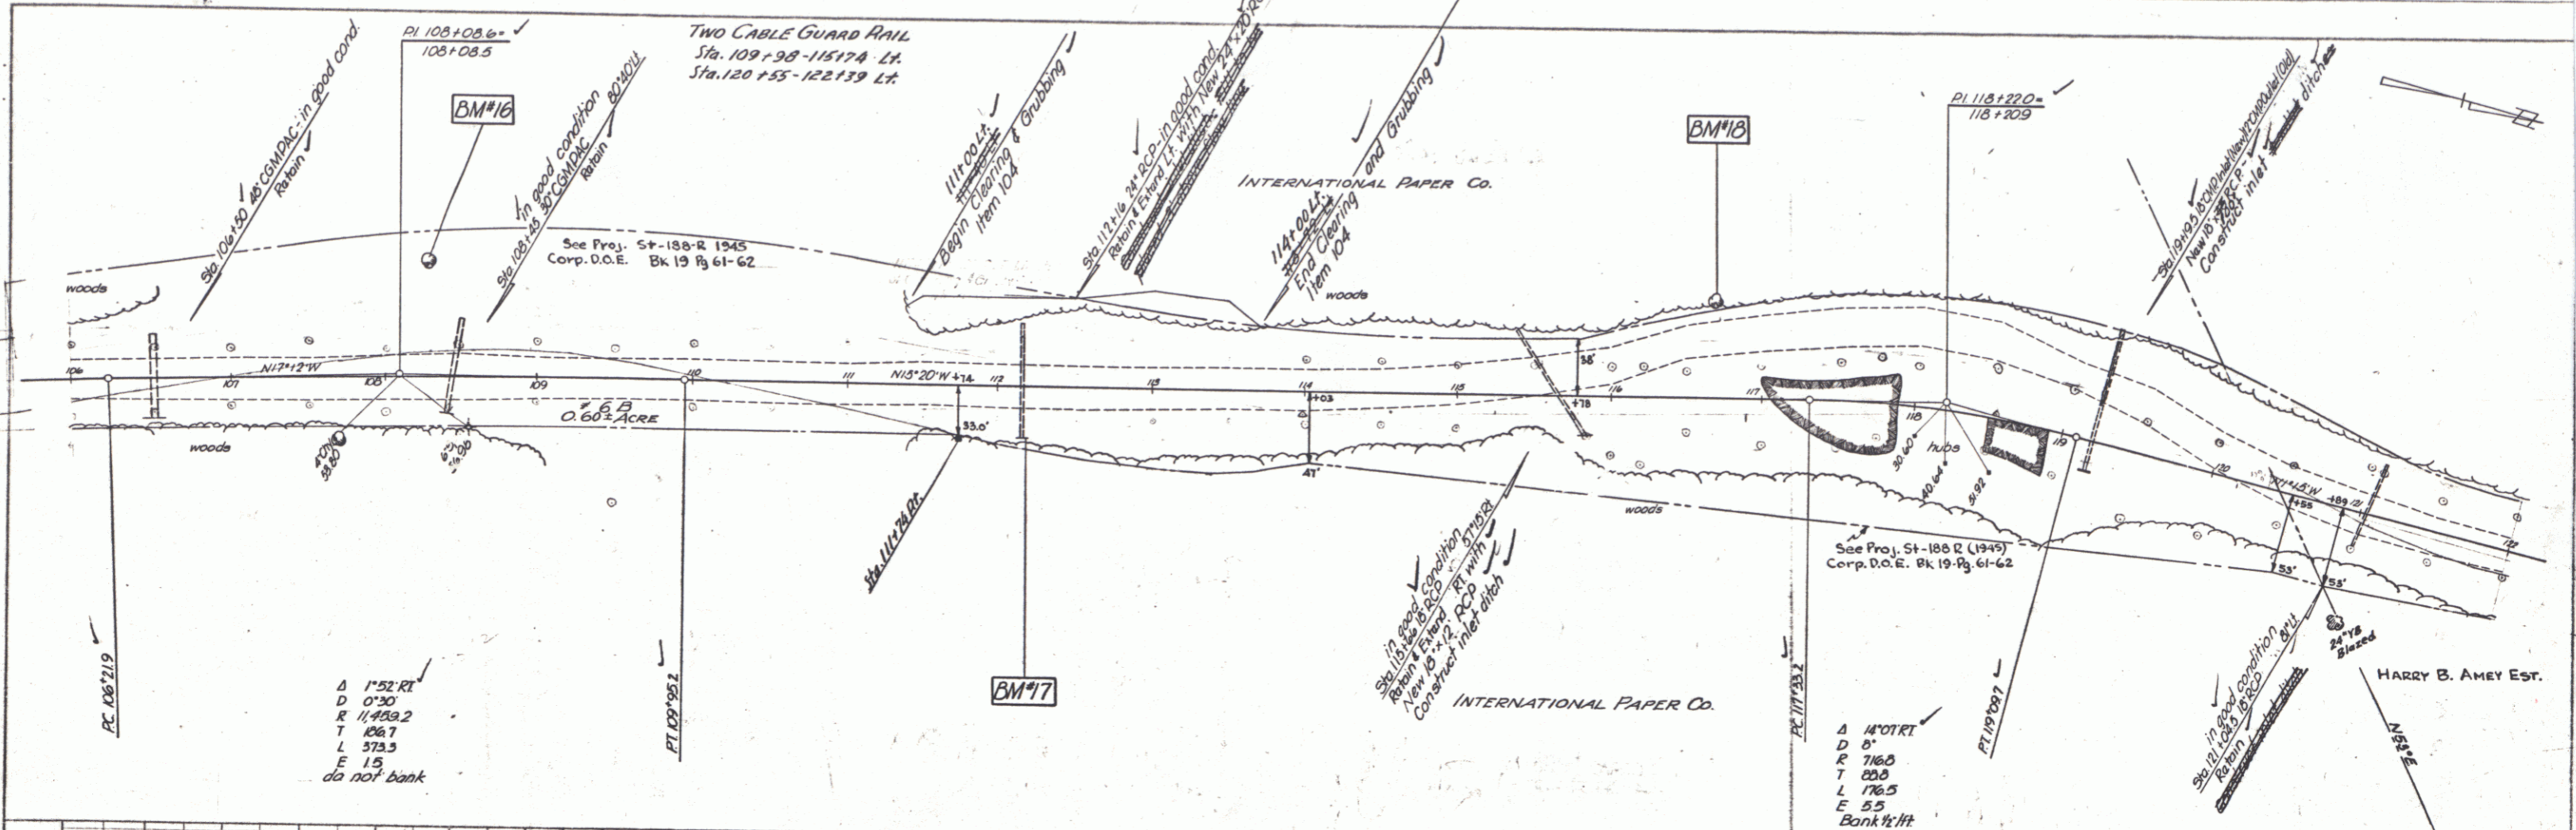

NEWARK
 Project No. 188(4)
 Sheet 11 of 46