


PLAN
 DATE 2-48
 DRAWN BY G. Houghton
 CHECKED BY
 SCALE 1" = 40'

PROFILE
 DATE 2-48
 DRAWN BY Houghton
 CHECKED BY
 SCALE 1" = 40'

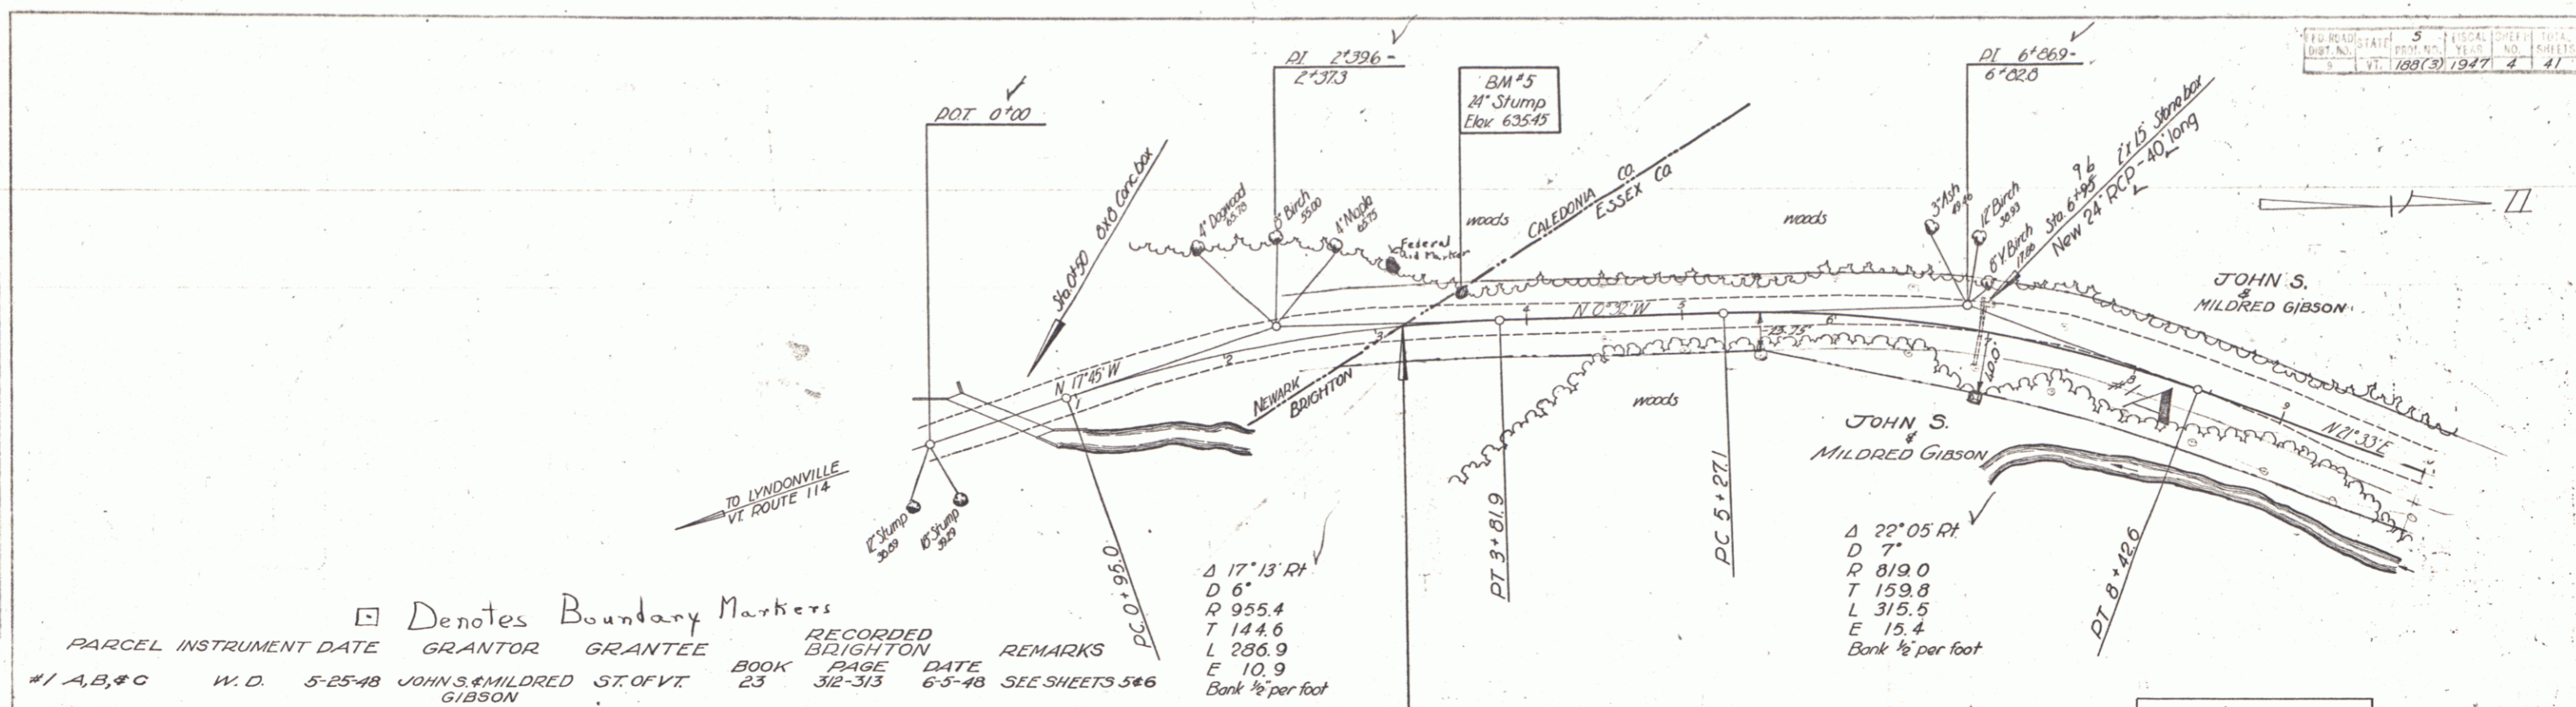

□ Denotes Boundary Markers

PARCEL	INSTRUMENT	DATE	GRANTOR	GRANTEE	RECORDED BRIGHTON	REMARKS
#					BOOK PAGE DATE	
#1 A, B, C	W.D.	5-25-48	JOHN S. & MILDRED GIBSON	ST. OF VT.	BOOK 23 PAGE 312-313 DATE 6-5-48	SEE SHEETS 5 & 6

Sta	Sta	Per
4+50	5+75	14'
4+72	6+67	RT
7+26	7+95	RT
8+10	9+82	12'

