



PLAN  
 SCALE 1" = 40'  
 DATE 7-48  
 DRAWN BY G. Houghton

PROFILE  
 SCALE 1" = 20'  
 DATE 7-48  
 DRAWN BY G. Houghton

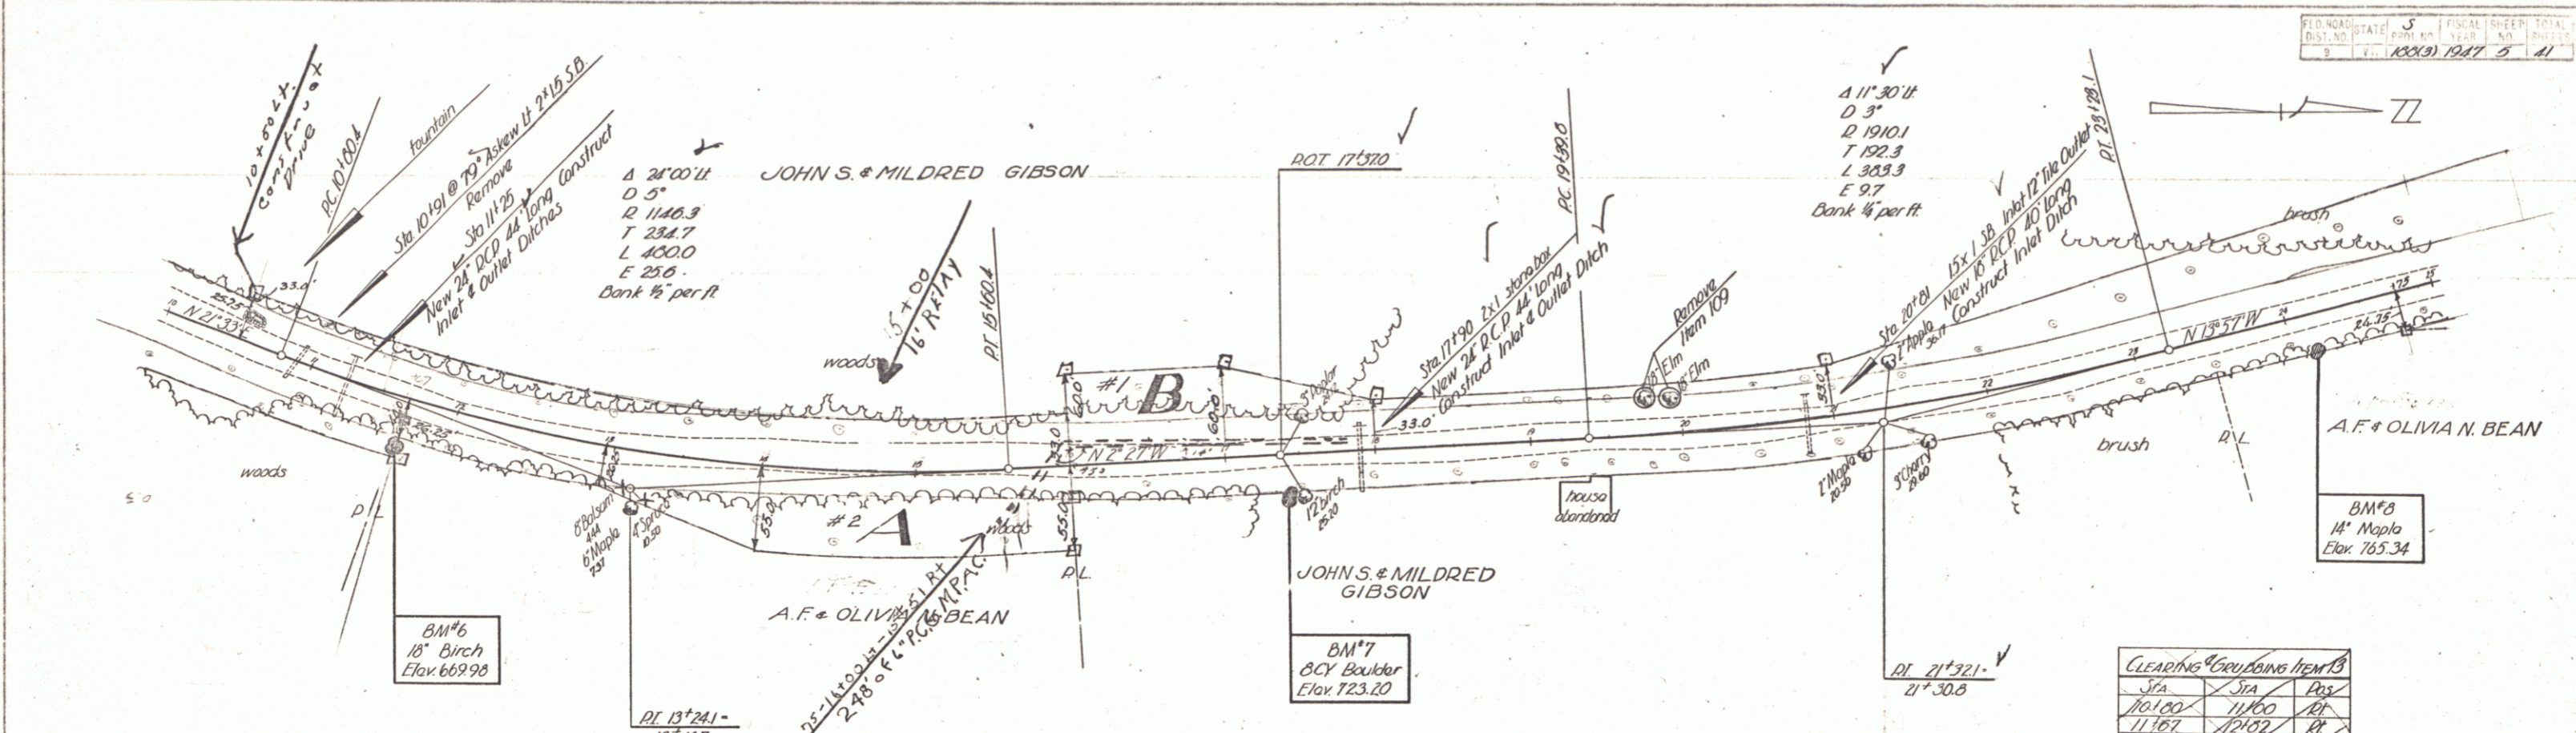

PARCEL	INSTRUMENT	DATE	GRANTOR	GRANTEE	RECORDED BRIGHTON BOOK	PAGE	DATE	REMARKS
#1 A,B,C	W.D.	5-25-48	JOHN S. & MILDRED GIBSON	ST. OF VT.	25	312-313	6-5-48	SEE SHEETS 4&6
#2 A,B,C,D,E	W.D.	5-25-48	A.F. & OLIVIA N. BEAN	ST. OF VT.	23	305-306	6-5-48	SEE SHEETS 6&7

CLEARING	CRUISING	ITEMS
101.00	11.00	10
11.67	12.00	10
13.20	10.00	10
16.30	11.00	11
16.67	11.17	10
23.90	20.00	11

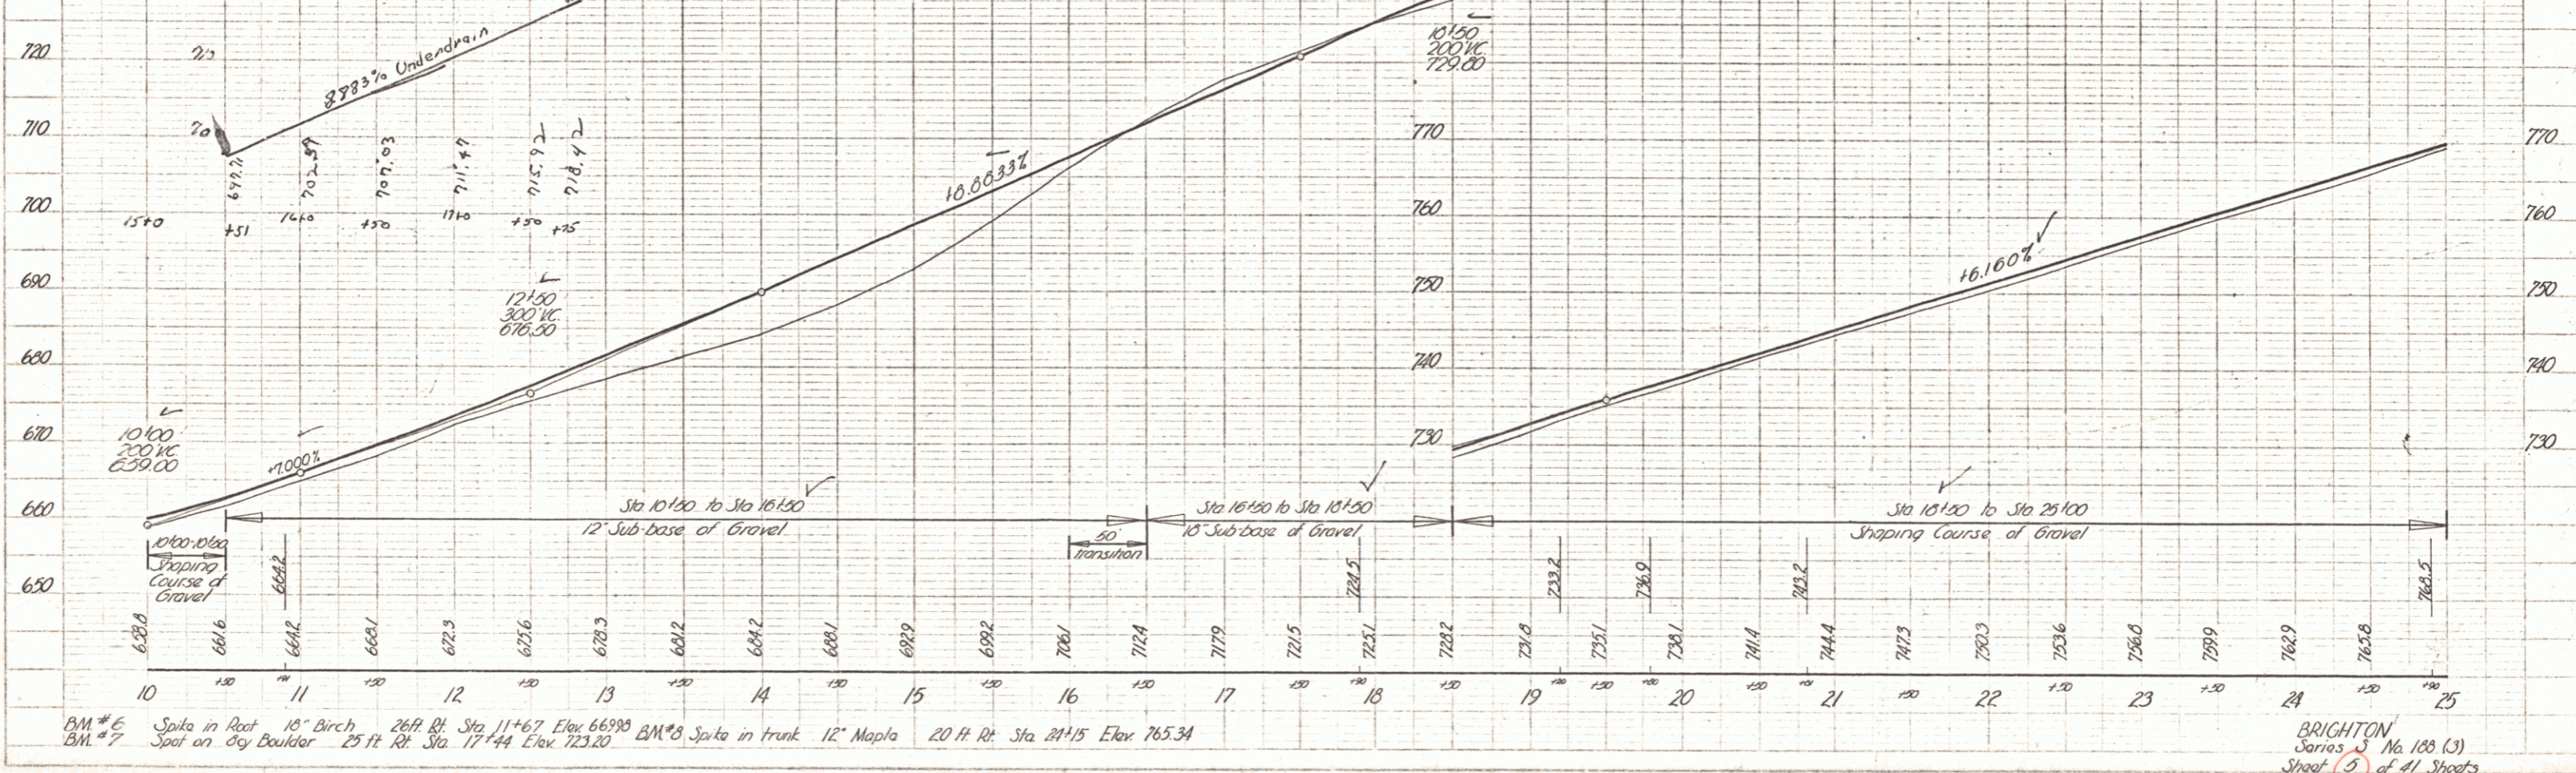

BM #6 Spike in Root 18" Birch 26 ft Rt. Sta. 11+67 Elev. 668.98  
 BM #7 Spot on Coy Boulder 25 ft Rt. Sta. 17+44 Elev. 723.20  
 BM #8 Spike in trunk 12" Maple 20 ft Rt. Sta. 24+15 Elev. 765.34