


PARCEL INSTRUMENT DATE GRANTOR GRANTEE RECORDED BRIGHTON REMARKS  
 #2 A,B,C,D,E W.D. 5-25-48 A.F. & OLIVIA N. BEAN ST. OF VT. BOOK PAGE DATE SEE SHEETS 5 & 7  
 23 305-306 6-5-48

Sta	Sta	Pos
25+00	27+00	LT
25+35	27+68	RT
28+28	28+80	RT
29+38	30+00	RT
30+22	30+78	RT
31+10	32+44	RT
31+50	34+25	LT
32+62	34+77	RT
36+28	37+13	RT

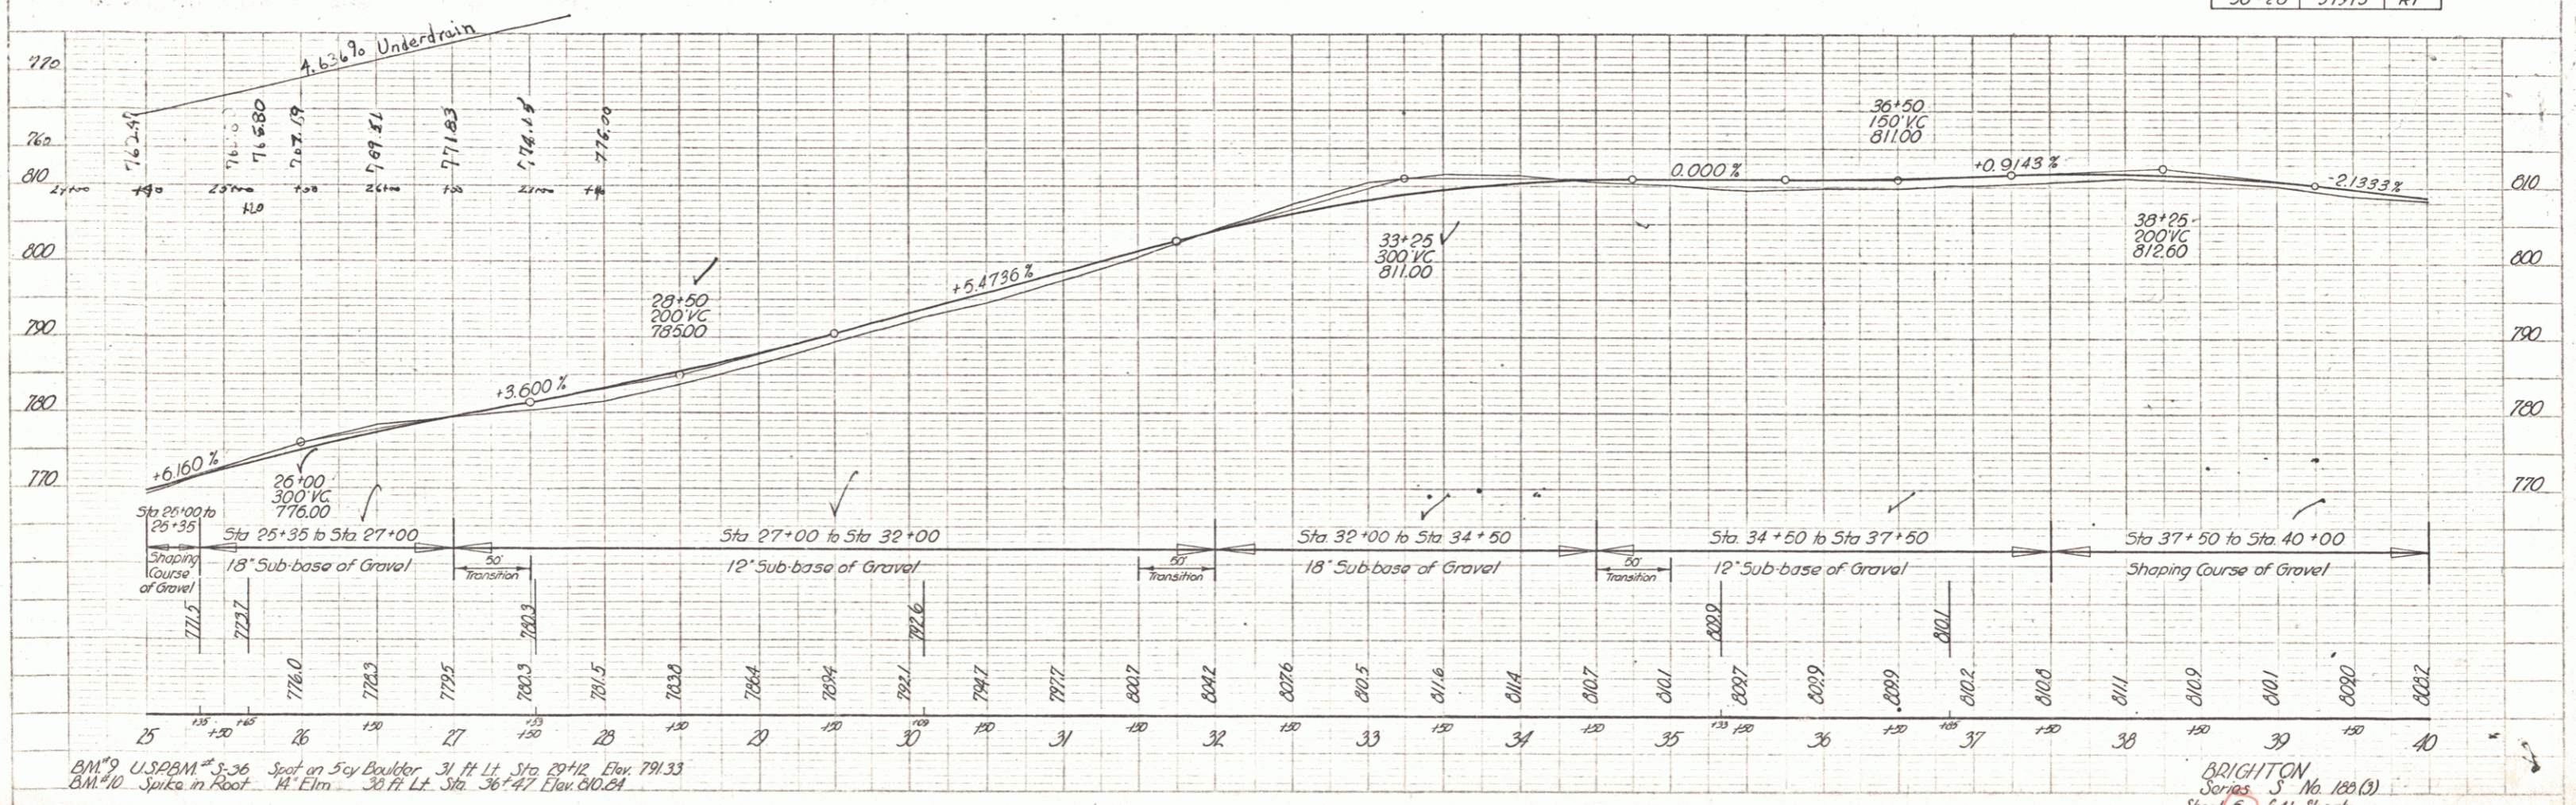

BM #9 U.S.P.M. #3-36 Spot on 5' Boulder 31 ft Lt. Sta 27+12 Elev 791.33  
 BM #10 Spike in Root 14' Elm 30 ft Lt. Sta 36+47 Elev 810.84

BRIGHTON  
 Series S No. 100(3)  
 Street 6 of 41 Streets