


PARCEL INSTRUMENT DATE GRANTOR GRANTEE RECORDED BRIGHTON BOOK PAGE DATE REMARKS
 #2 ABC'D'E W.D.O.E. 5-25-48 A.F. & OLIVIA N. BEAN STOFVT 23 305306 6-5-48 SEE SHEETS 5&6

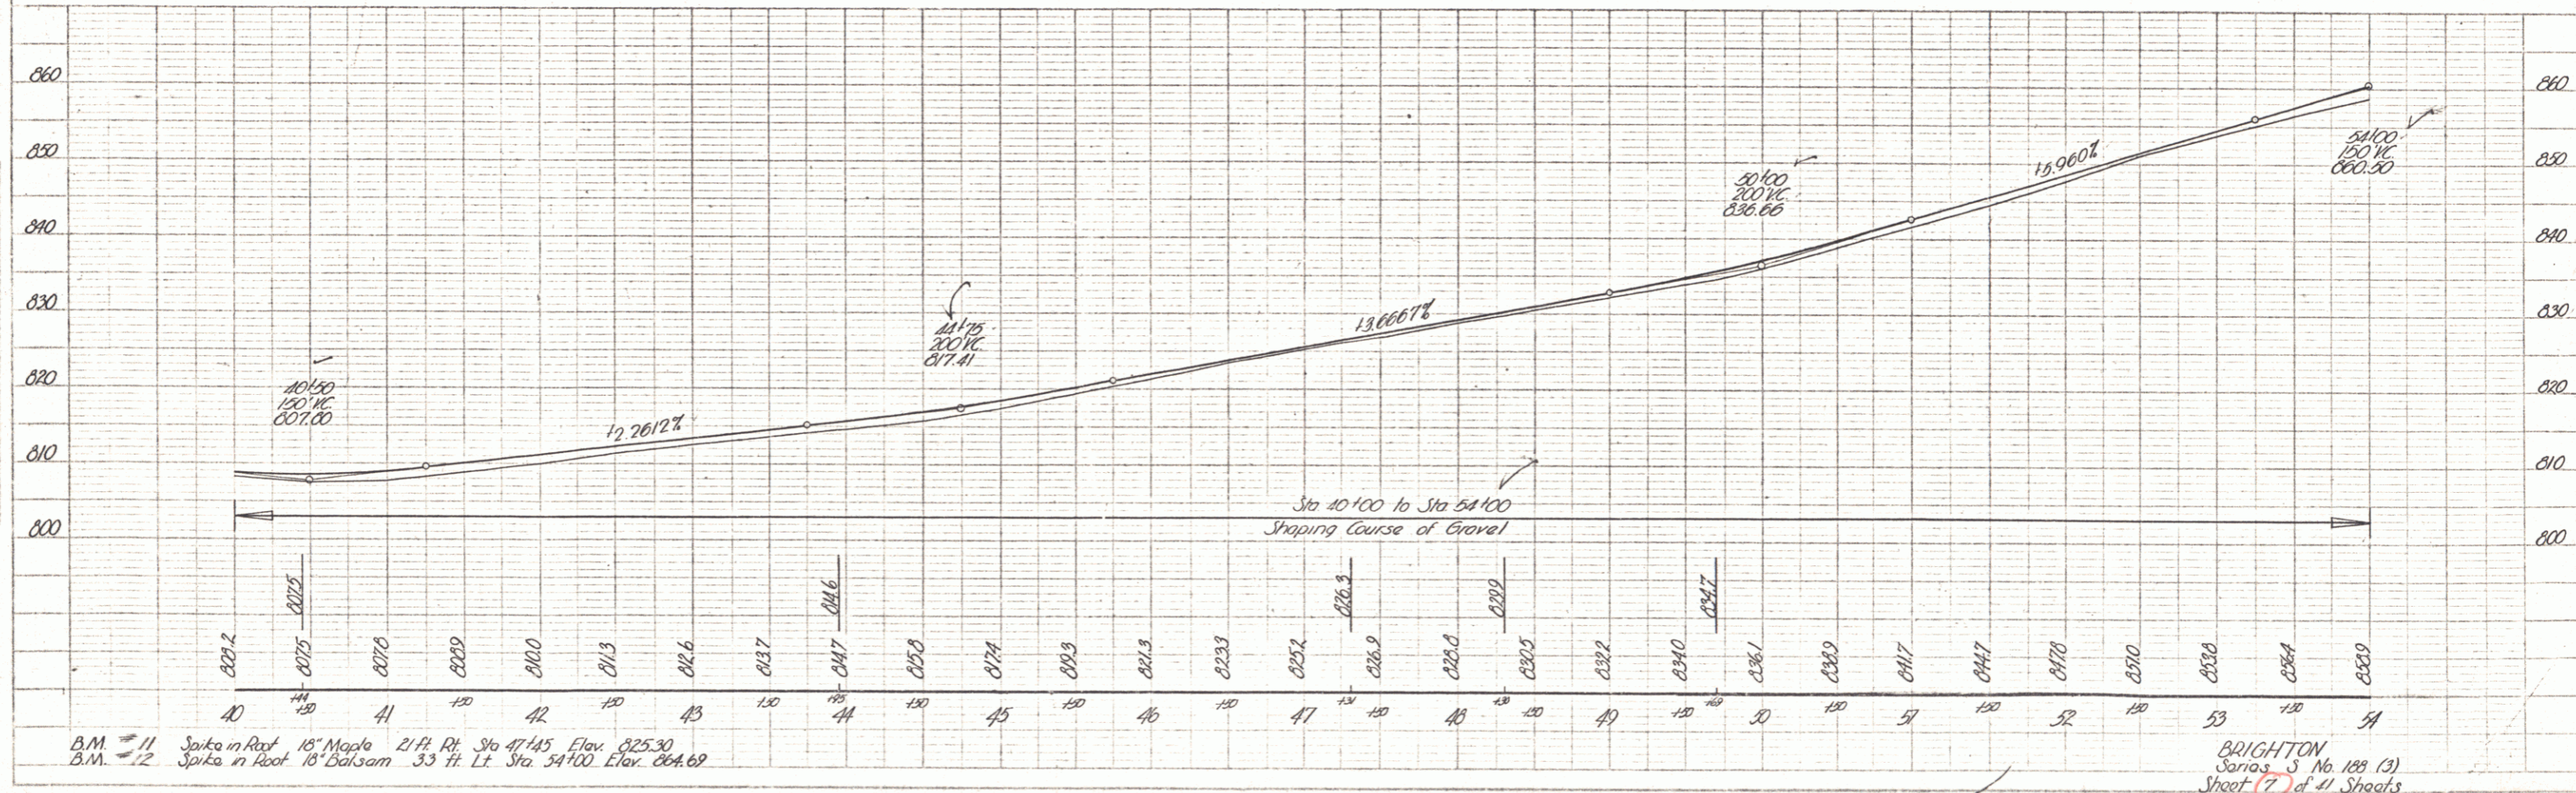

B.M. #11 Spike in Root 15' Maple 2 1/4" Ft. Sta 47+45 Elev. 825.30
 B.M. #12 Spike in Root 15' Balsam 3 3/4" Ft. Sta 54+100 Elev. 864.69

BRIGHTON
 Series S No. 189 (3)
 Sheet 7 of 41 Sheets